




SECOND FLOOR PLAN
SCALE 1/4" = 1'-0"

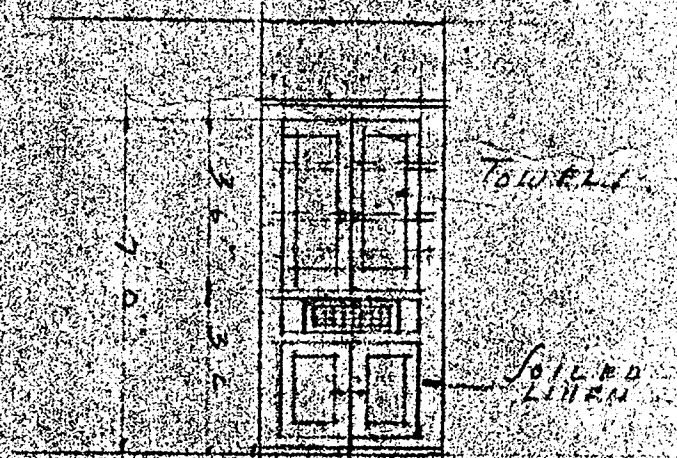


TOWEL CLOSET WITH R.M.

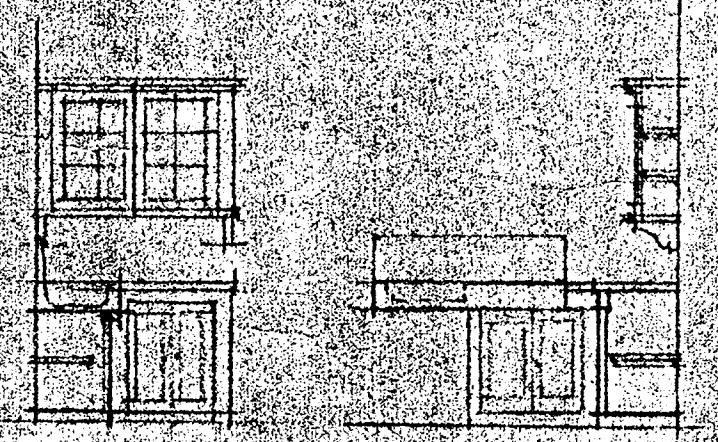

CHINA CABINET KITCHEN
SCALE 1/4" = 1'-0"

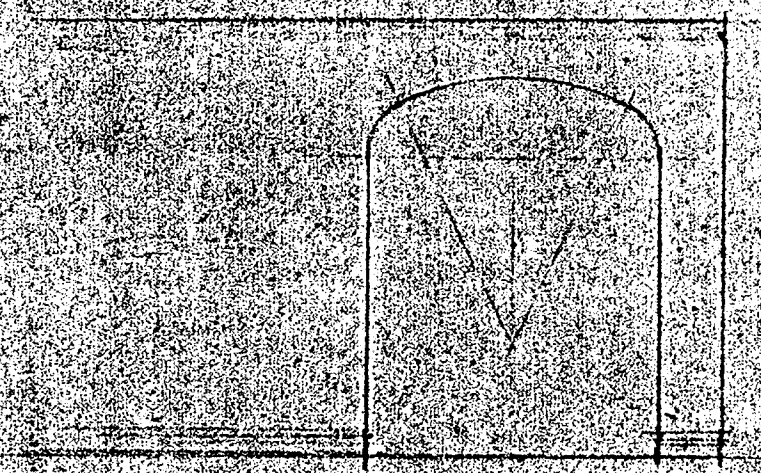

DETAIL OF ARCH

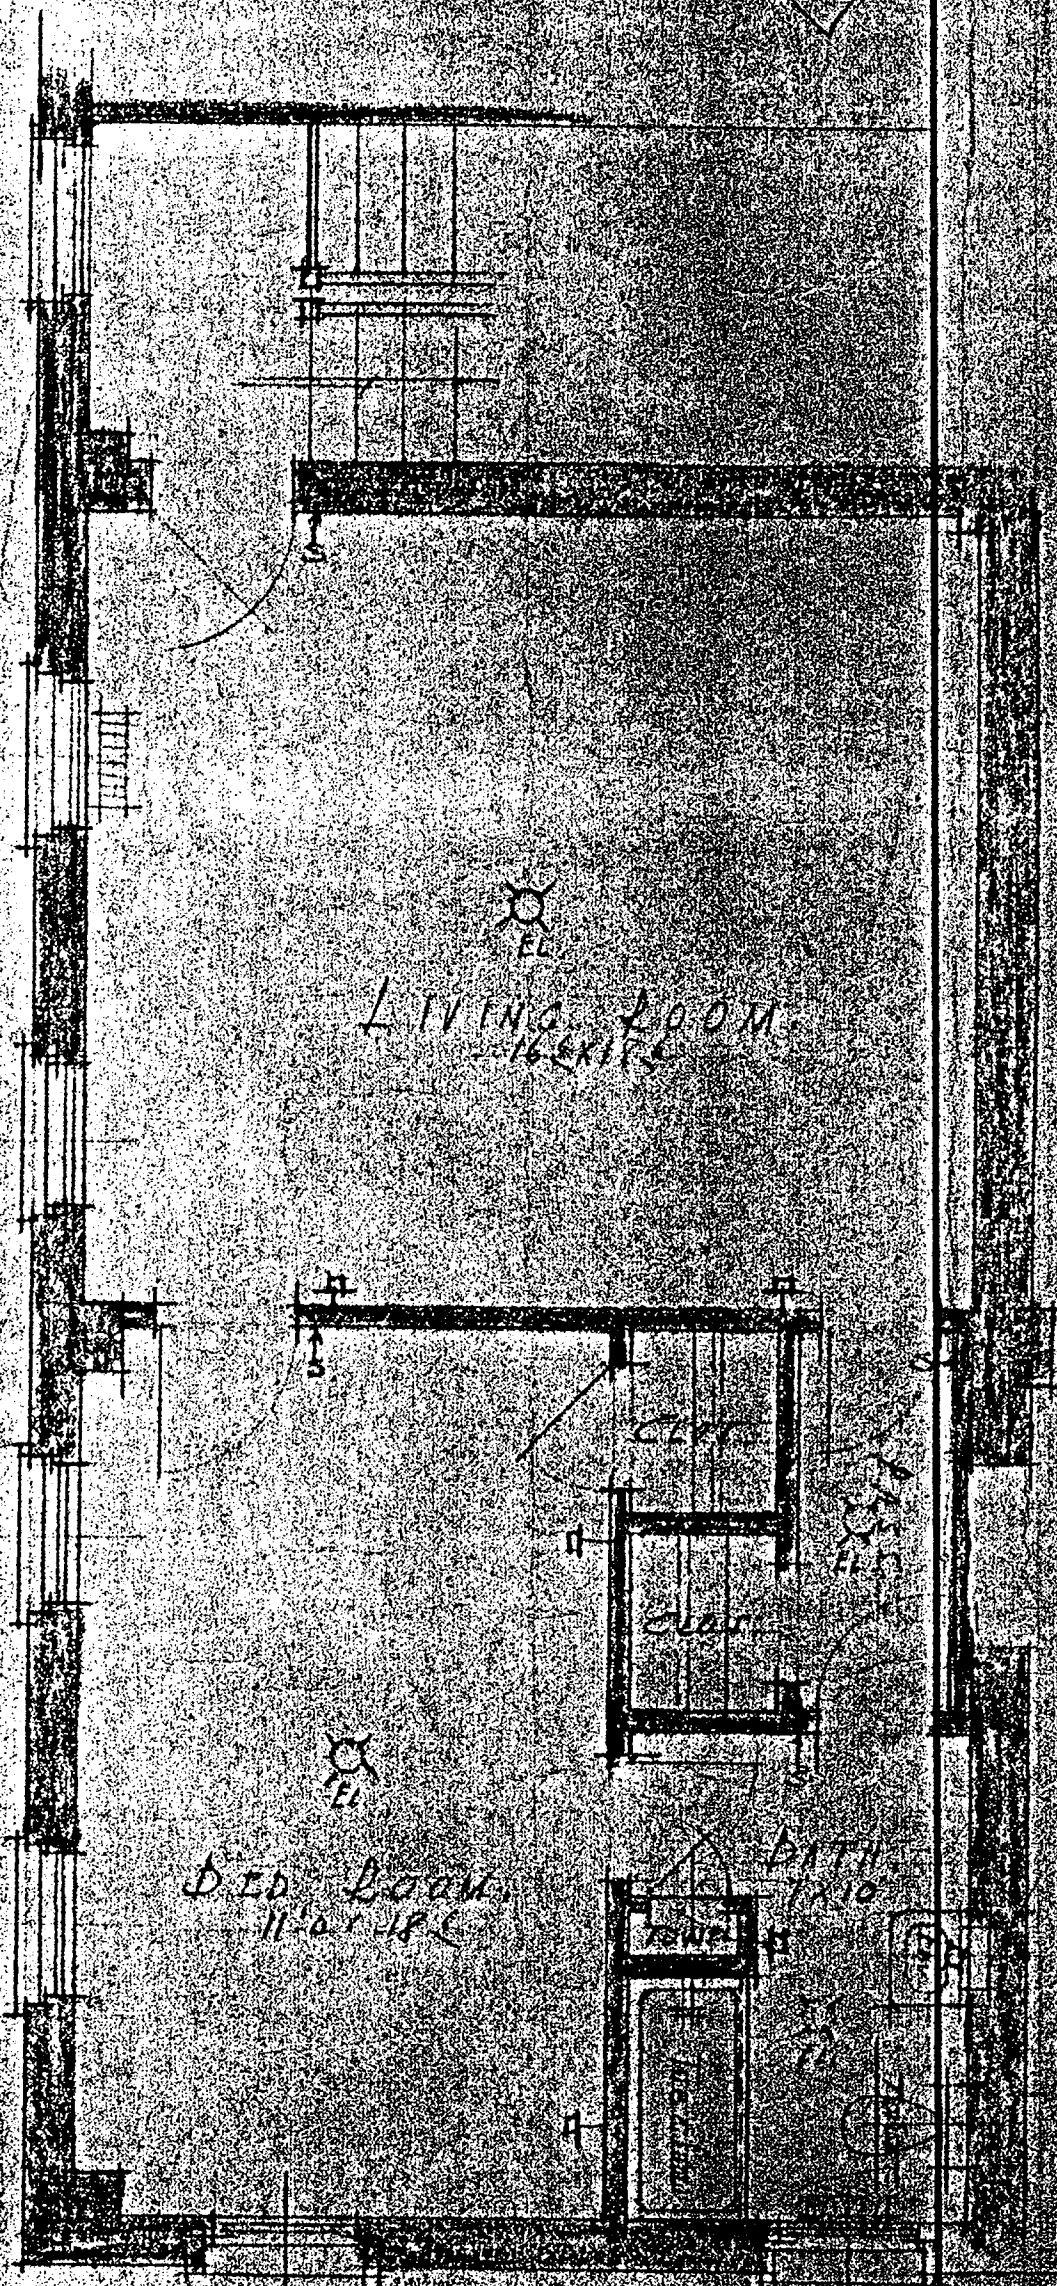

THIRD FLOOR PLAN
SCALE 1/4" = 1'-0"

APARTMENT
SAINTE THEATRE
CANTON STREET
NEW ORLEANS, LA