


• C O L U M N • S C H E D U L E •

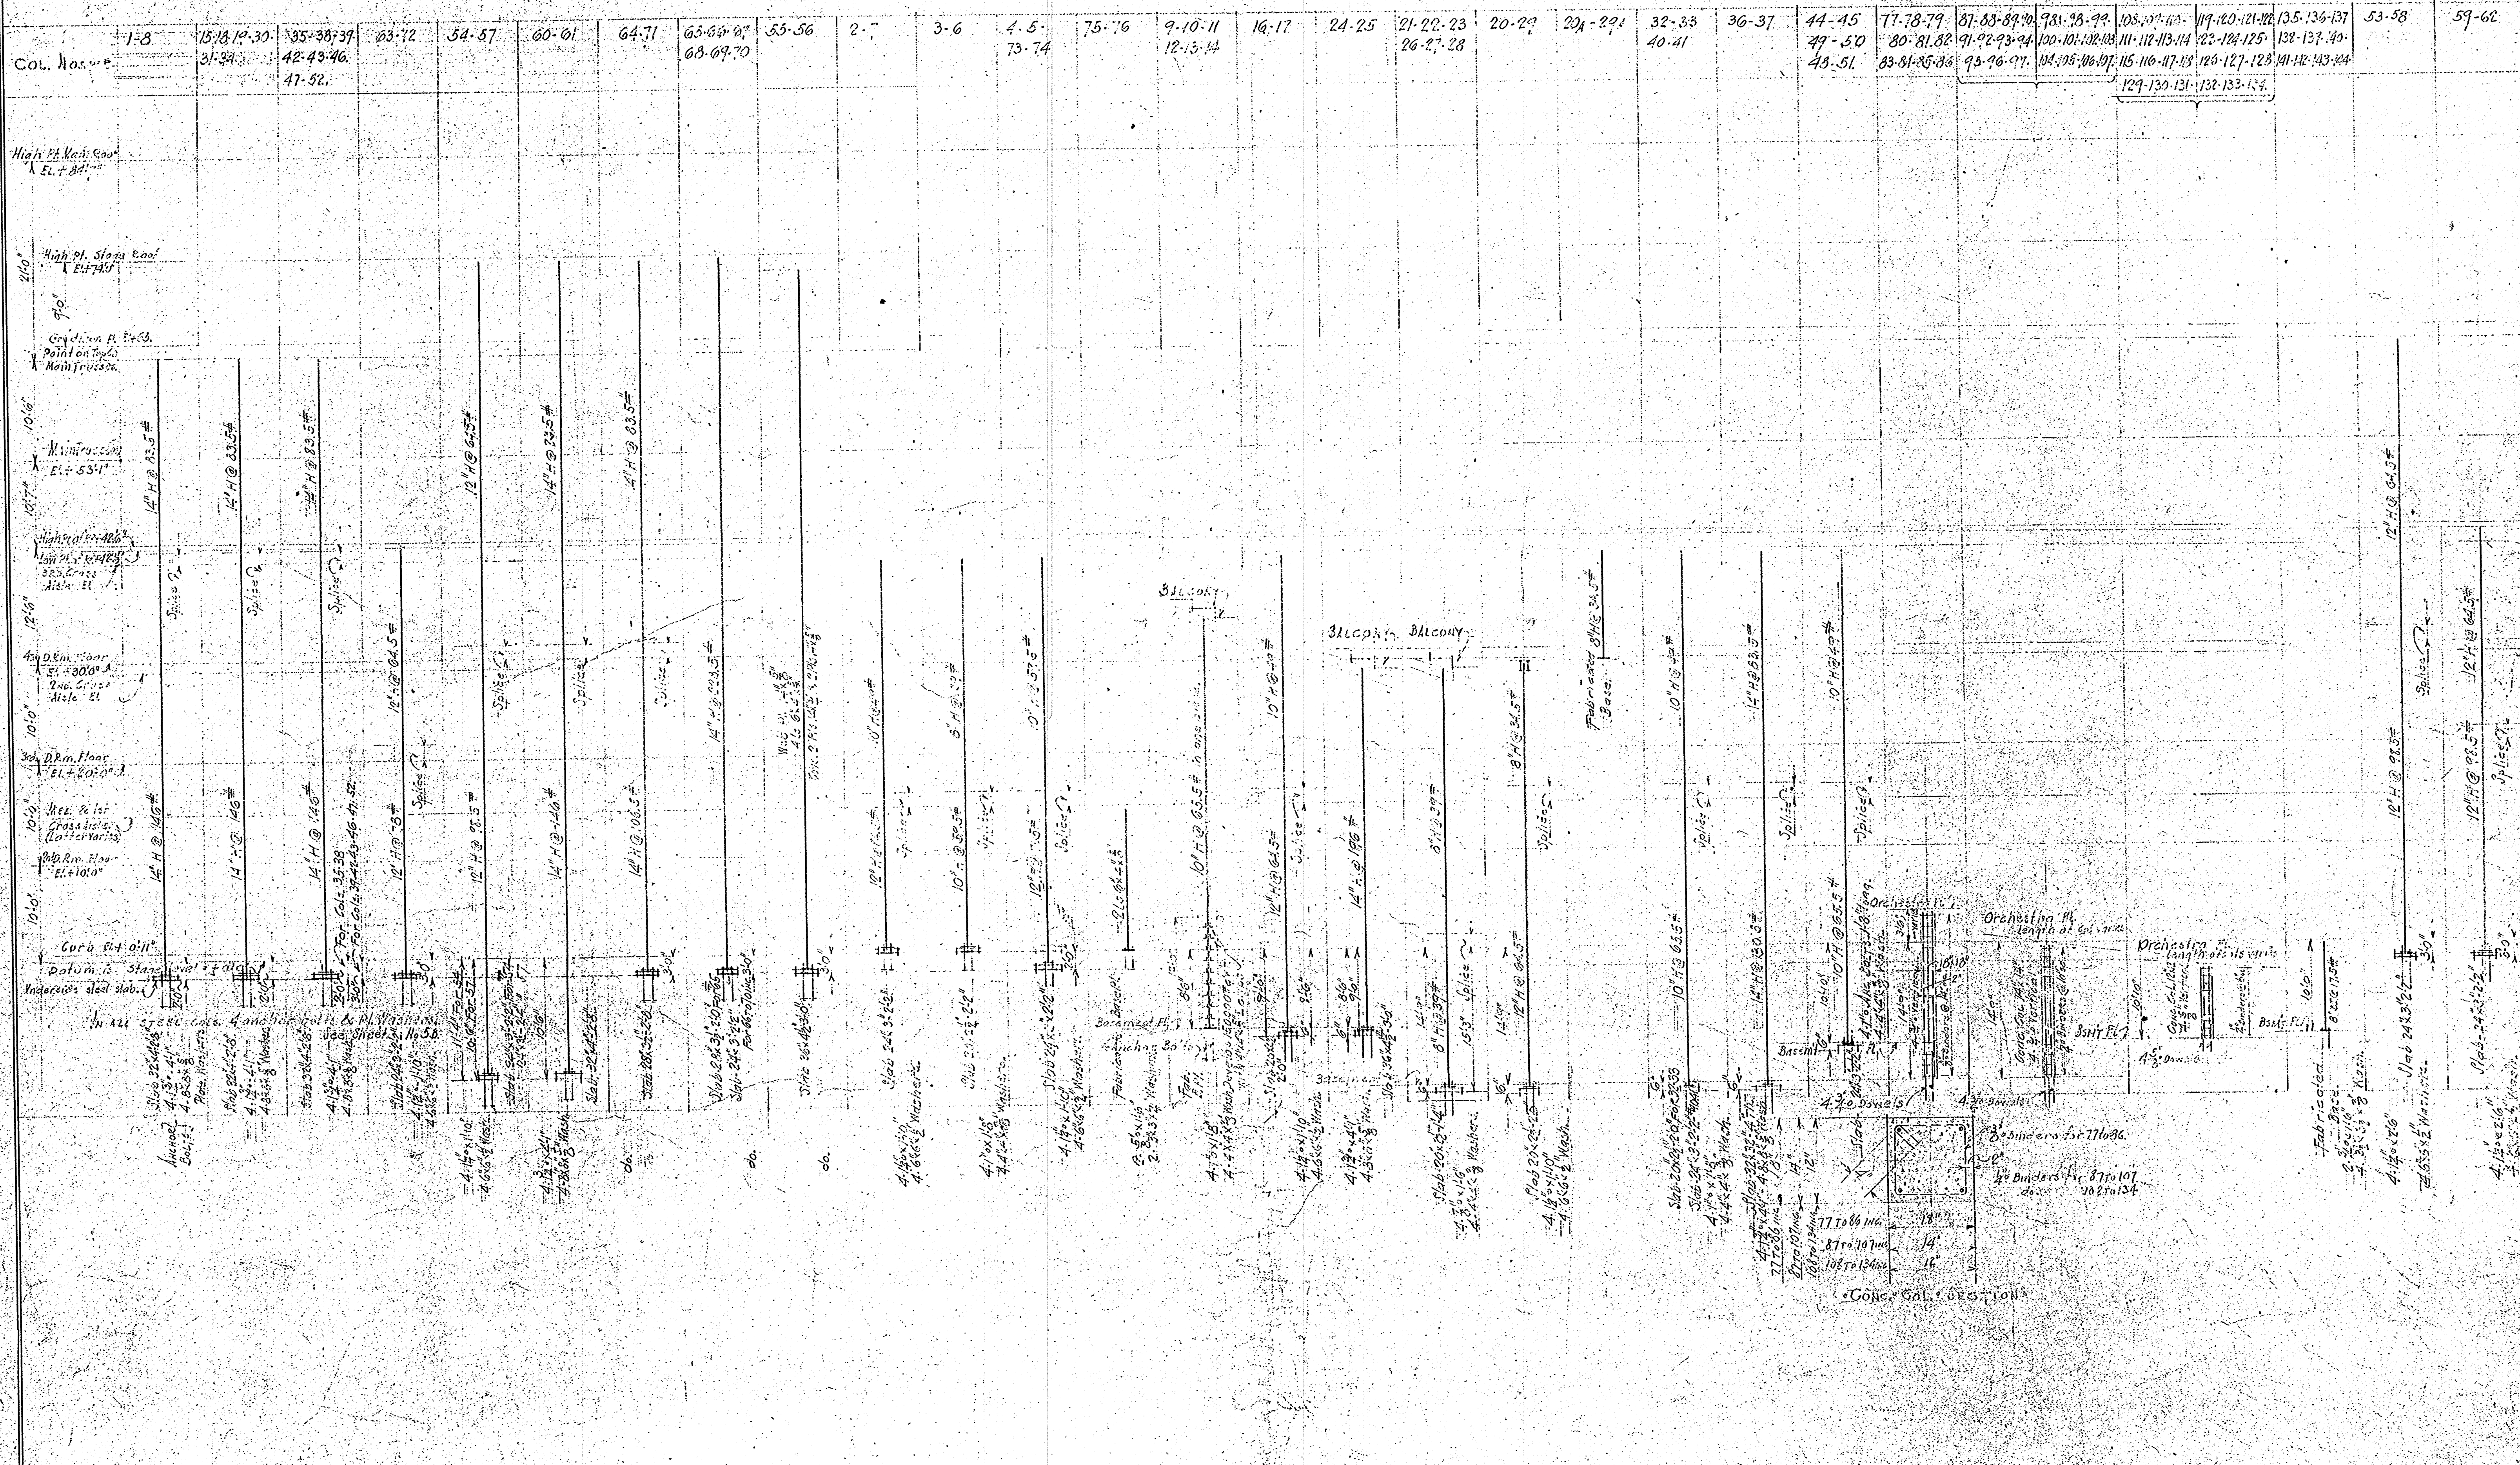

"CANAL STREET THEATRE"
FOR
JAENGER THEATRES, INC.
CANAL, N. CANAL, BEEVILLE, & N. SHERBOURNE STS.
NEW ORLEANS, LA.

REVISIONS
DEC. 1, 1925

EMILE WEIL ARCHITECTS
WHITNEY CENTRAL BUILDING
NEW ORLEANS, LA.

PLAN SHEET
894
DATE NOV. 28, 1925