




END ELEVATIONS

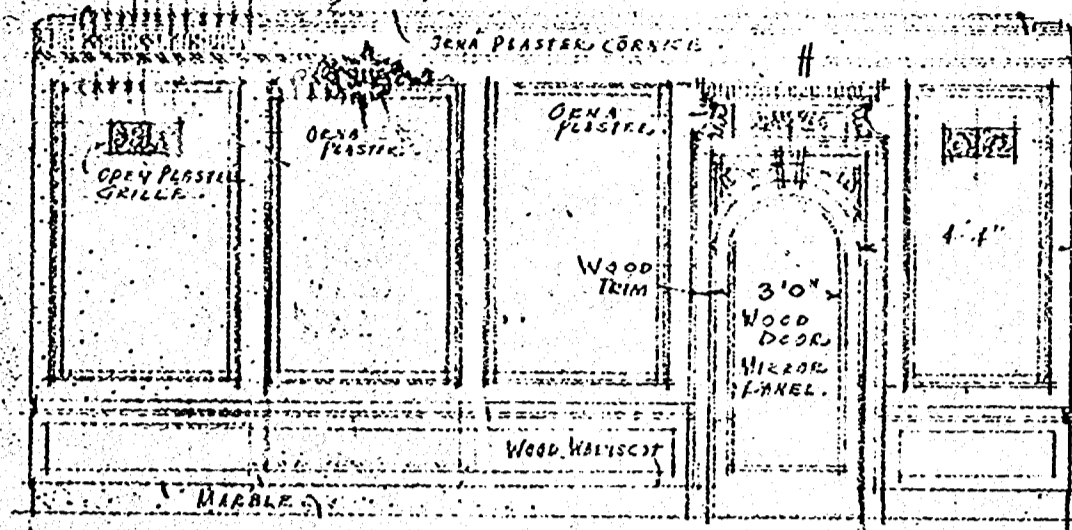


SIDE WALL ELEVATION

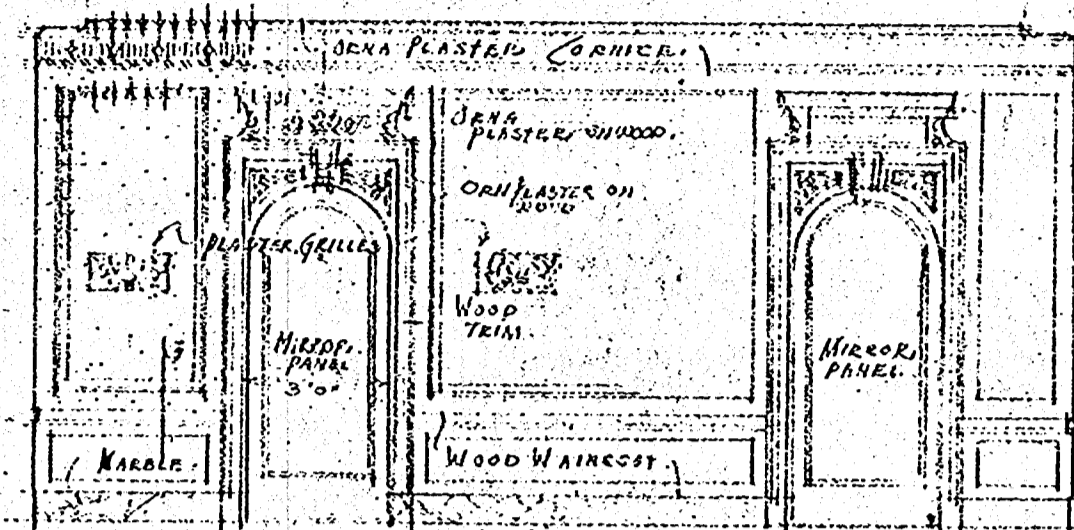


SIDE WALL ELEVATION - A

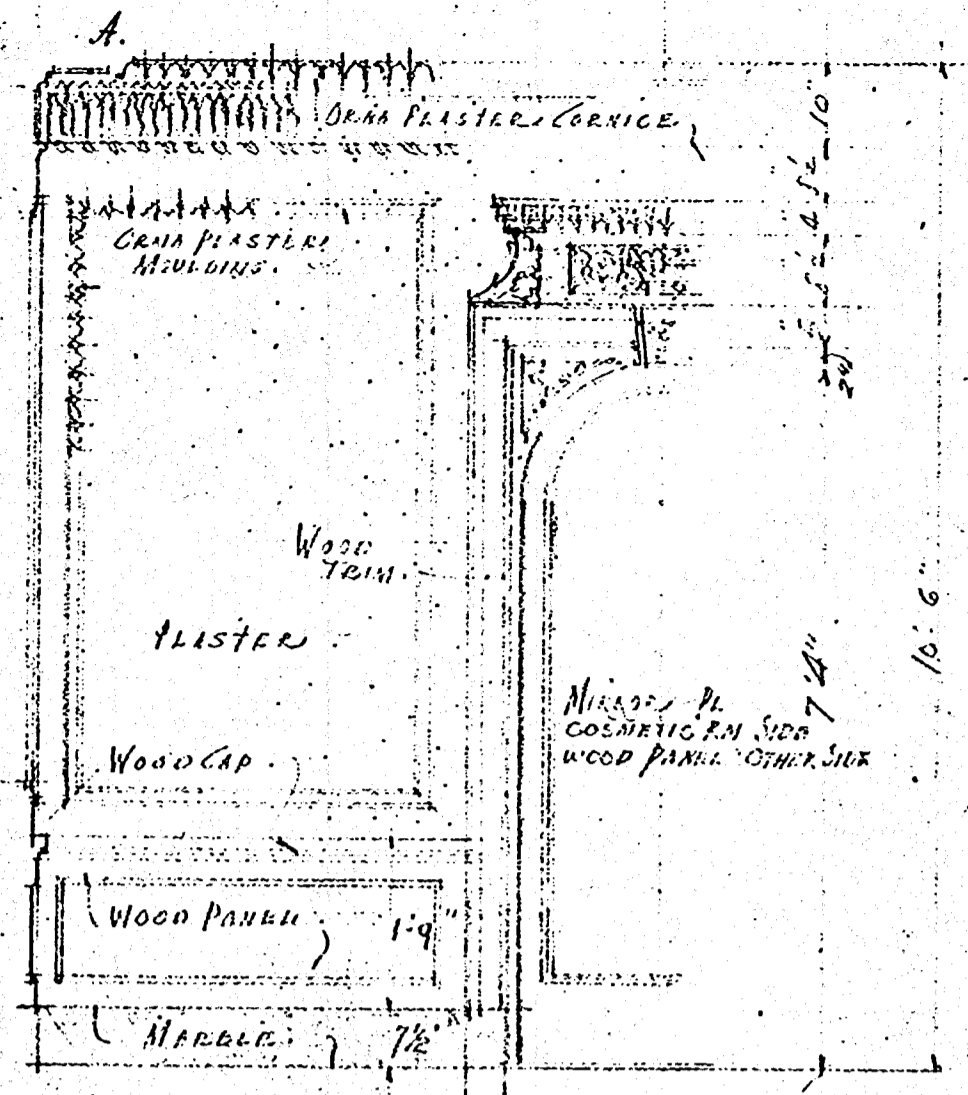

REFLECTED VIEW OF CORNICE A.

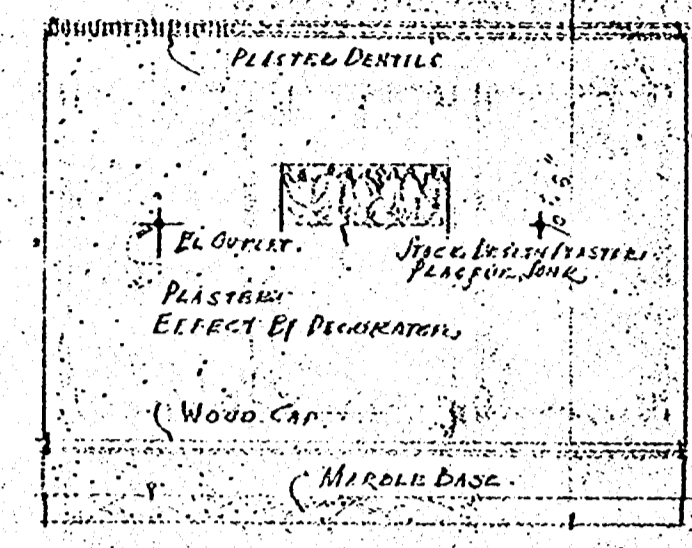


END ELEVATIONS

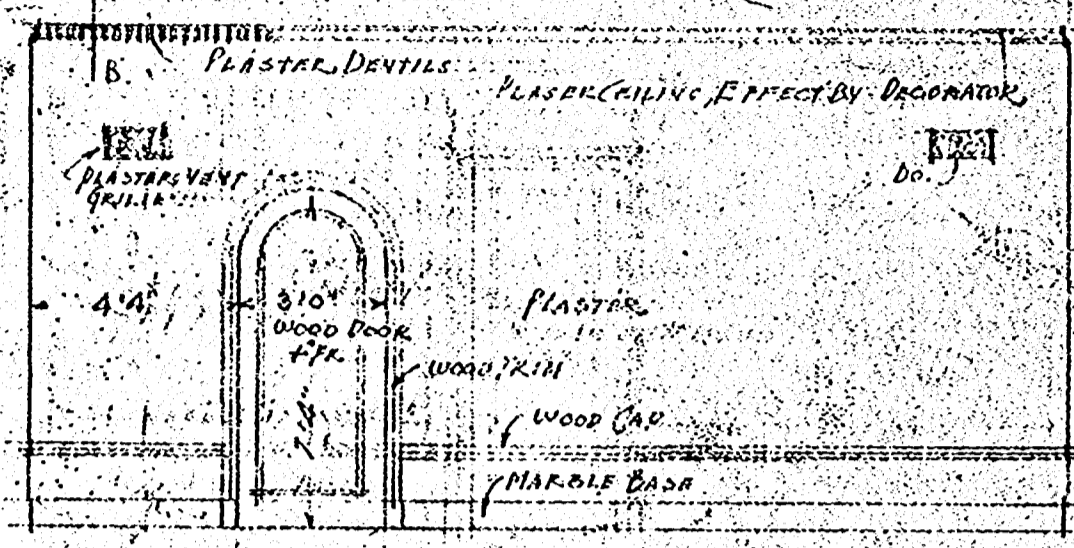

SIDE ELEVATION


ELEVATIONS OF LADIES COSMETIC ROOM
SCALE 1/4" = 1'-0"

MEN'S SMOKING ROOM
ALL SIDES OF SIMILAR DESIGN

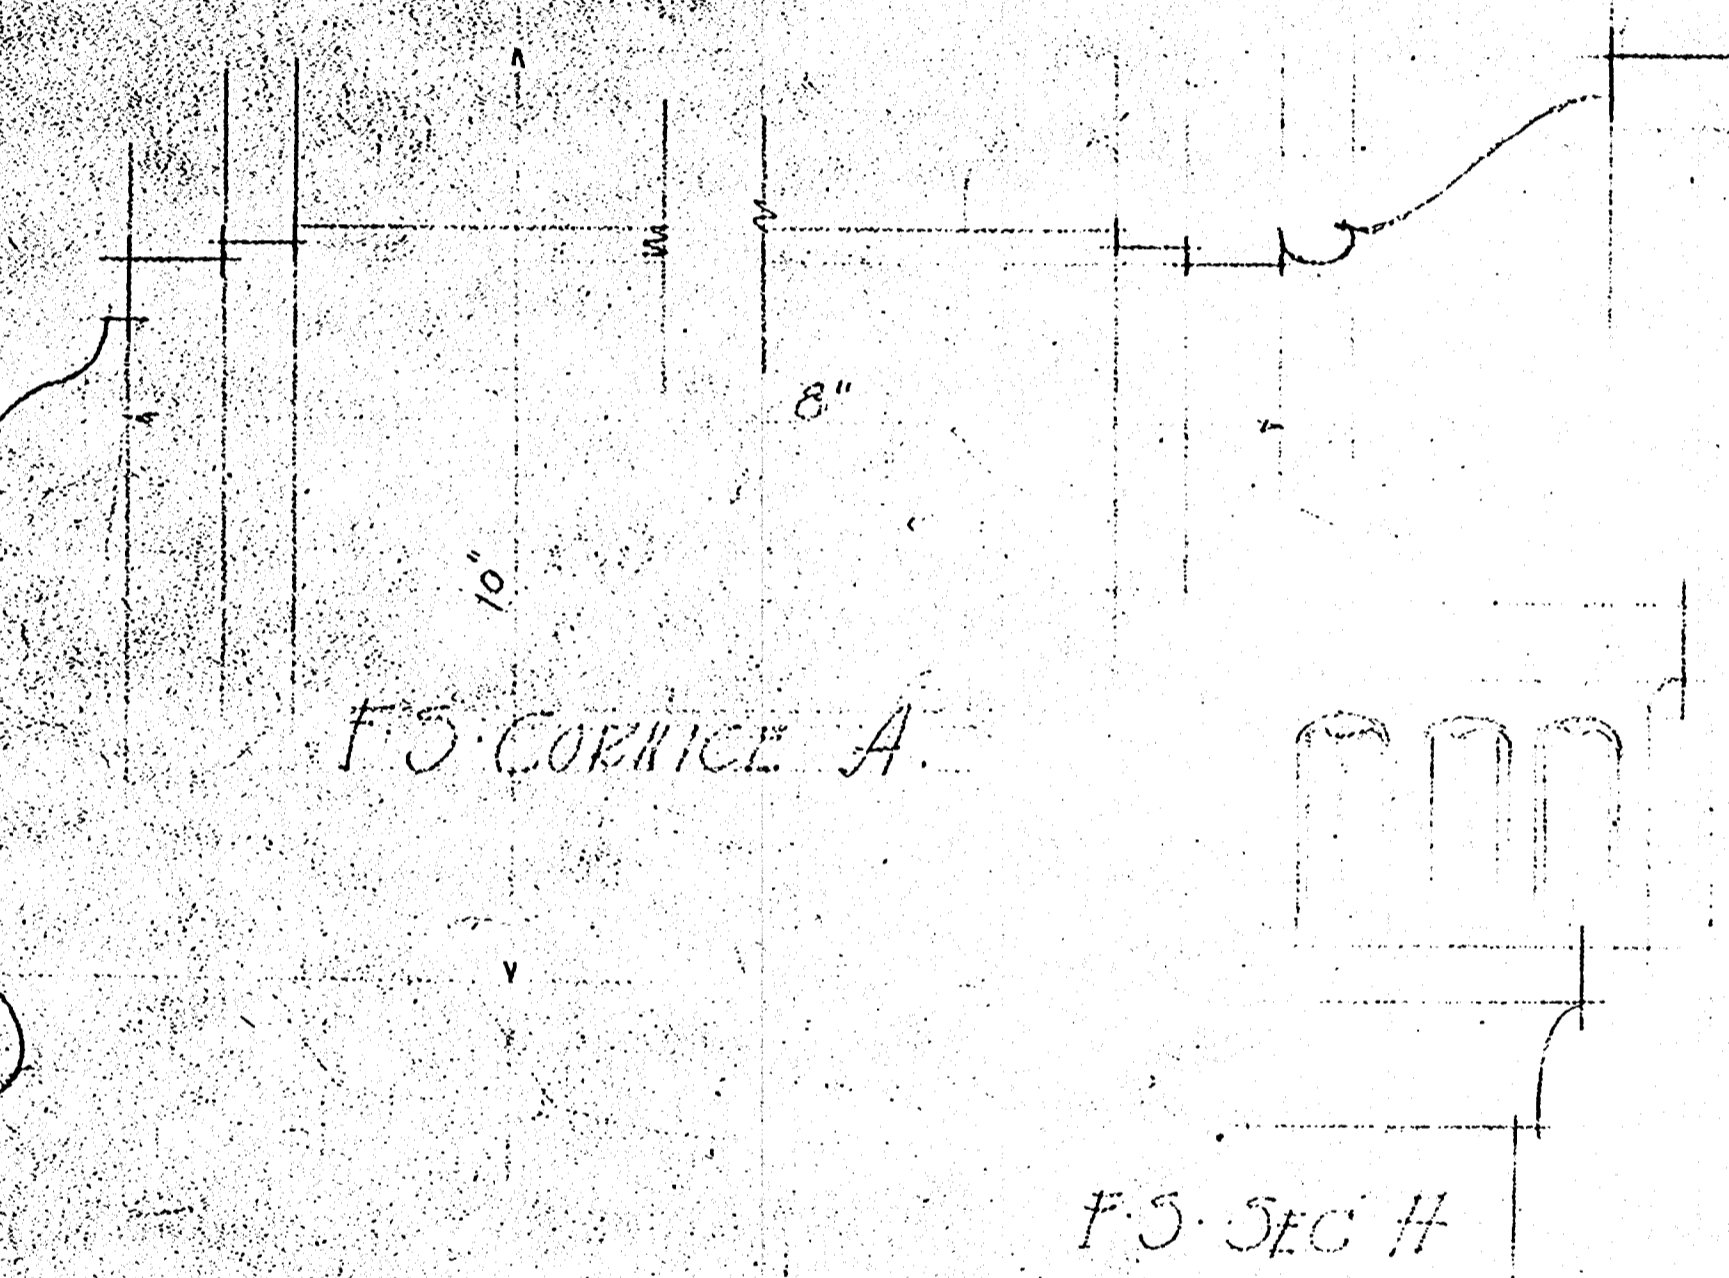


F.S. CORNICE A.

F.S. SEC H.

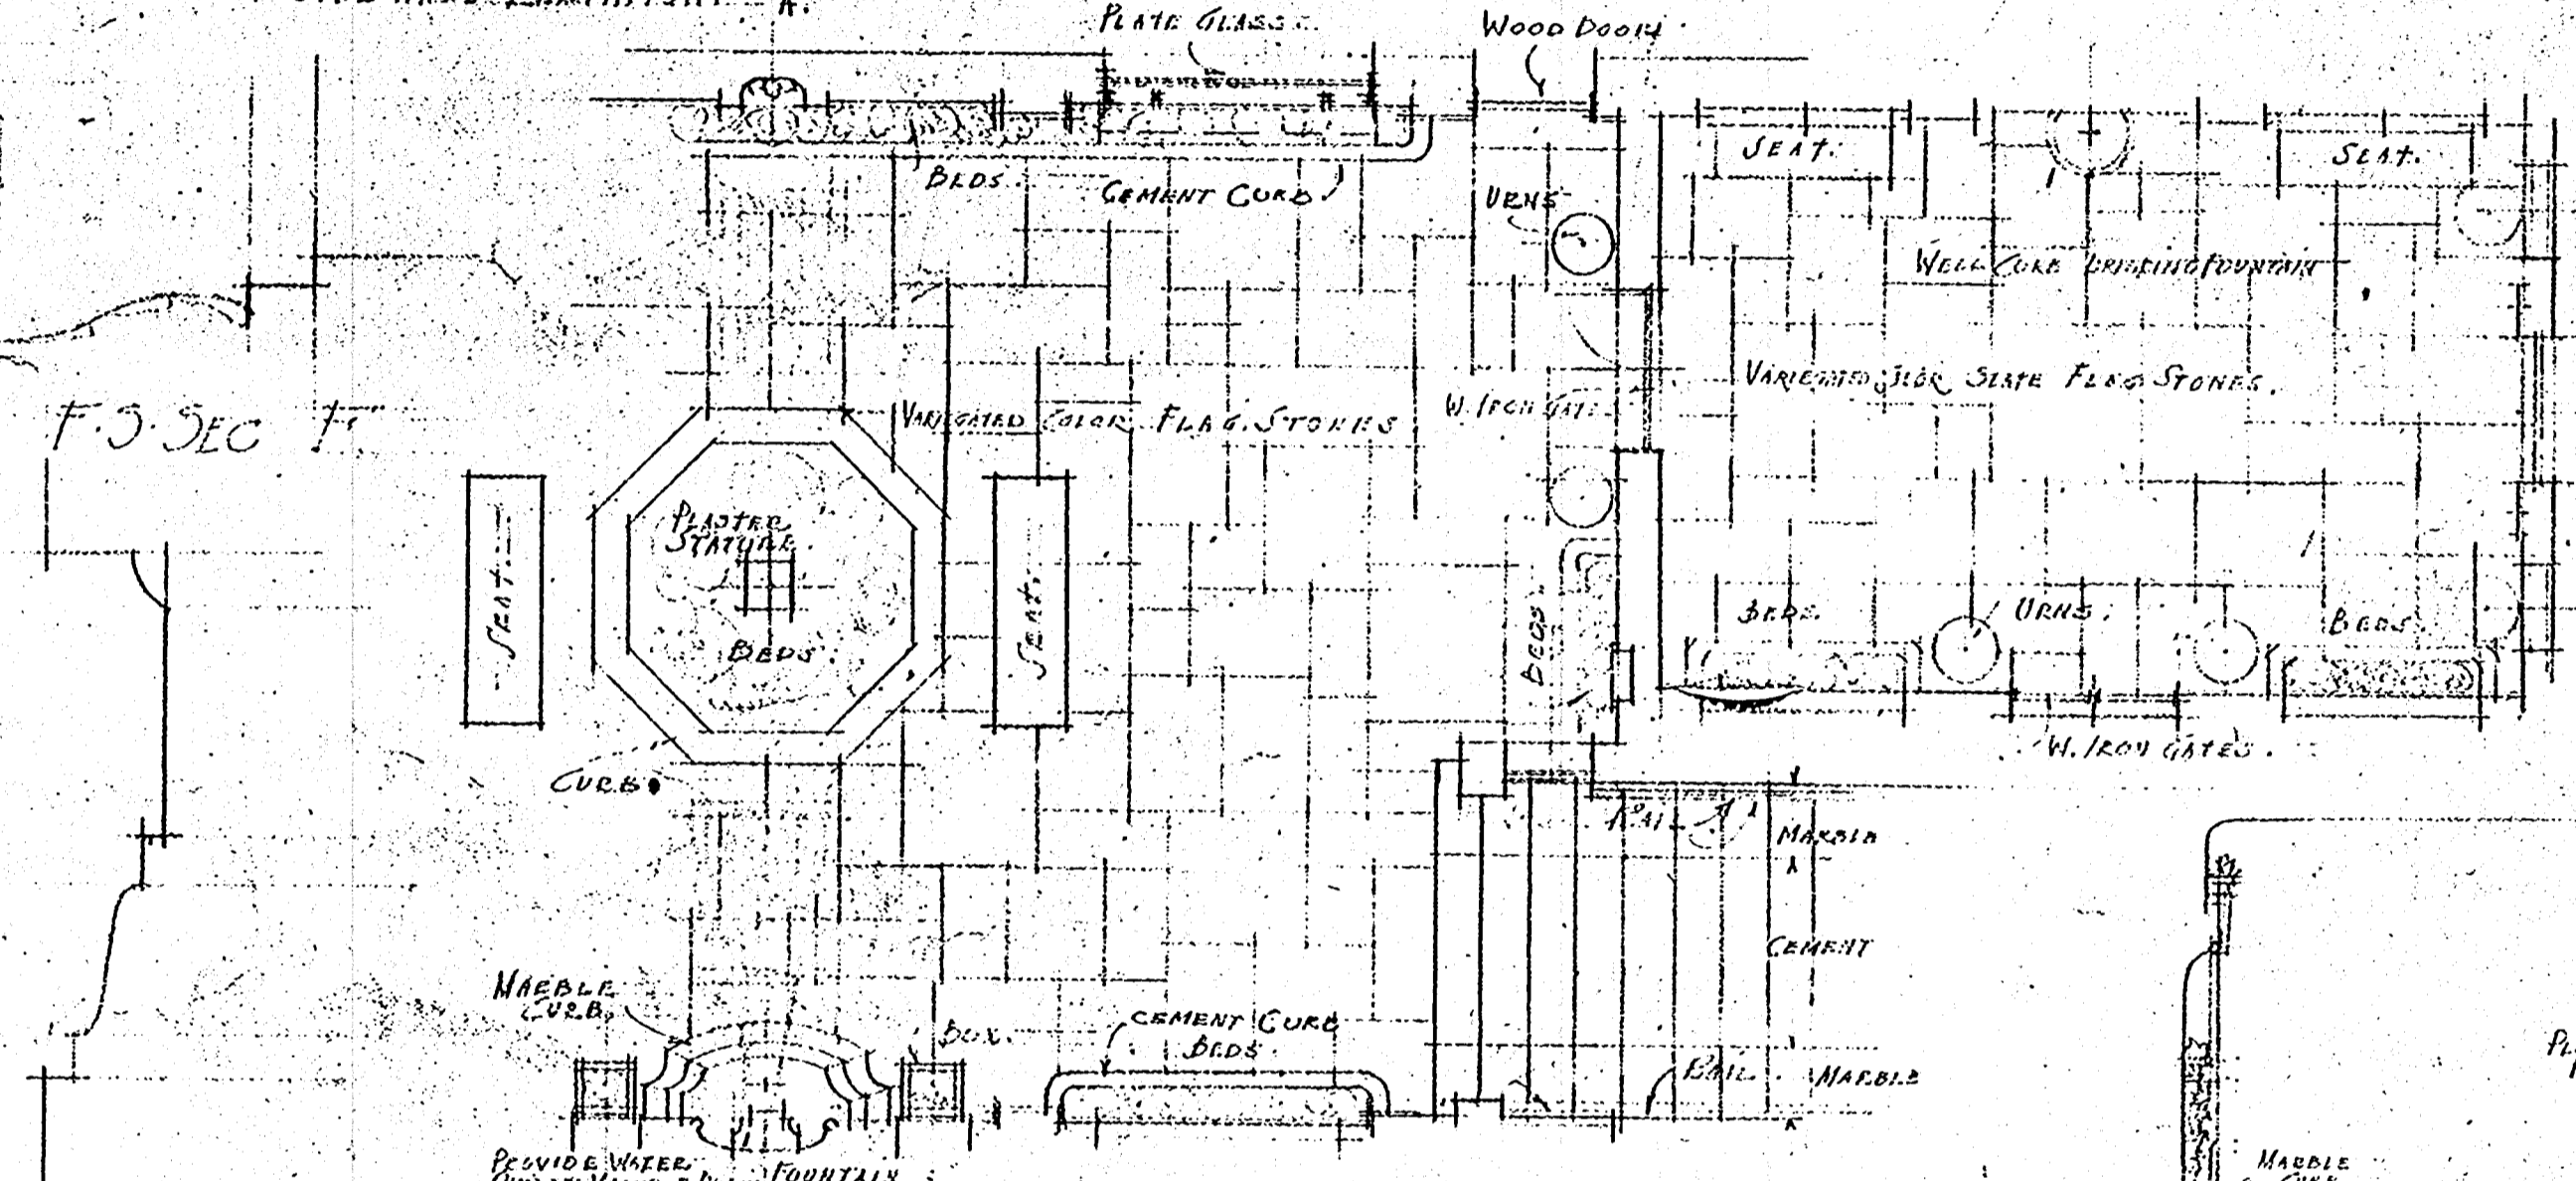


FLOOR PLAN
SCALE 1/4" = 1'-0"


F.S. SEC G.

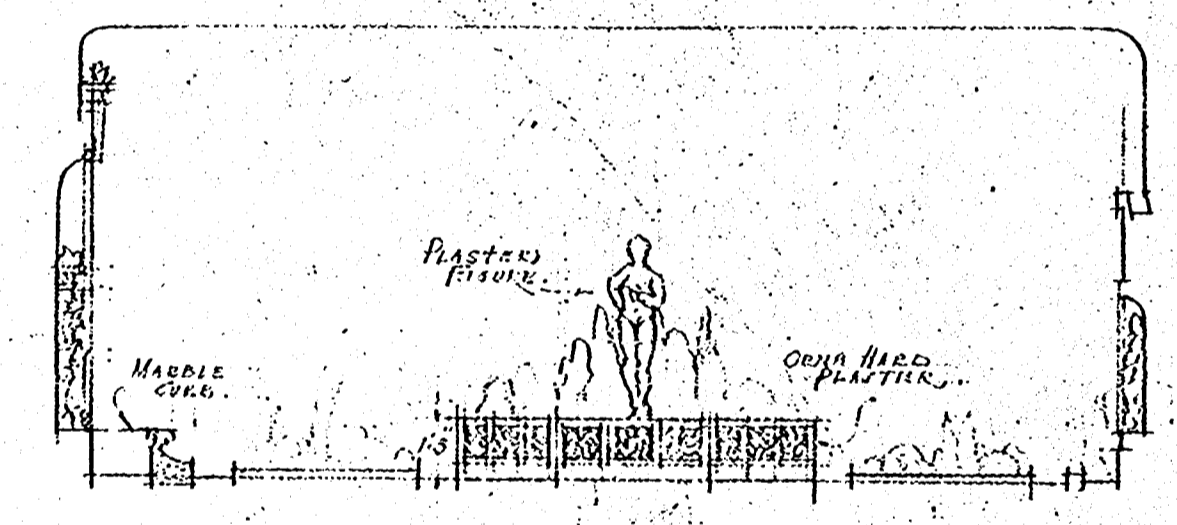


SECTION ON LINE A-B.

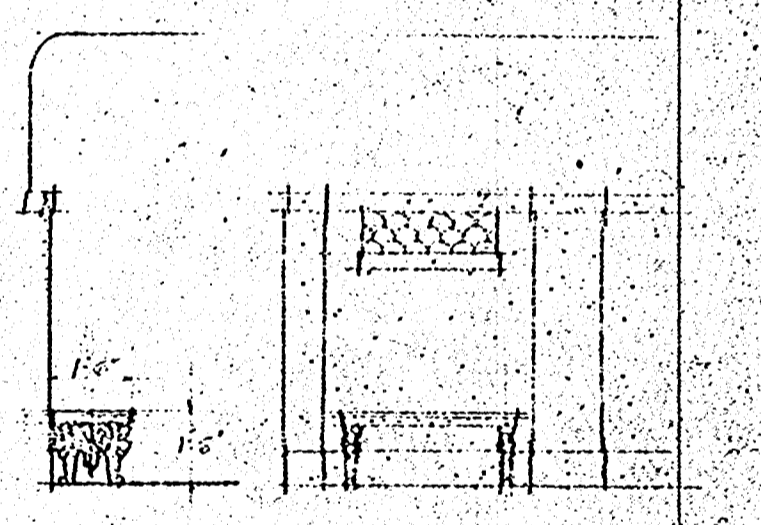


DETAIL OF MARBLE SEATS
SEATS BY OWNER

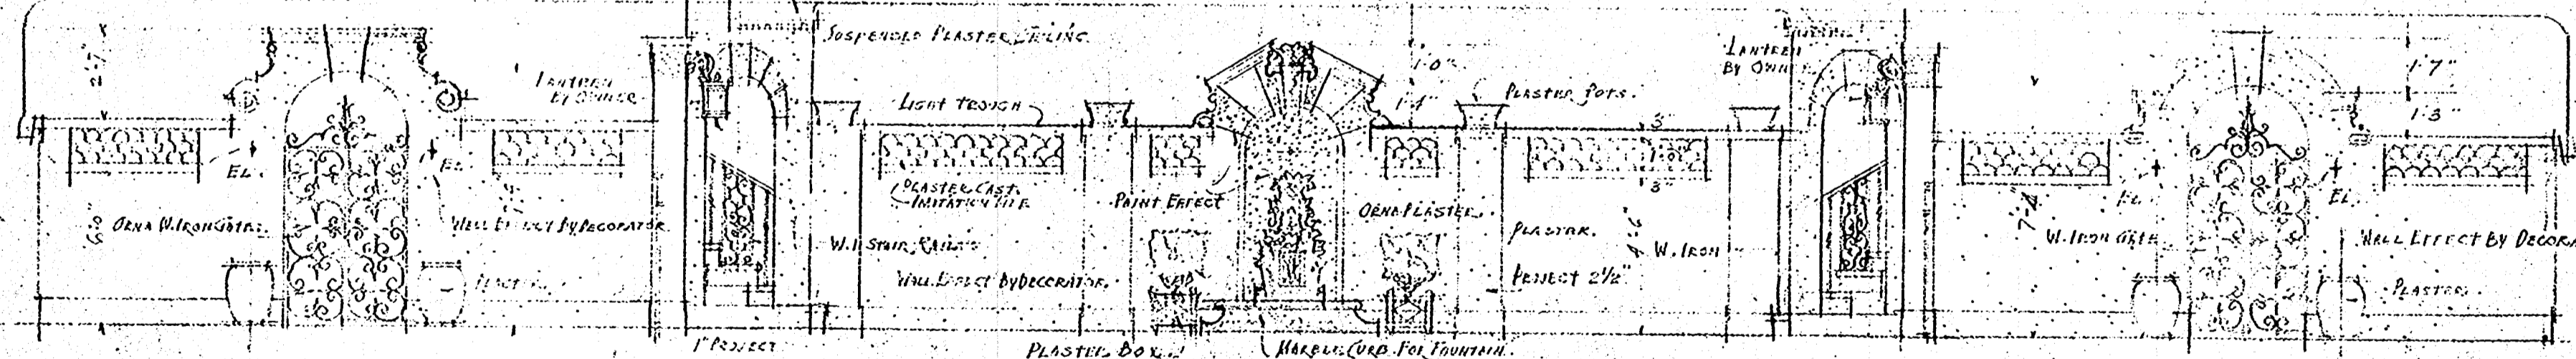


WALL TOWARDS CANAL STREET
SCALE 1/4" = 1'-0"

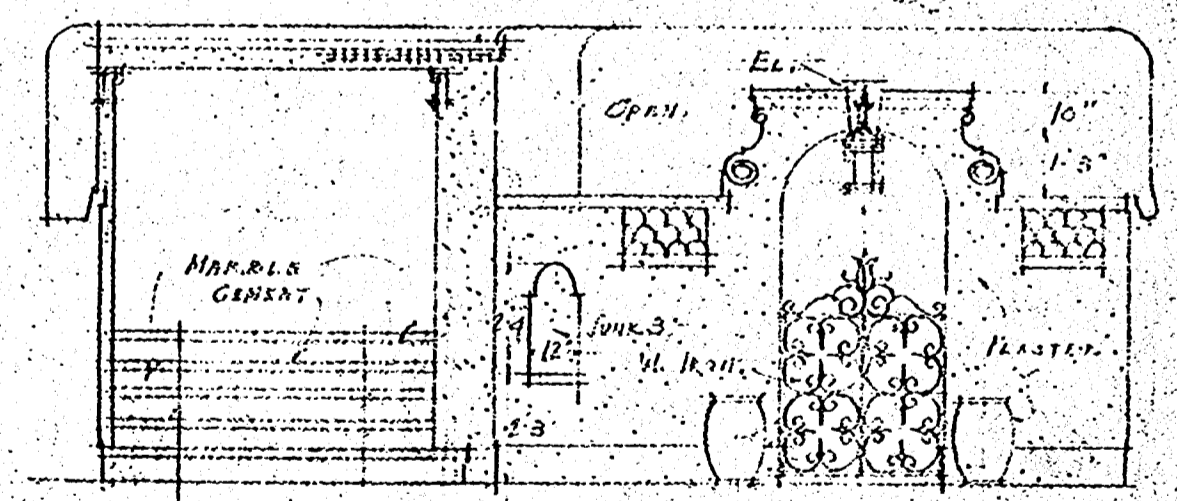

DETAIL ELEVATIONS OF BASEMENT
MEN'S & LADIES ROOMS

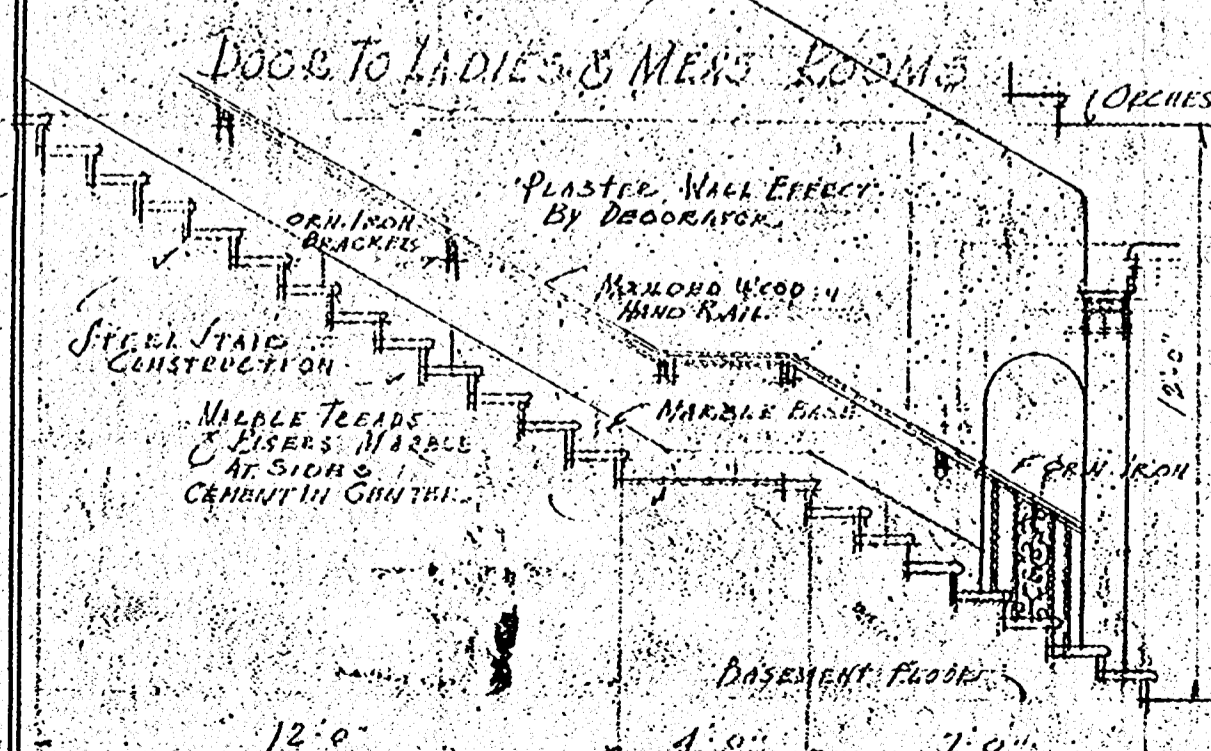

SECTION THRU STAIRWAY

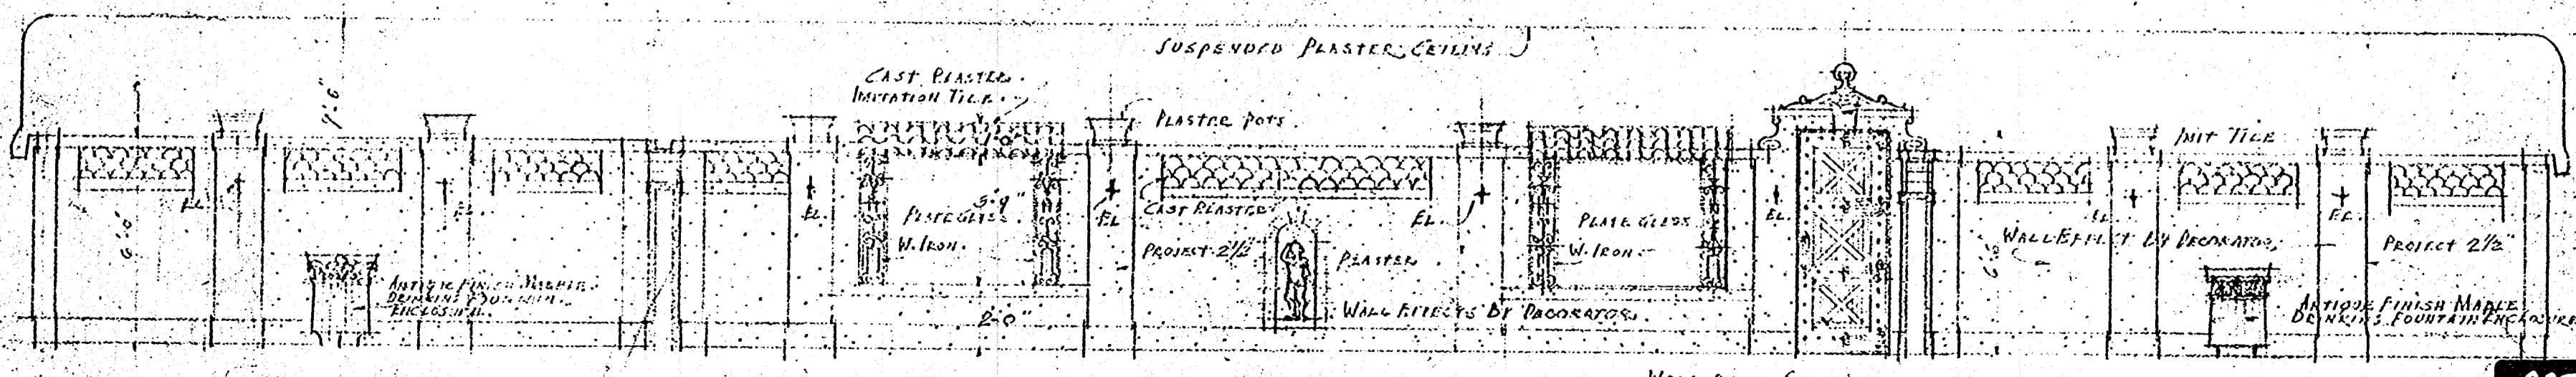

WALL TOWARDS BEVILLE STREET
SCALE 1/4" = 1'-0"

DETAIL ELEVATIONS OF
BASEMENT.
MEN'S & LADIES ROOMS

CANAL STREET THEATRE
FOR
SAENGER THEATRES, INC
CANAL N. RAMPART, ALBANY, N. SARATOGA, OR BASH STG.
NEW ORLEANS, LA.

REVISED
EMILE WEILL ARCHITECTS
WHITNEY CENTRAL BUILDING
NEW ORLEANS, LA.

PLAN SHEET
894
DATE APR. 3/22