


SECTION THRU CROSS ARCADE
SCALE 1/8 INCH = 1 FT.

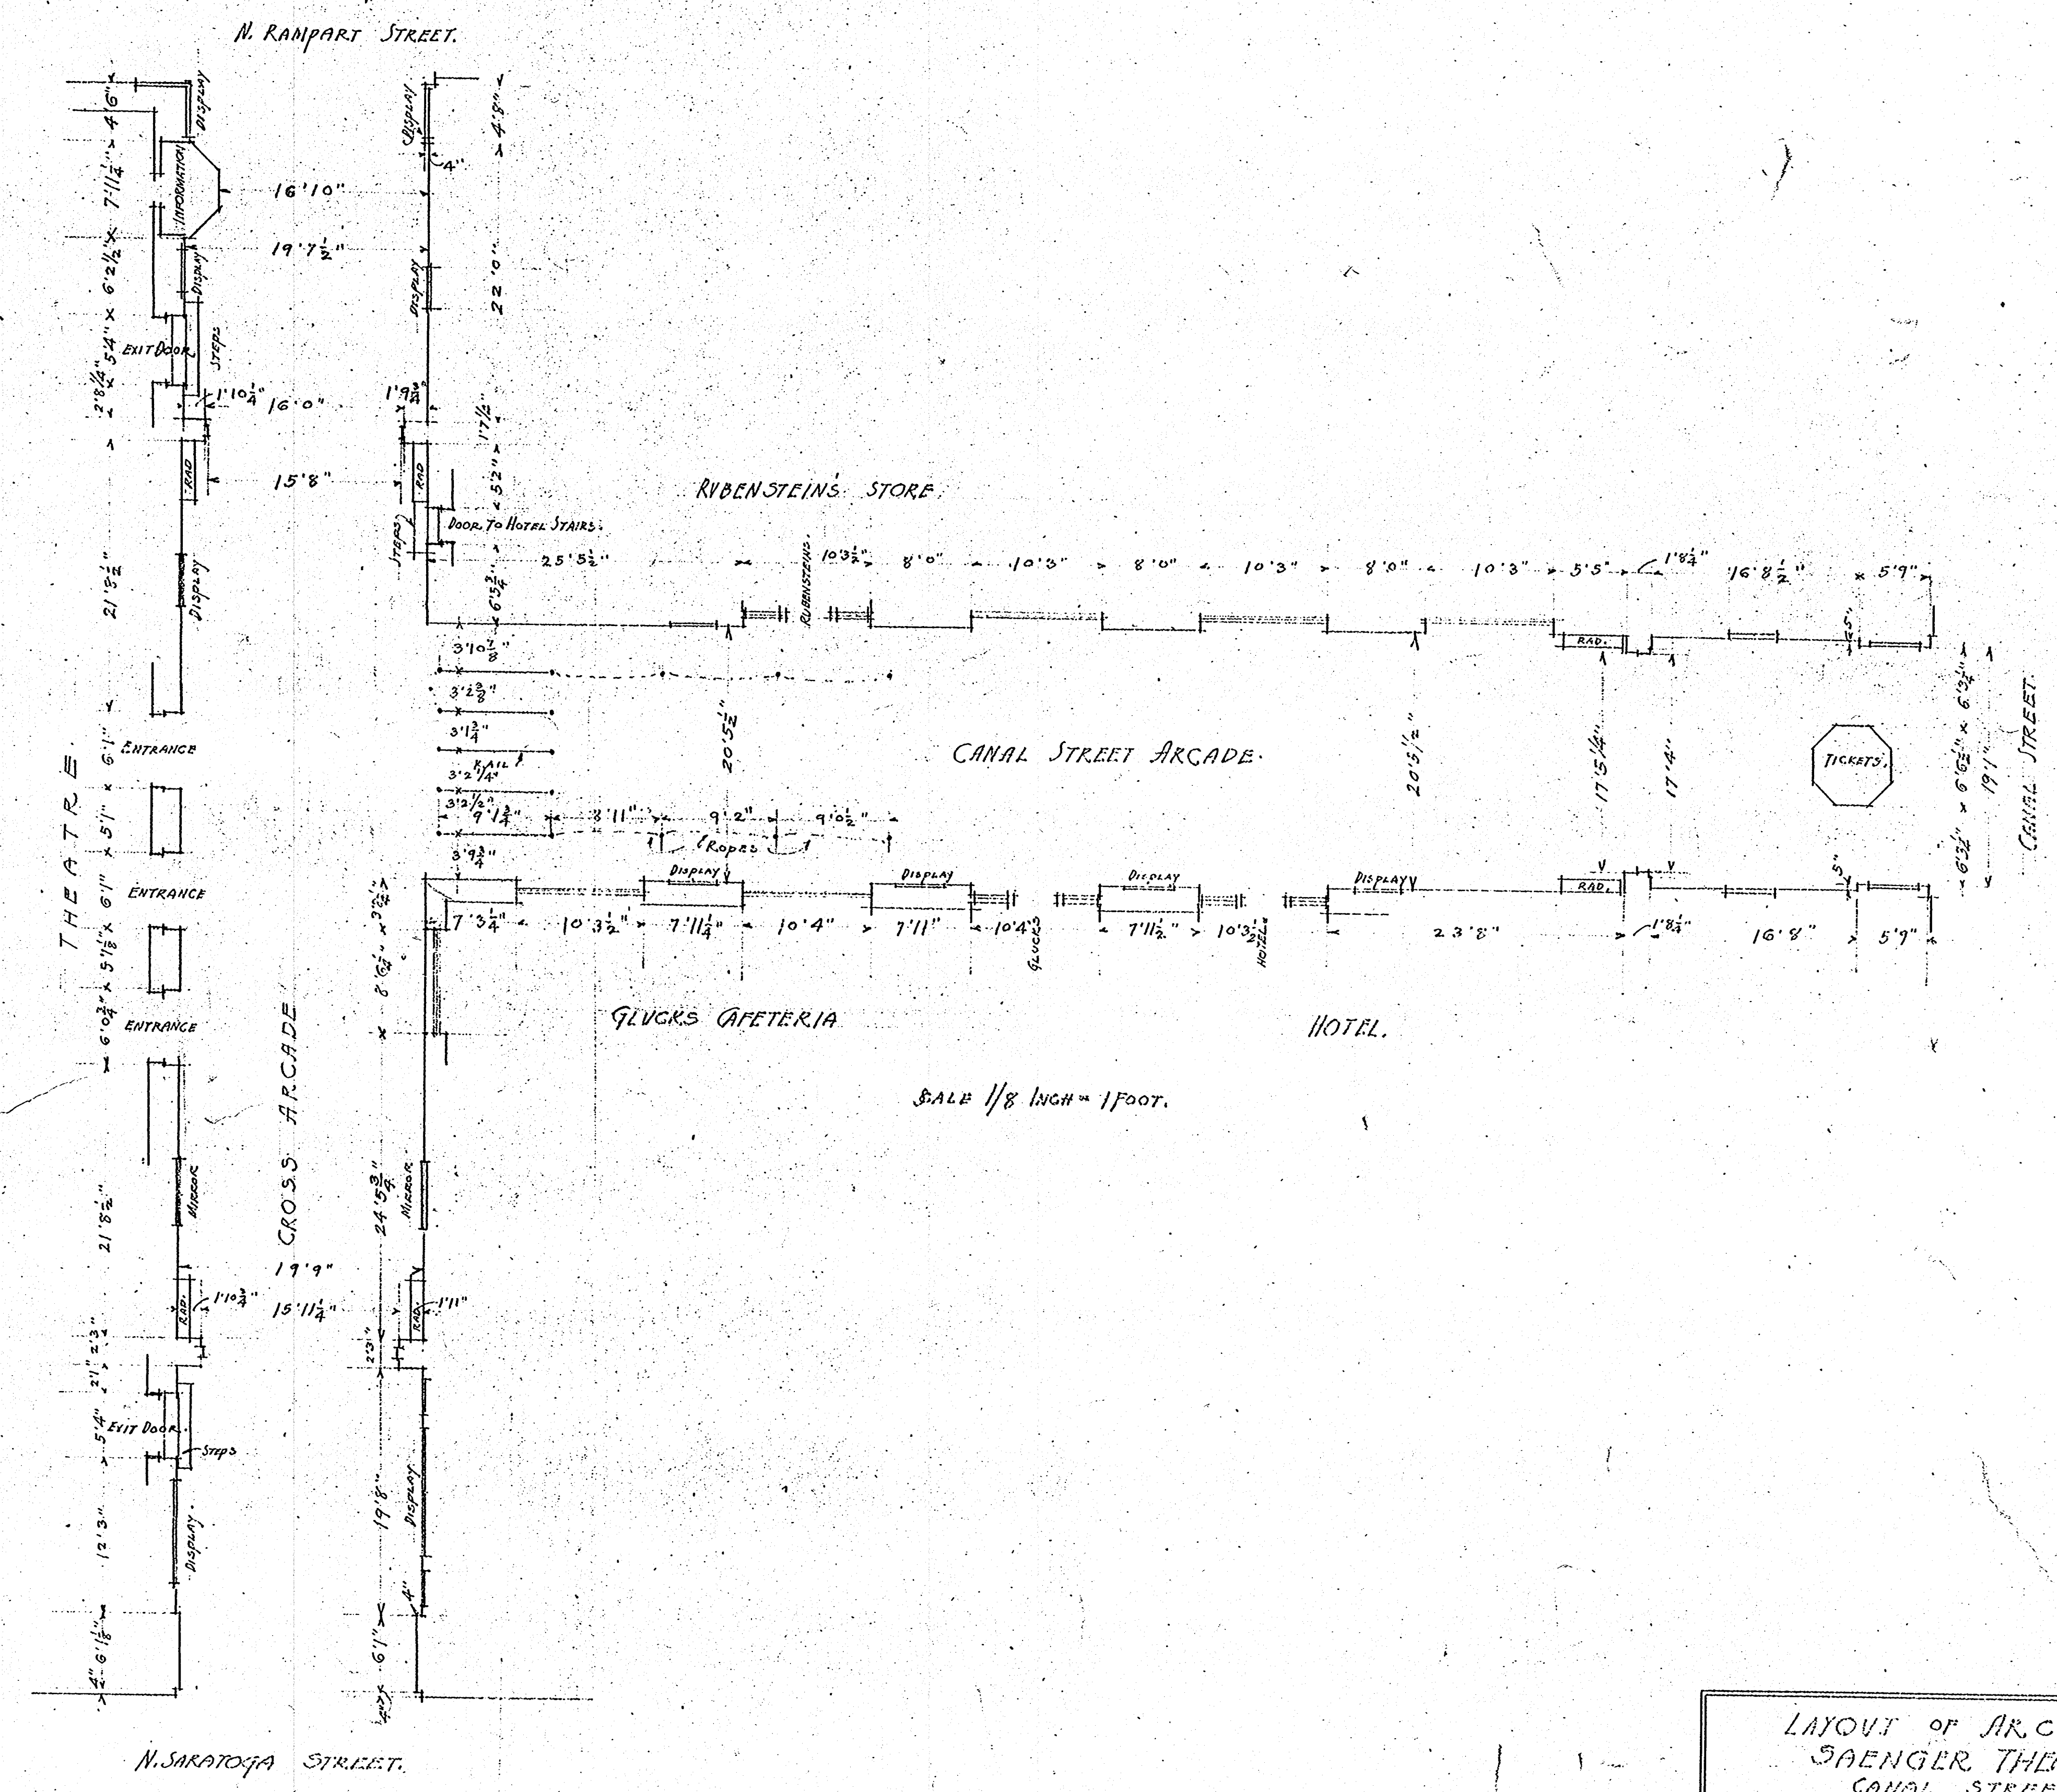

SCALE 1/8 INCH = 1 FOOT.

LAYOUT OF ARCADES SAENGER THEATRE CANAL STREET NEW ORLEANS, LA.			
REVISED	EMILE WEILL ARCHITECTS WHITNEY CENTRAL BUILDING NEW ORLEANS, LA.	PLAN	SHEET
			DATE FEB 3/1927