


ELEVATION
SCALE 1"=1'-0"

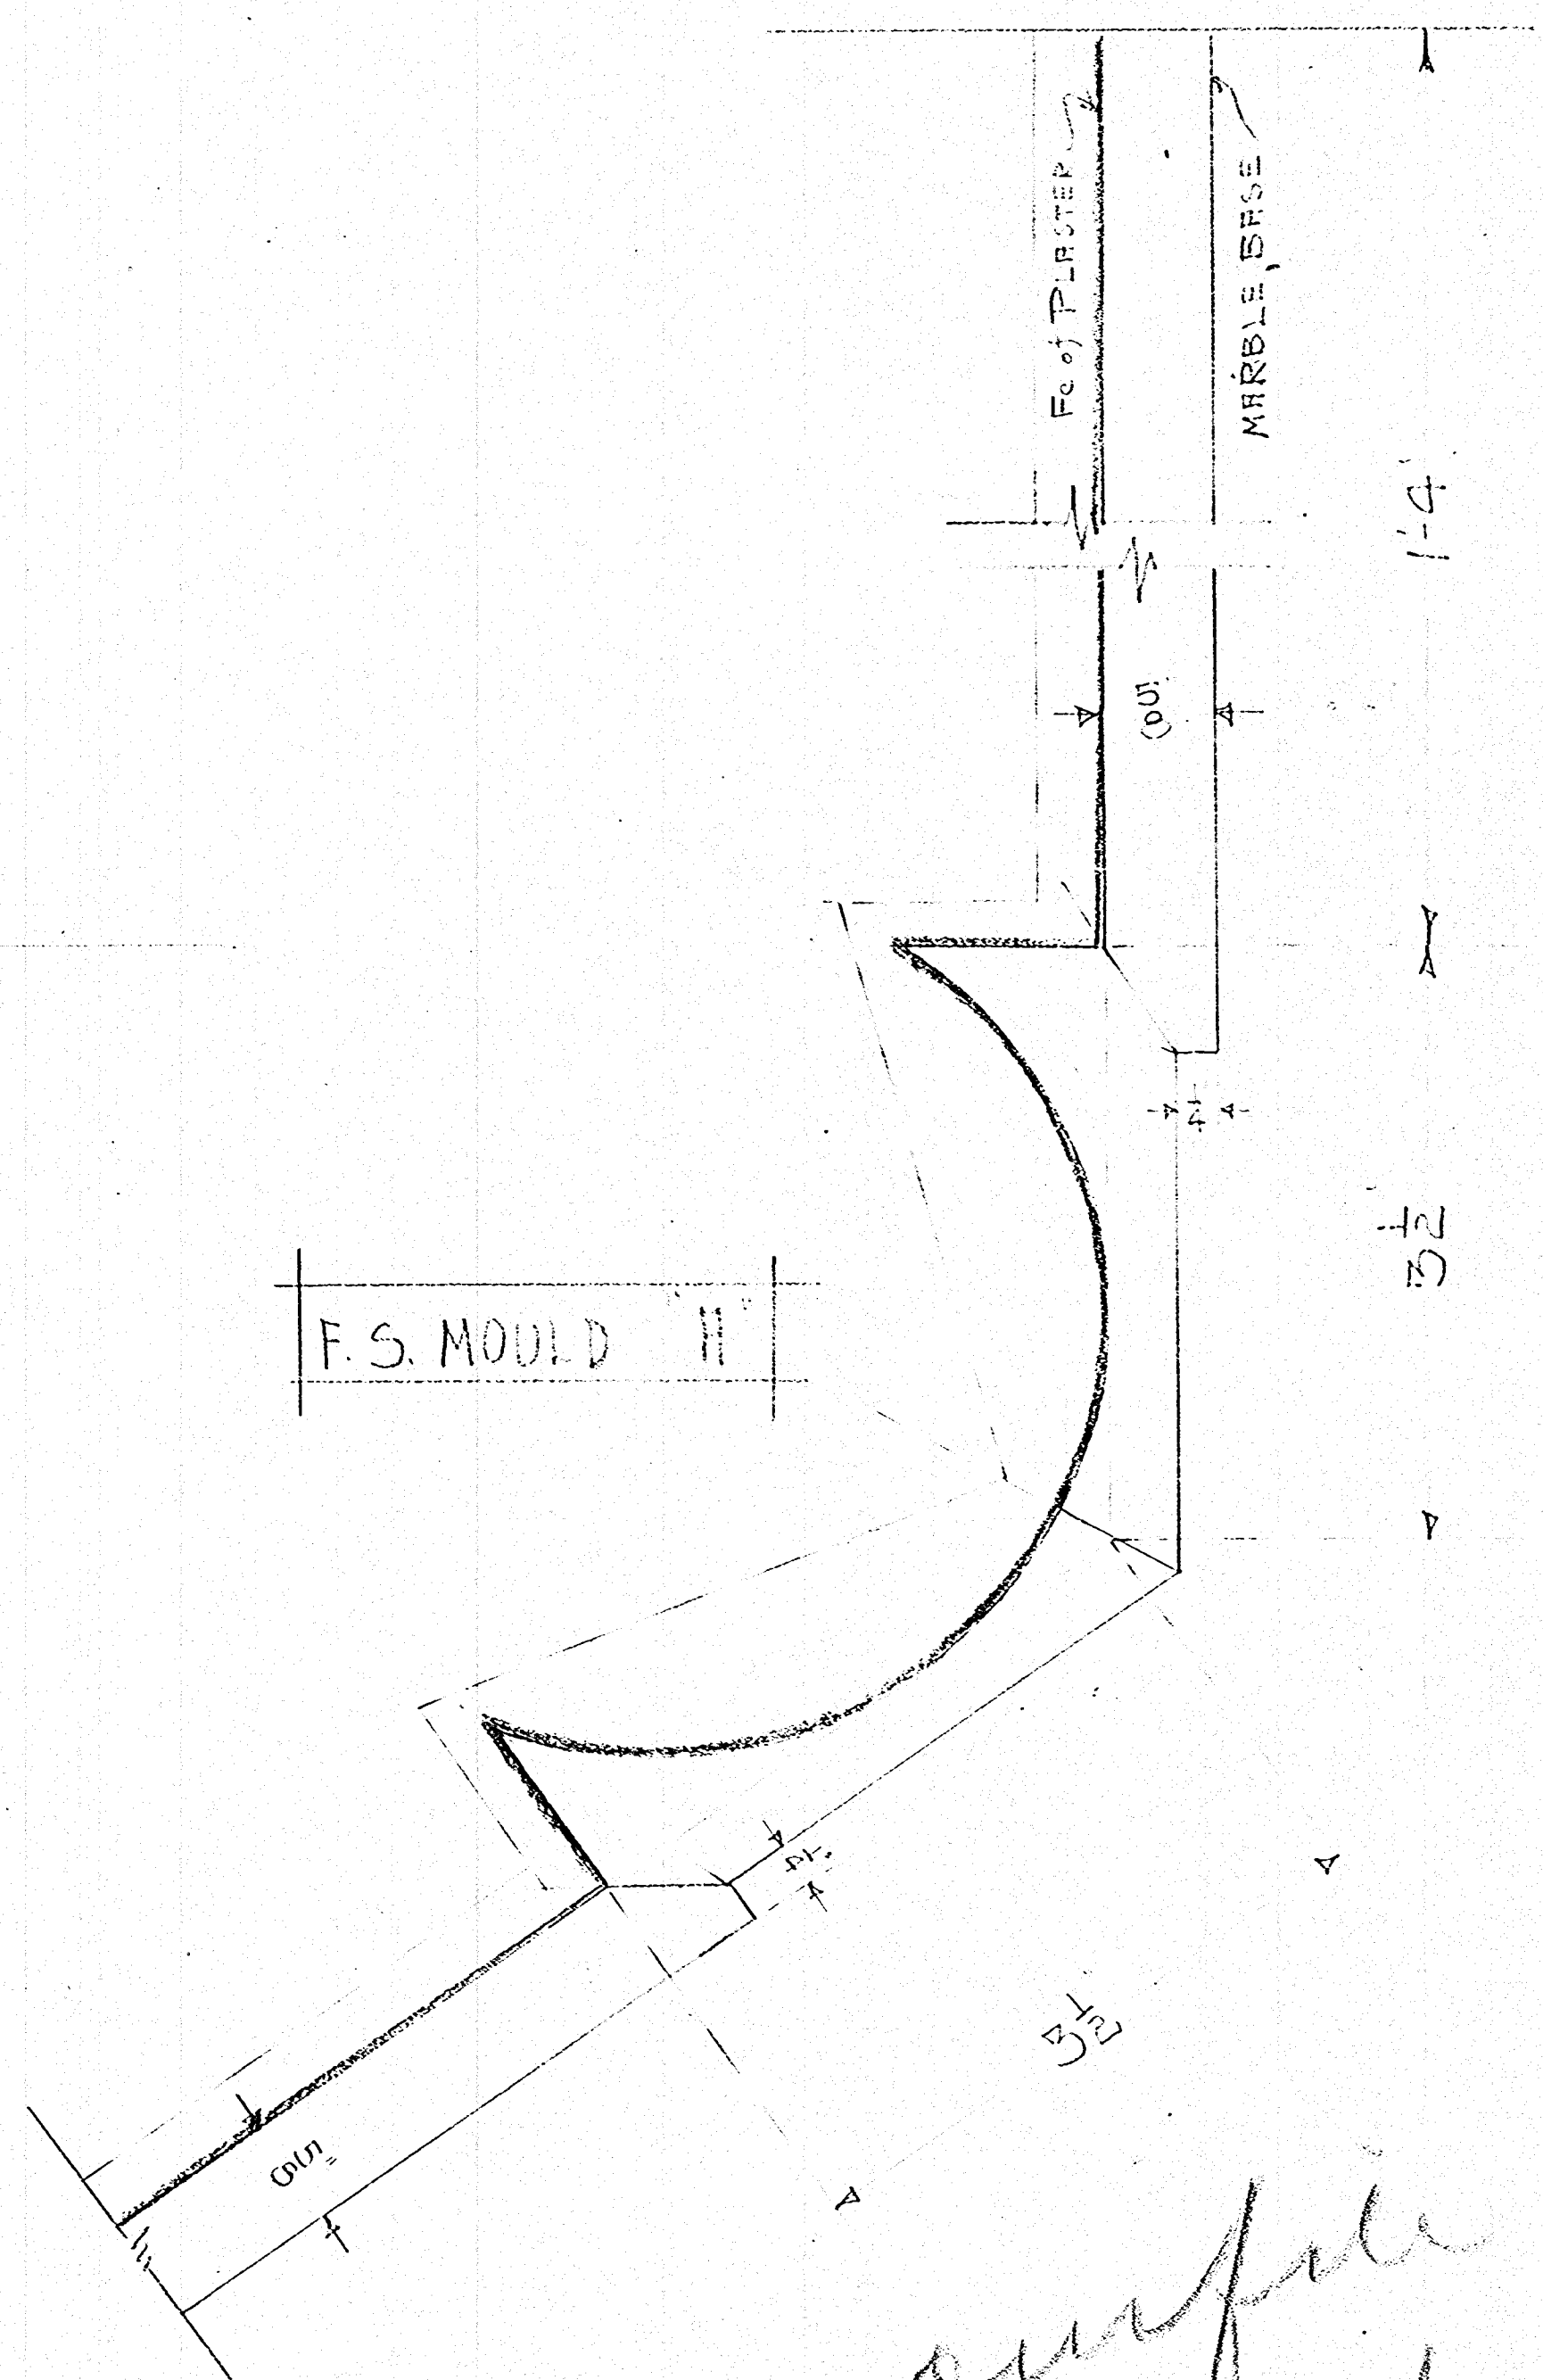

*For our file
any use*

DETAIL OF PROSCENIUM PILASTER BASES

3/10/26

SAENGER-CANAL ST. THEATER
PROSC. PILASTER BASE
GEO. J. GLOVER CO
E. WEIL, INC.
225 14-A AS NOTED
8-13-26