

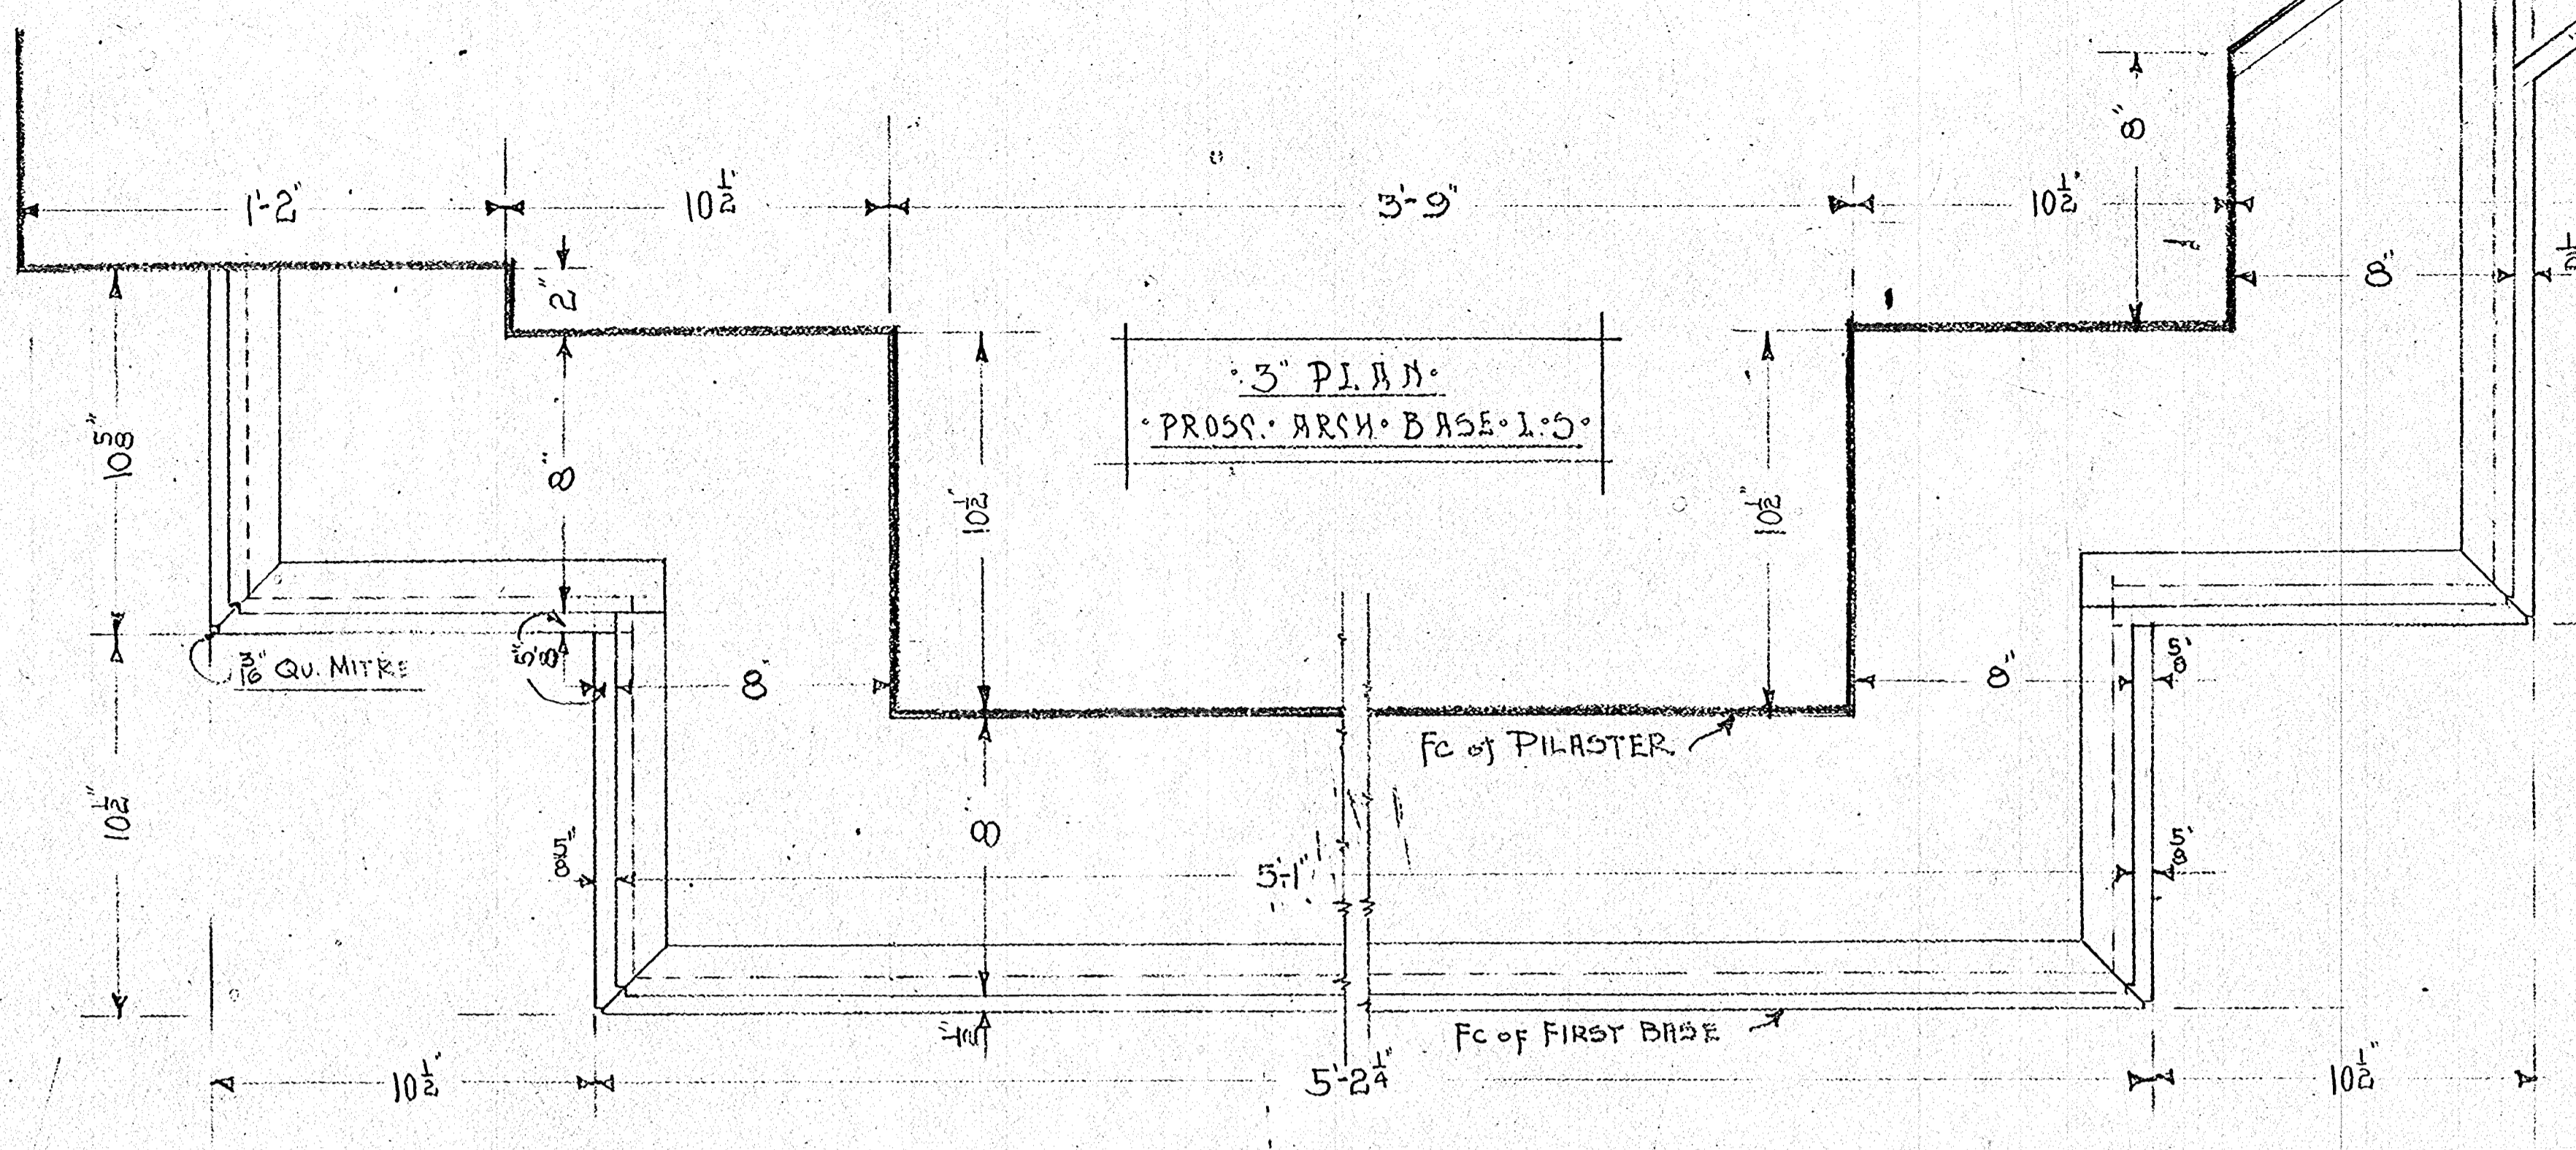


SEE DRWG # 14-A

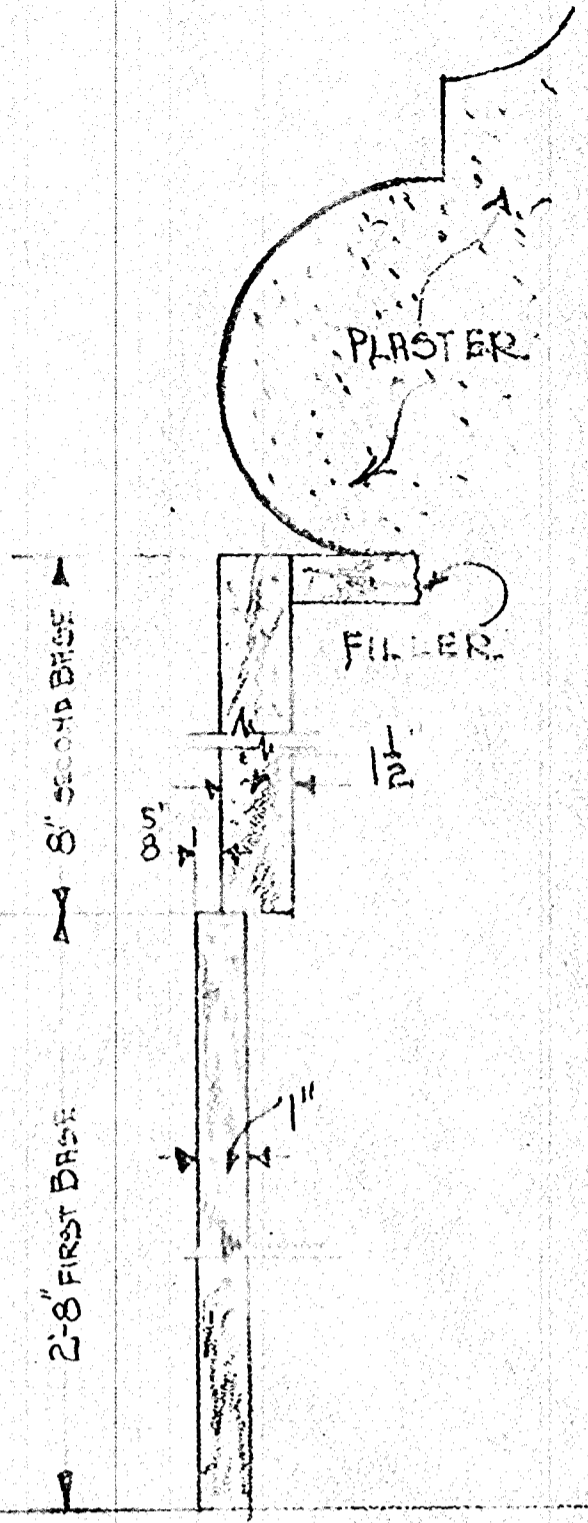

3' SECTION THRU BASE

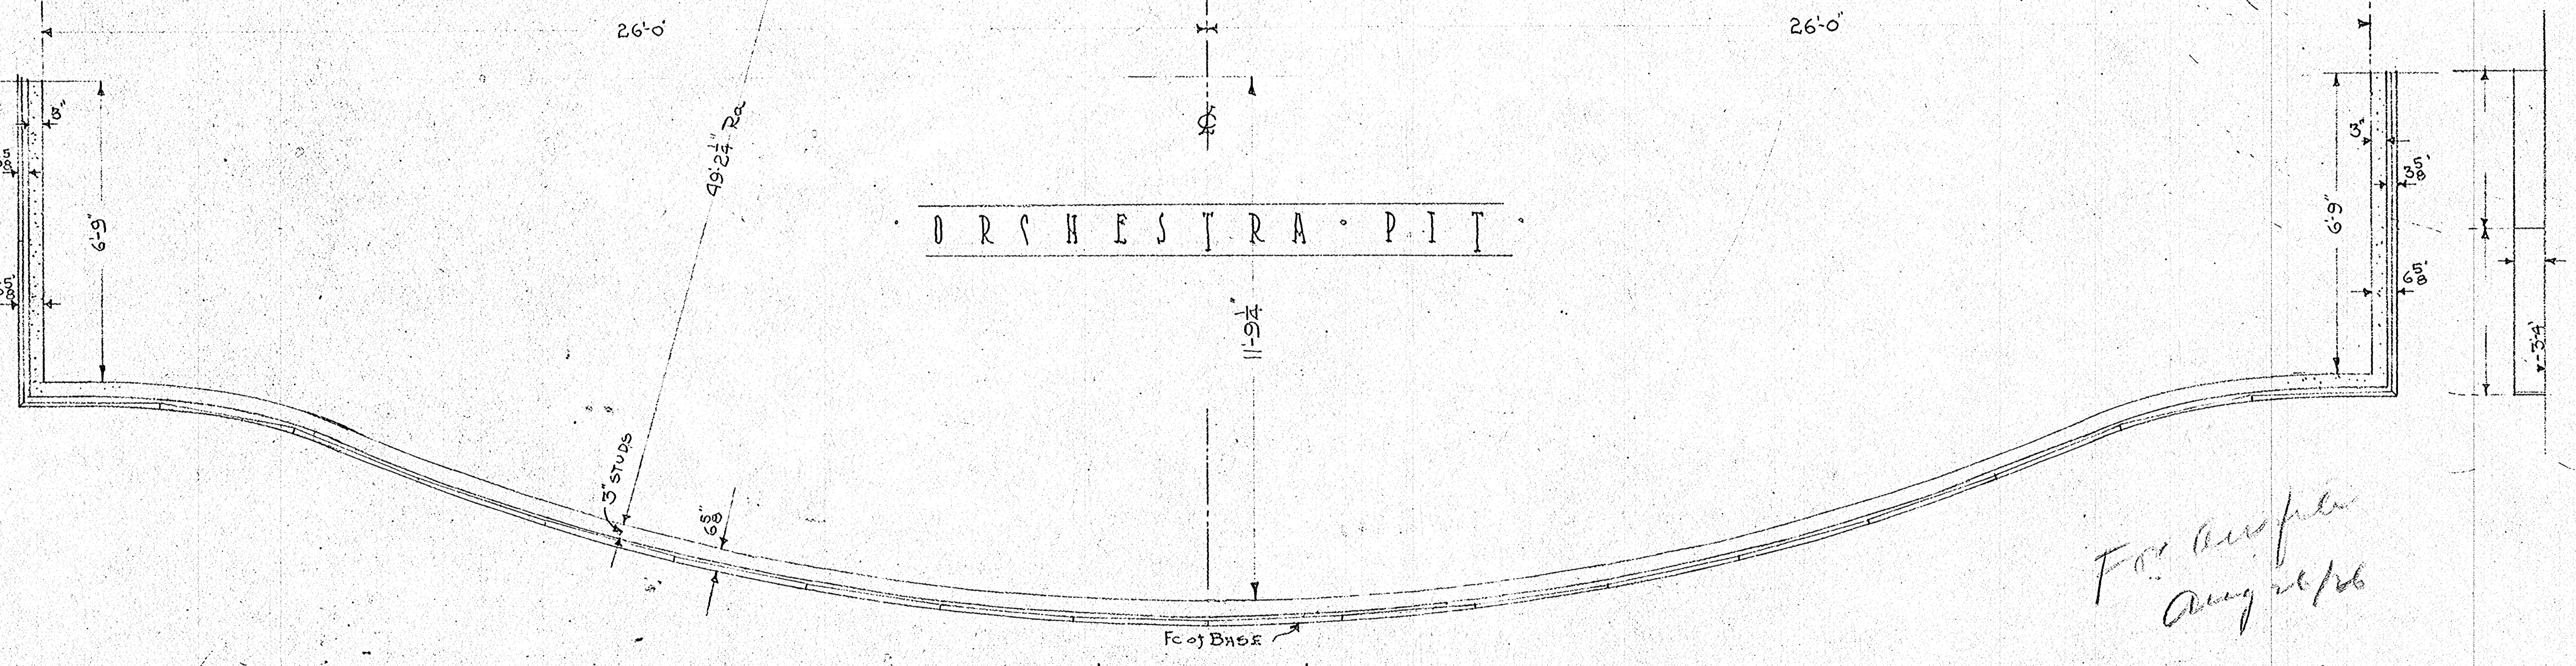

For approval Aug 26/26

PLAN

ELEVATION

ORSH. PROSS. BASE

NOTE

ALL MARBLE SHOWN TO BE ROSATO ANTISO POL. & MARKED SEE ALSO DRWG # 14-A

REVISED: 8-19-26. K.O.

APPROVED BY ARCHITECTS Date 8-20-26 T.P.C.

ALBERT WEIBLEN MARBLE & GRANITE CO.
NEW ORLEANS, LA.
JOHN SAENGER • SAAAL ST. THEATER •
ORCHESTRA BASE & PROSS. ARCH. BASE
FOR GEO. J. GLOVER CO.
ARCHT. EMILE WEIL, INC.
ORDER 225 DRAWING 14 SCALE 3/4" = 1'-0"
DEVELOPED BY Okami CHECKED DATE 7-16-26

200-5

14