



ELEVATION OF DOOR 101

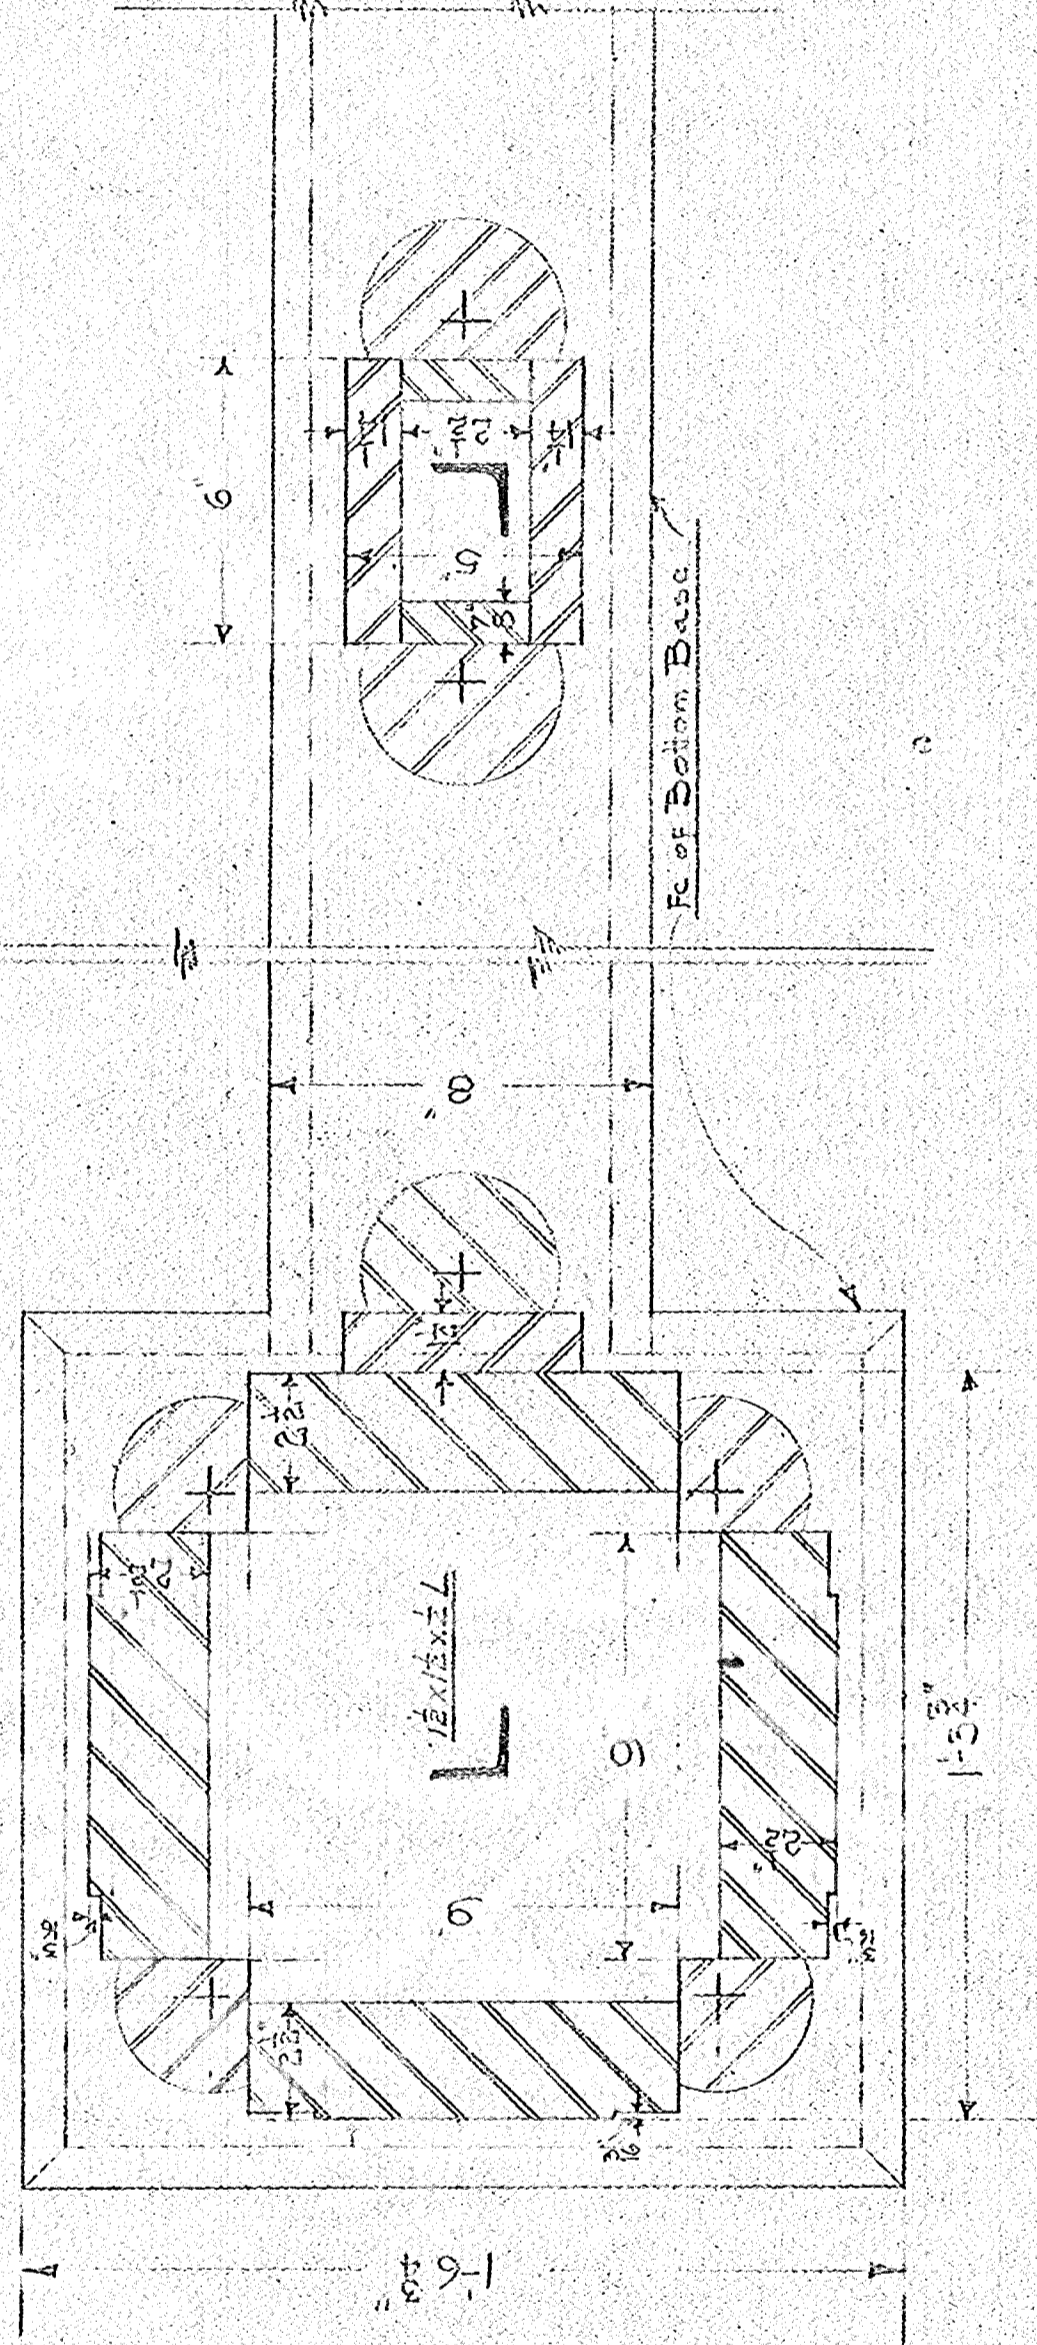

SCALE DETAILS
OF
NEWELS

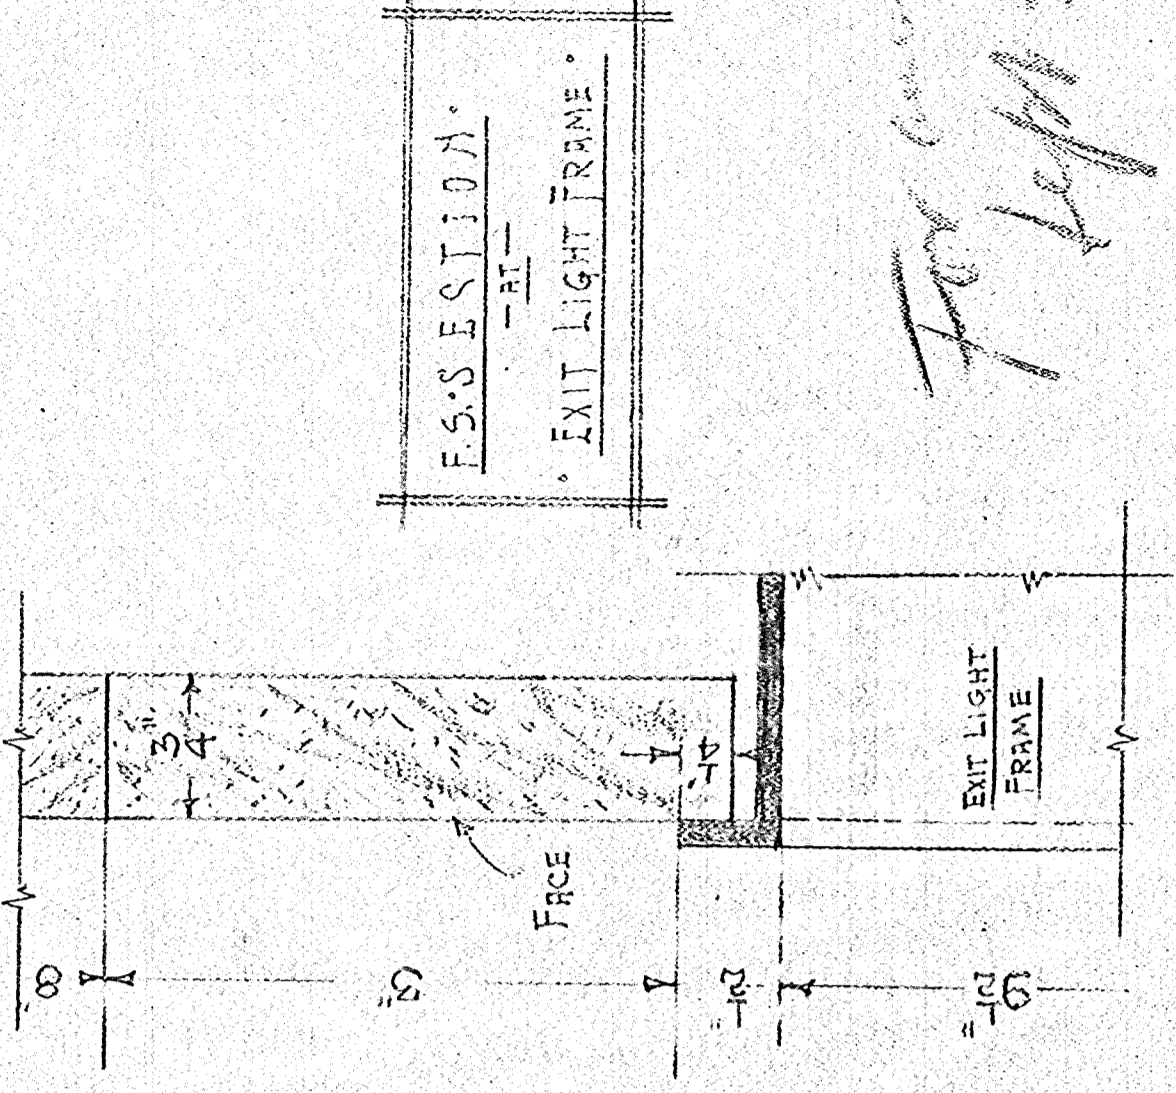

ELEVATION OF
EXIT LIGHT FRAME

*For complete
Sept 27/26*

REVISED: 9-1-26, M.C.

APPROVED
BY ARCHITECTS
DATE: 9-1-26, MARET

EXIT AT DOOR No. 101

NOTE:
ALL MARBLE FOR FLOOR, SLAB & TREADS TO BE ENGL. V. WHITE ITALIAN F.S.R.
TOP TREADS SHOWING TO BE BLACK & GOLD F.S.R.
BALUSTERS, NEWELS & BANISTER TO BE ENGL. V. WHITE ITALIAN POL.
ALL OTHER MARBLE TO BE BLACK & GOLD POL. ALL METAL FINISHES TO BE ENGL. V. WHITE ITALIAN F.S.R.

ALBERT WEISLEN MARBLE & GRANITE CO.
NEW ORLEANS, LA.
SAENGER, CANAL ST. THEATER
FOYER EXIT AT DOOR # 101.
Geo. J. GLOVER, Co.
E. WEIL, INC.
225 BROADWAY, NEW YORK, N.Y.
DATE: 8-26-26

7-R-A