


ALBERT WEISSEN MARBLE & GRANITE CO.
 NEW ORLEANS, LA.
 W.D. SRAENGER. CAMAL. ST. THEATER
 TYPICAL BALUSTERS FOYER-LOUNGE
 Geo. J. Glover. Co.
 ARCHT. E. WEIL, INC.
 DRAWN 225 DRAWING 15 SCALE F.S.
 REVISED BY OTHERS CHECKED DATE 8-12-26

APPROVED
 8-16-26 P.P.C.

F.S. SECTION
 THRU
 BALUSTER
 FOYER & LOUNGE

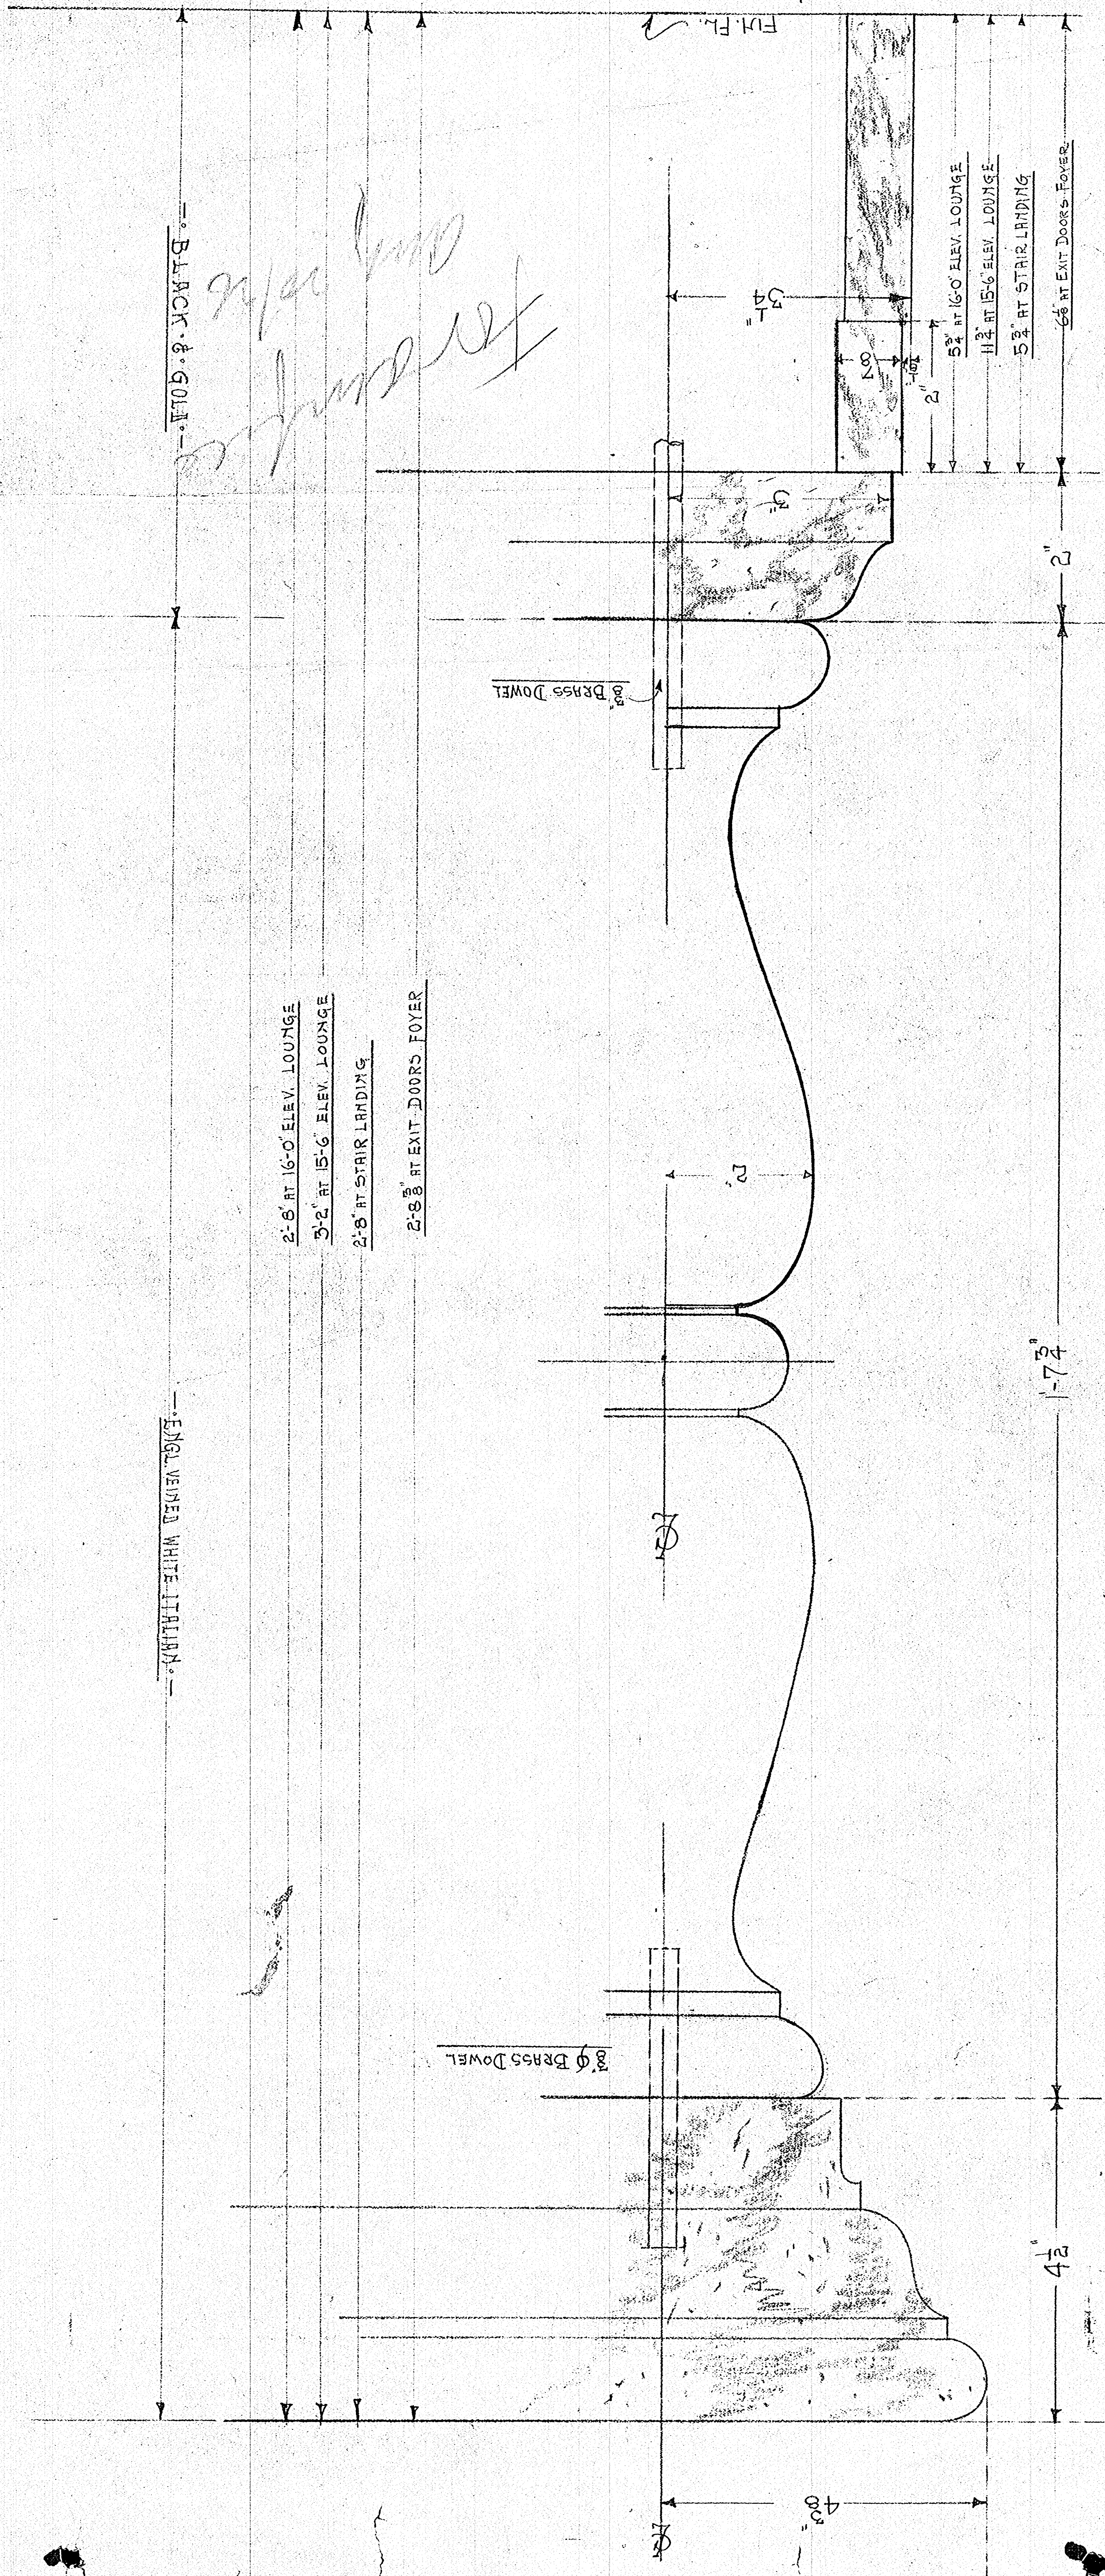

Handwritten: for balusters
 and 1/2" 1/2"

BLACK & GOLD

2'-6" AT 16'-0" ELEV. LOUNGE
 3'-2" AT 15'-6" ELEV. LOUNGE
 2'-8" AT STAIR LANDING
 2'-8" AT EXIT DOORS FOYER

ENGL VEINED WHITE ITALIAN

3" BRASS DOWEL

3" BRASS DOWEL

FULL FL.

1-7 1/2"

4 1/2"

4 3/4"

5 1/4" AT 16'-0" ELEV. LOUNGE
 11 1/4" AT 15'-6" ELEV. LOUNGE
 5 3/4" AT STAIR LANDING
 6 1/2" AT EXIT DOORS FOYER

2"

3 1/4"

2"

1 1/2"

1 1/2"

