


IBERVILLE

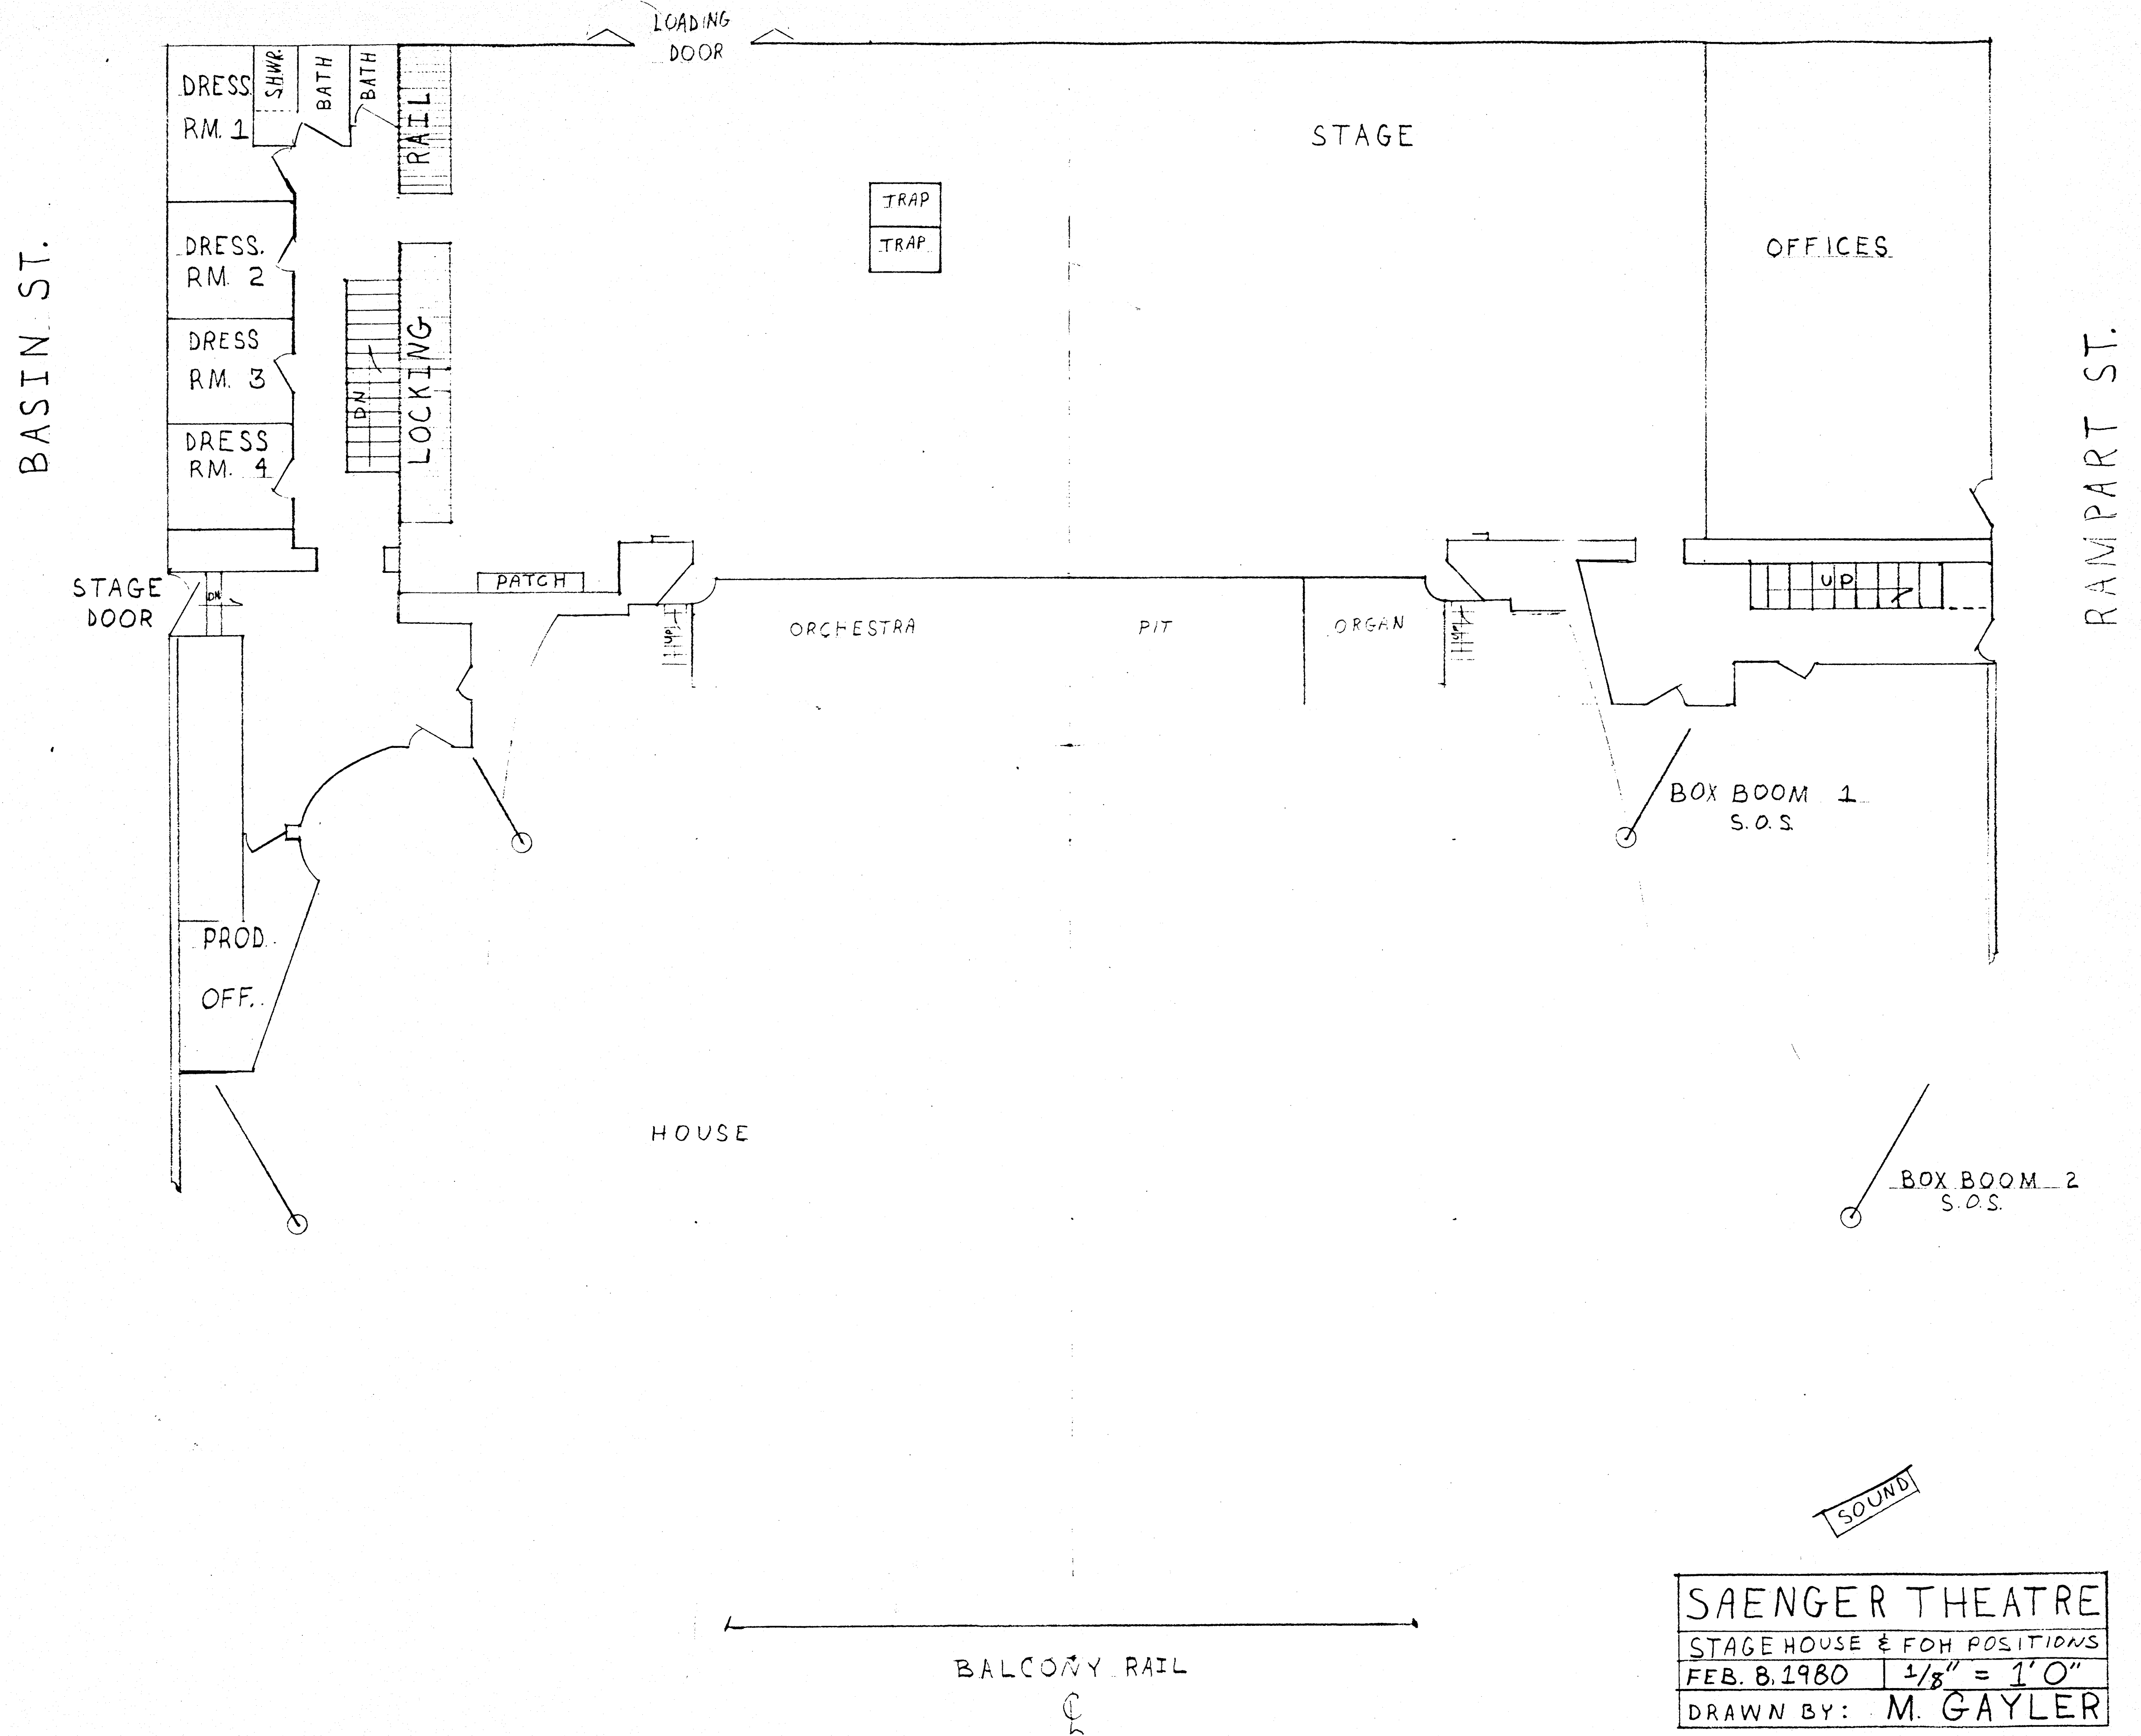

SOUND

| | |
|-----------------------------|-------------|
| SAENGER THEATRE | |
| STAGE HOUSE & FOH POSITIONS | |
| FEB. 8, 1980 | 1/8" = 1'0" |
| DRAWN BY: M. GAYLER | |

BALCONY RAIL