


VICINITY MAP
N. T. S.

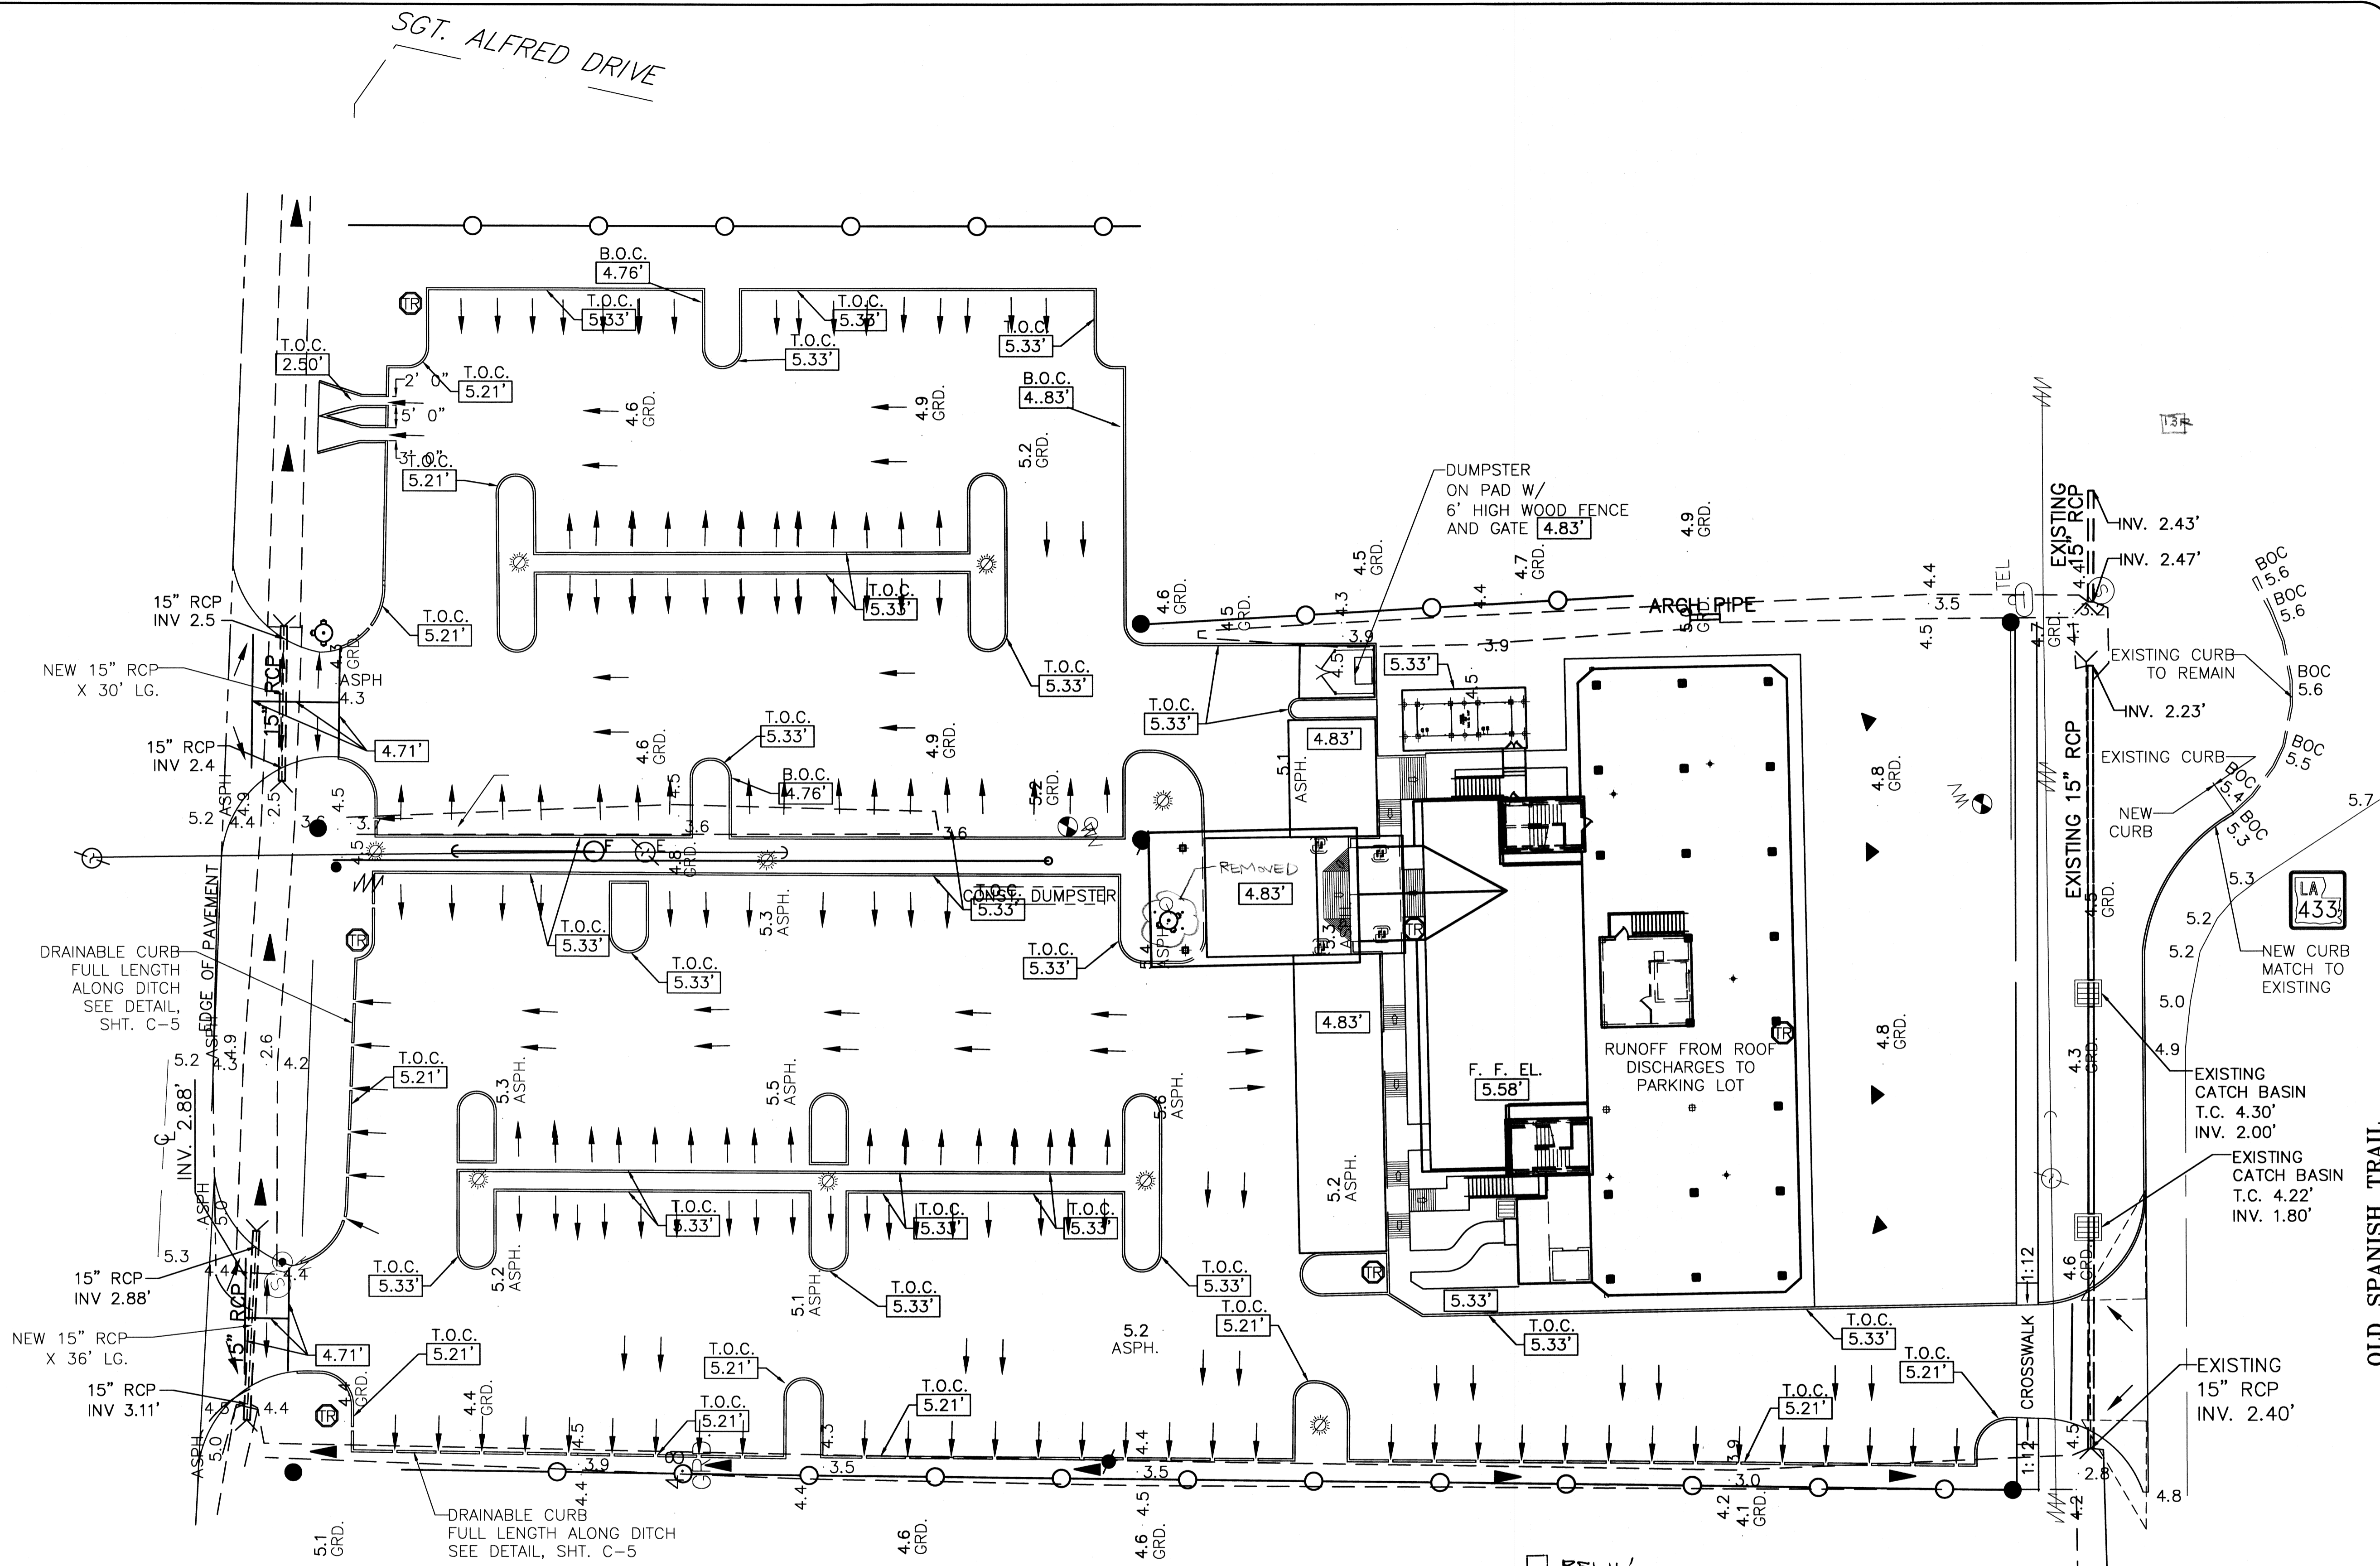

DRAINAGE PLAN

SCALE: 1"=20'-0"
NOTE: SEE DWG. C-5 FOR PAVING DETAILS.

LEGEND

- PROPERTY LINE
- SETBACK LINE
- NEW BUILDING
- NEW CURB
- T.O.C. --- TOP OF CURB
- B.O.C. --- BOTTOM OF CURB
- F.F. --- FINISHED FLOOR
- PSF --- POUNDS PER SQUARE FOOT
- [Symbol] --- EXISTING CATCH BASIN
- [Symbol] --- TEMPORARY SILT FENCE
- x4.4 --- EXISTING ELEVATIONS
- [X.X'] --- NEW ELEVATION
- [Symbol] --- DIRECTIONAL FLOW

REVISED: 03-07-07ob


CONTRACT SET- 10/10/07

DRAINAGE PLAN

ST. TAMMANY PARISH ADMIN. COMPLEX
520 OLD SPANISH TRAIL
SLIDELL, LOUISIANA

RENOVATE OFFICE BUILDING

DAMMON ENGINEERING, INC.
1096 FLORIDA AVENUE 985-649-5832 SLIDELL, LA. 70458
DAMMONENGINEERING.COM

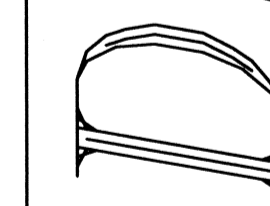

SCALE: 1"=20'

FILE:

JOB NO. 1729

DATE: 1-12-07

SHEET

C-4

OF