


SGT. ALFRED DRIVE

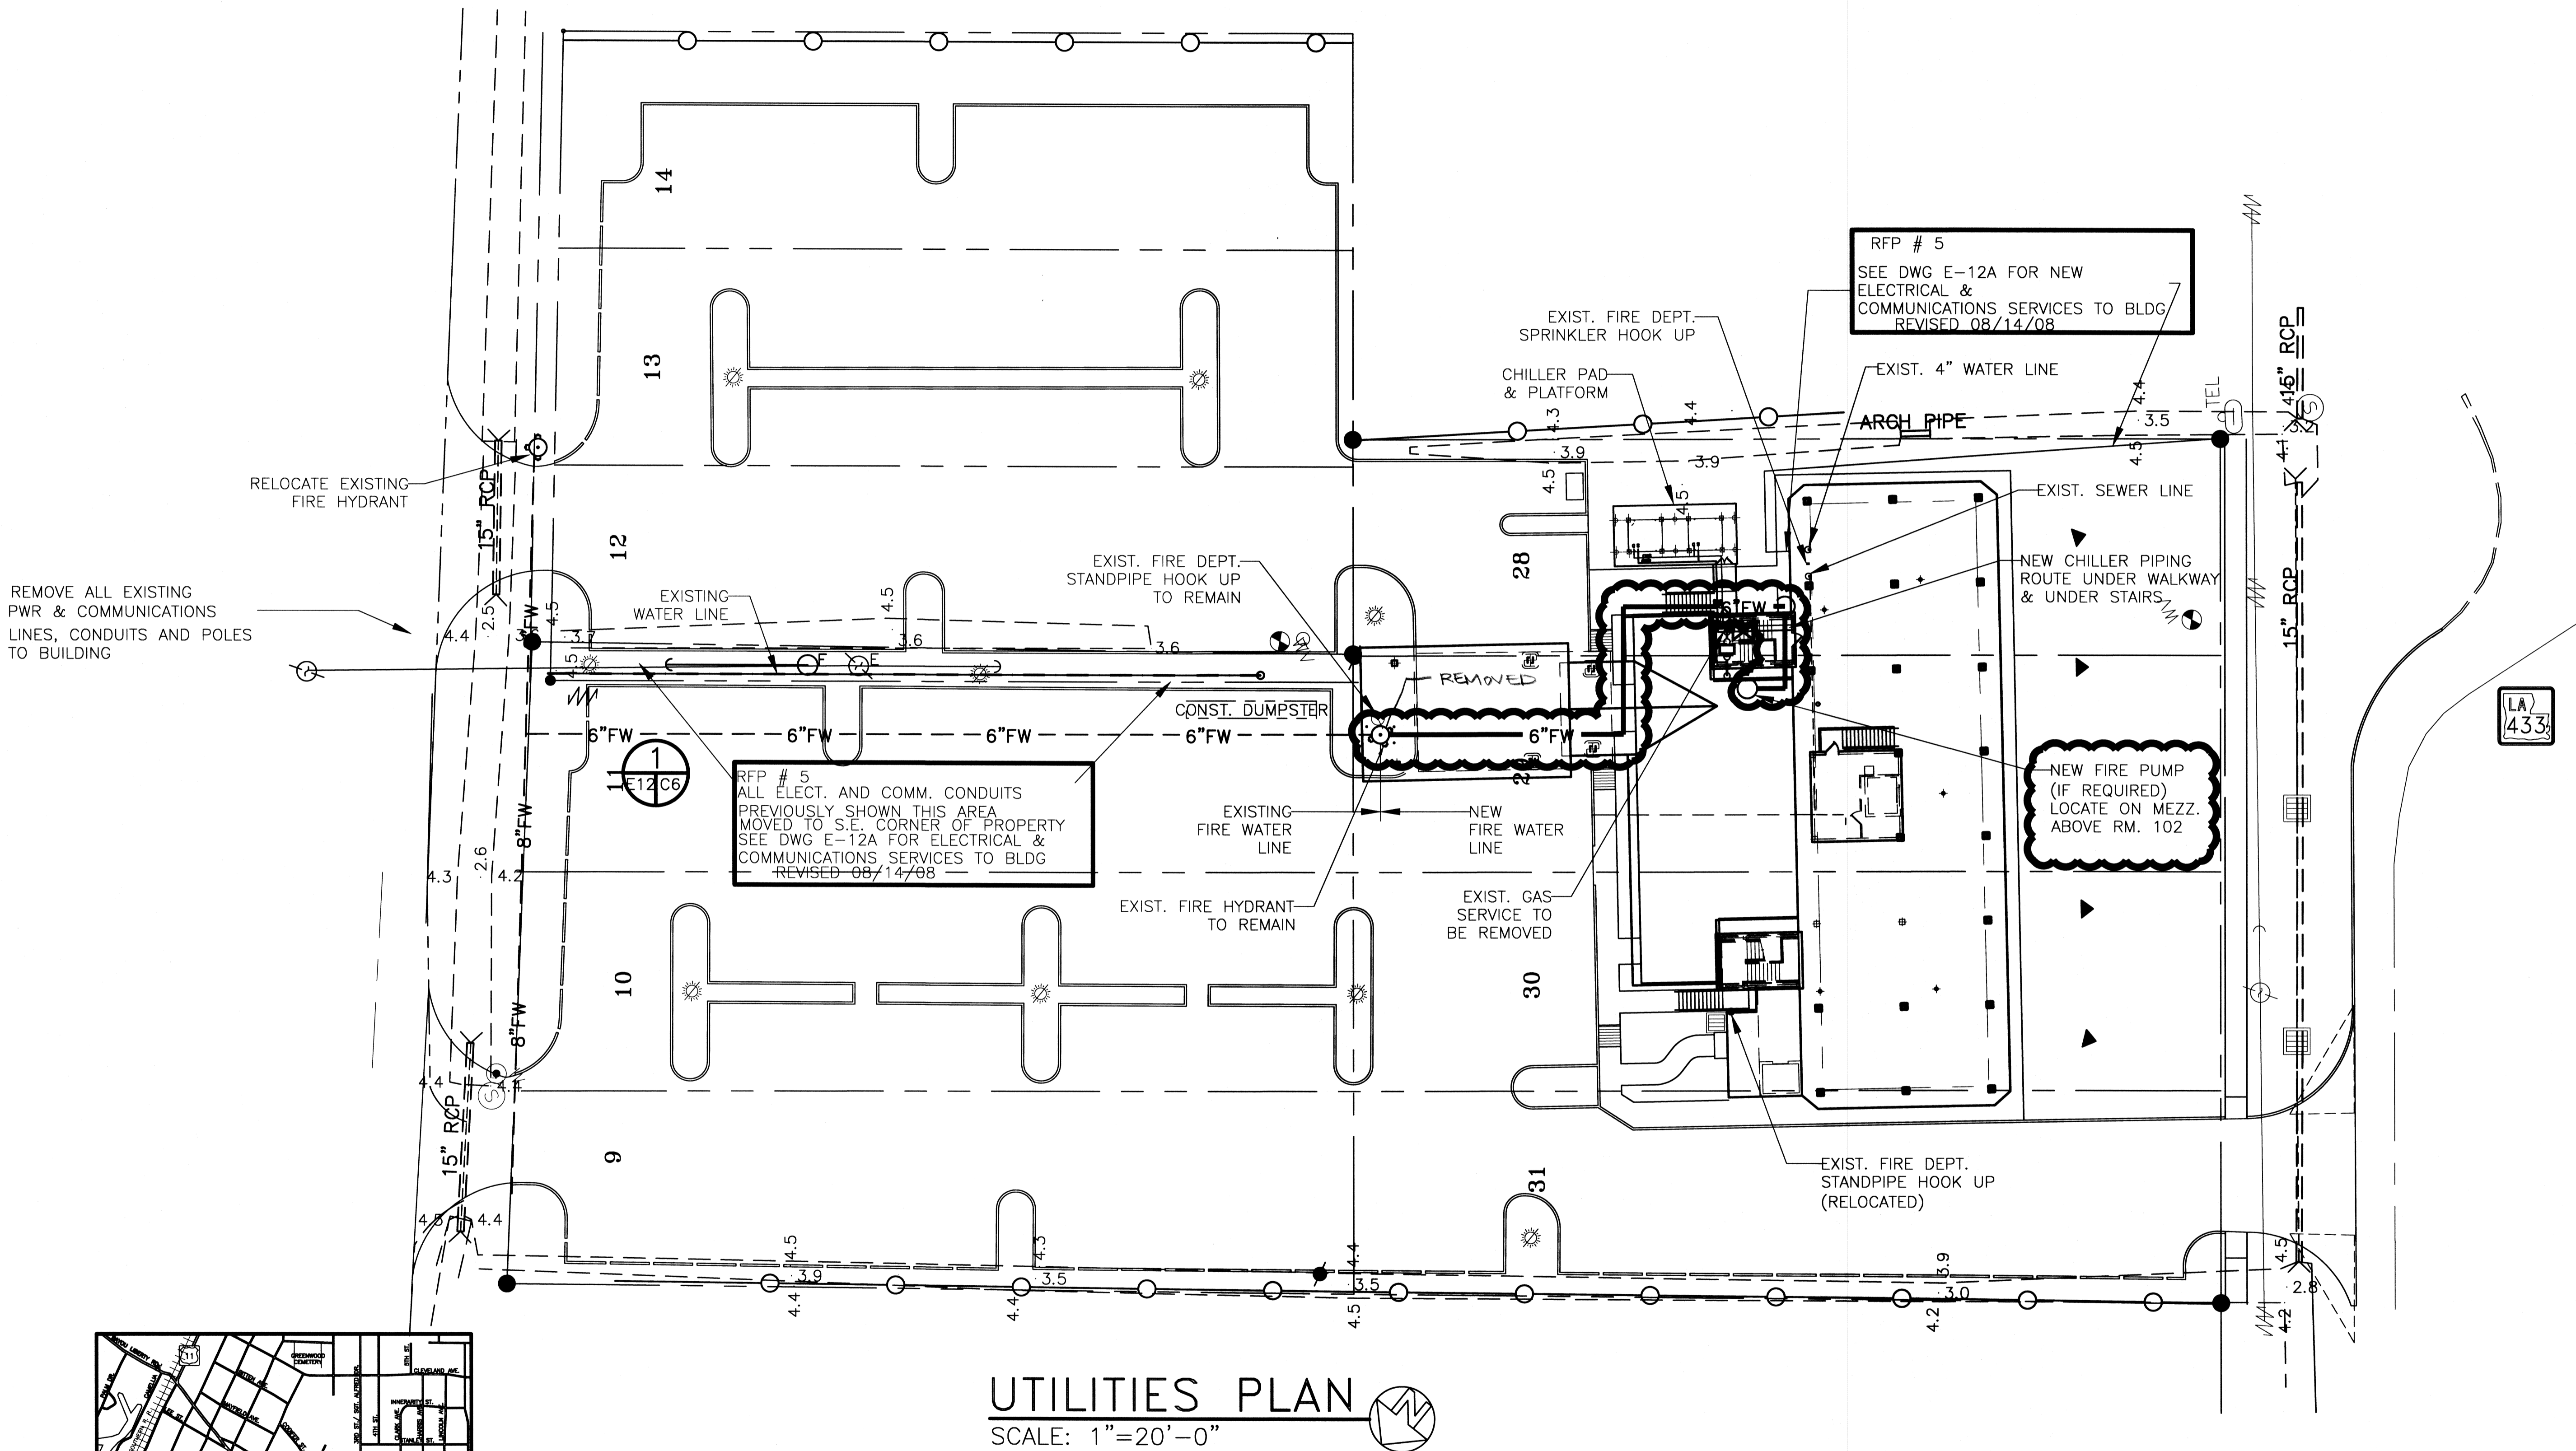


REMOVE ALL EXISTING PWR & COMMUNICATIONS LINES, CONDUITS AND POLES TO BUILDING

RELOCATE EXISTING FIRE HYDRANT

RFP # 5
ALL ELECT. AND COMM. CONDUITS
PREVIOUSLY SHOWN THIS AREA
MOVED TO S.E. CORNER OF PROPERTY
SEE DWG E-12A FOR ELECTRICAL &
COMMUNICATIONS SERVICES TO BLDG
REVISED 08/14/08

RFP # 5
SEE DWG E-12A FOR NEW
ELECTRICAL &
COMMUNICATIONS SERVICES TO BLDG
REVISED 08/14/08

NEW FIRE PUMP
(IF REQUIRED)
LOCATE ON MEZZ.
ABOVE RM. 102

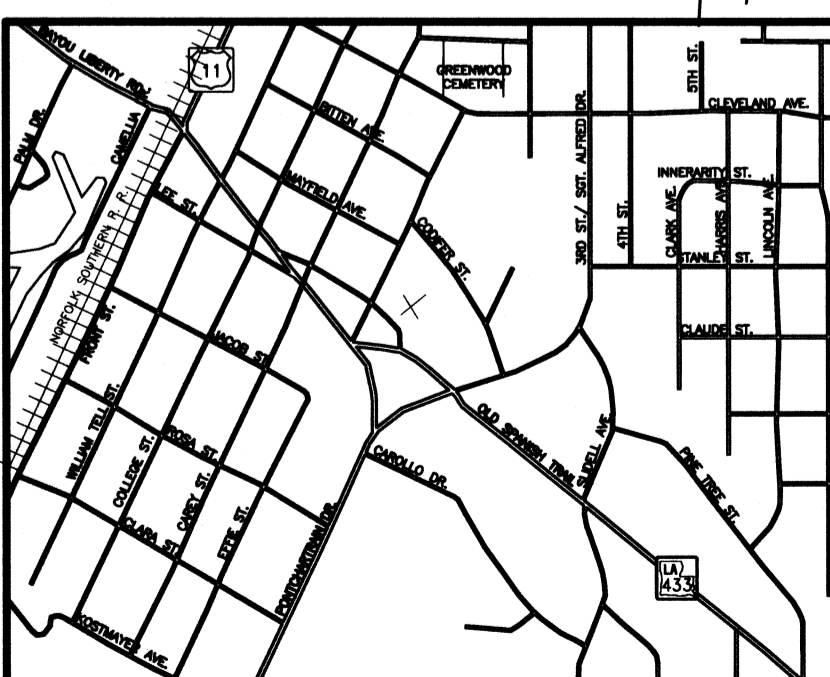

VICINITY MAP
N. T. S.

UTILITIES PLAN
SCALE: 1"=20'-0"



= ADDENDUM 7 CHANGE

REVISD: 03-07-07ab
ADDENDUM 7 REVISD: 08-20-07ab
REVISD: 03-07-07ab

UTILITIES PLAN
ST. TAMMANY PARISH ADMIN COMPLEX
520 OLD SPANISH TRAIL
SLIDELL, LOUISIANA

RENOVATE OFFICE BUILDING
DAMMON ENGINEERING, INC.
1095 FLORIDA AVENUE 985-649-5832 SLIDELL, LA. 70458
DAMMONENGINEERING.COM

SCALE: 1"=20'
FILE:
JOB NO. 1729
DATE: 1-8-07

SHEET
C-6A
OF