


NOTE : AREA INSIDE CLOUD ; FILL AREA AFTER DEMO OF PARKING AREA & SOD ONLY. THIS AREA WILL BE COMPLETED BY OTHERS LEAVE TREES ETC.

LA 433


LANDSCAPING PLAN
SCALE: 1"=20'-0"

LEGEND


- CENTERLINE OF ROAD
- PROPERTY LINE
- NEW BUILDING
- EXISTING FENCE LINE
- SETBACK LINE
- — CRAPE MYRTLE
- — SHUMARD OAK
- — LARGE CAMELLIA
- — HORN BEAM
- — SHRUB
- — SEASONAL COLOR BED
- — SHRUB BED

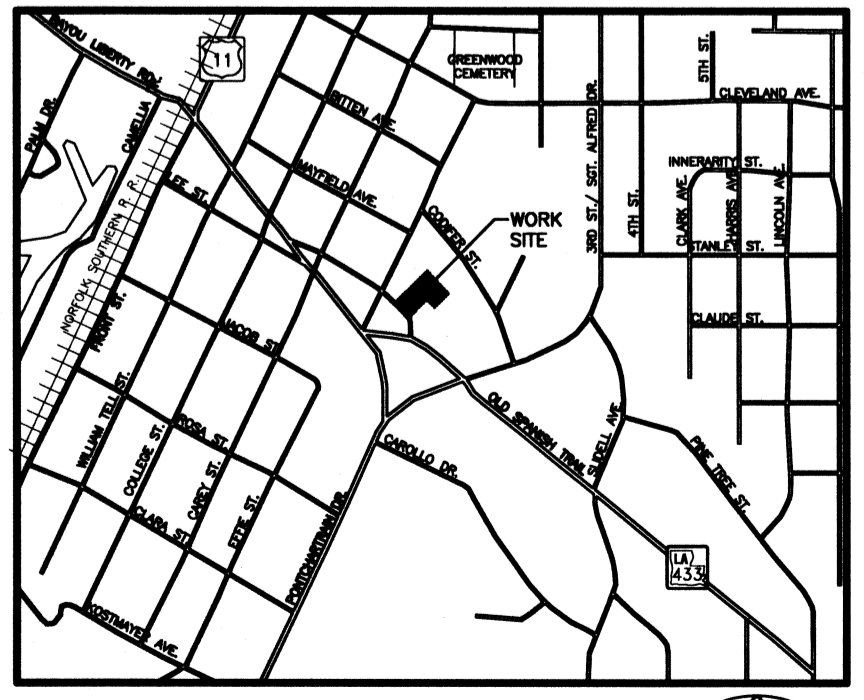


VICINITY MAP
N. T. S.

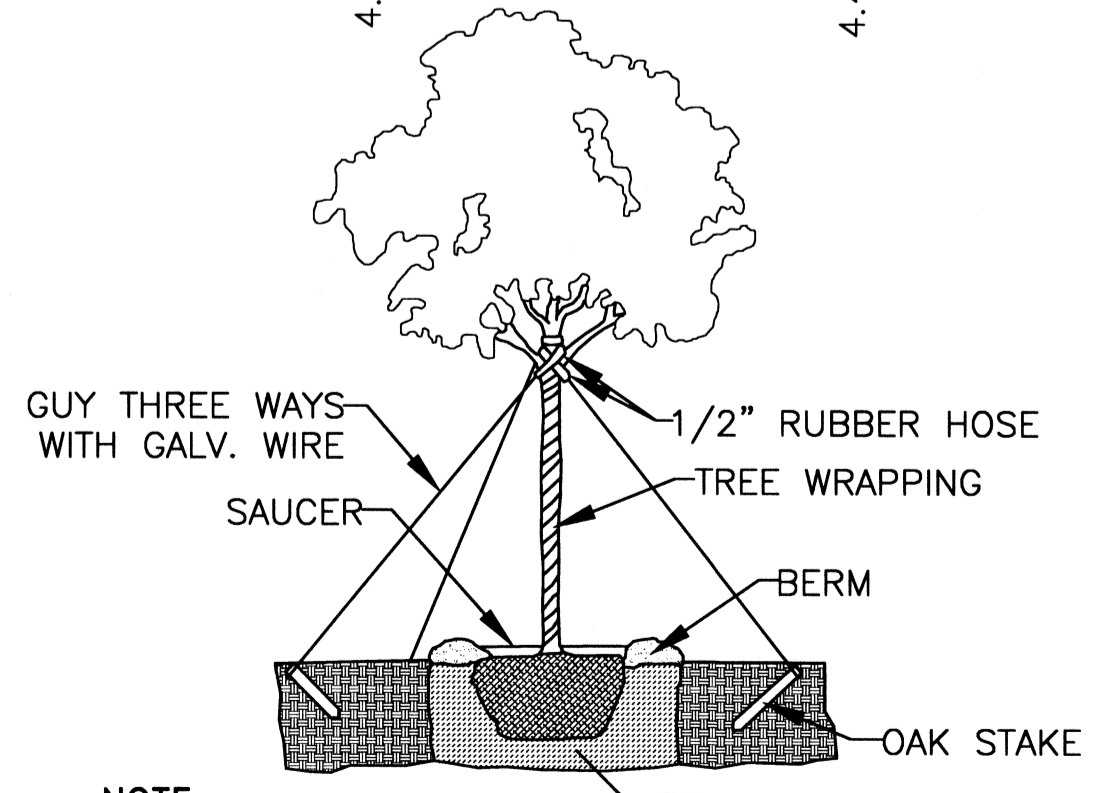

TYPICAL TREE PLANTING DETAIL
N. T. S.

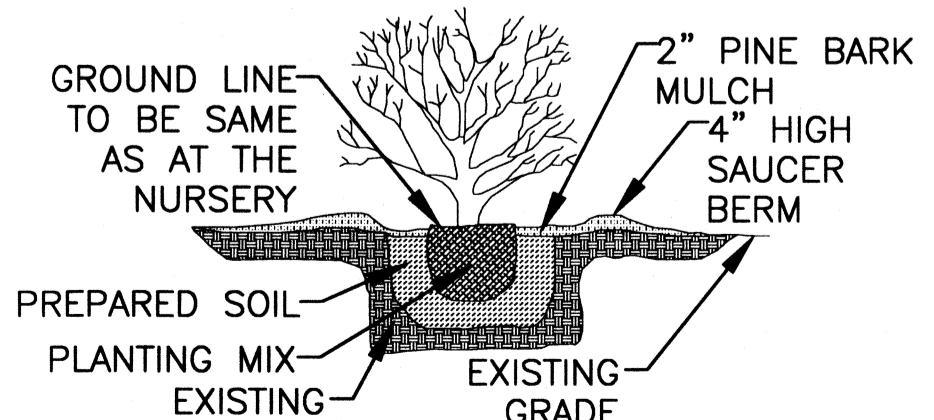

SHRUB DETAIL
N. T. S.

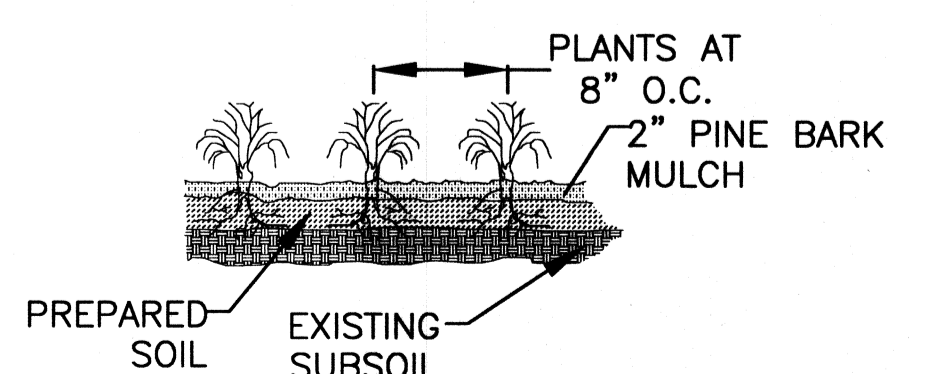

GROUND COVER DETAIL
N. T. S.

NOTE: PROVIDE SERVICES OF LAWN SPRINKLER CO. TO DESIGN & INSTALL LAWN SPRINKLER SYSTEM FOR ENTIRE SITE, EXCLUDING DITCH AREAS.

LANDSCAPING PLAN
ST. TAMMANY PARISH OFFICE BUILDING
520 OLD SPANISH TRAIL
SLIDELL, LOUISIANA

RENOVATE OFFICE BUILDING
DAMMON ENGINEERING, INC.
1095 FLORIDA AVENUE 985-649-5832 SLIDELL, LA. 70458
DAMMONENGINEERING.COM

SCALE: 1"=20'
FILE:
JOB NO. 1729
DATE: 1-8-07
SHEET
L-1
OF

REVISED: 02/19/07
CONTRACT SET- 10/10/07