


CLOSE THE OPENING WITH LIGHT GAUGE METAL FRAME AND SHEATHING TO MATCH EXISTING ELEVATOR TOWER

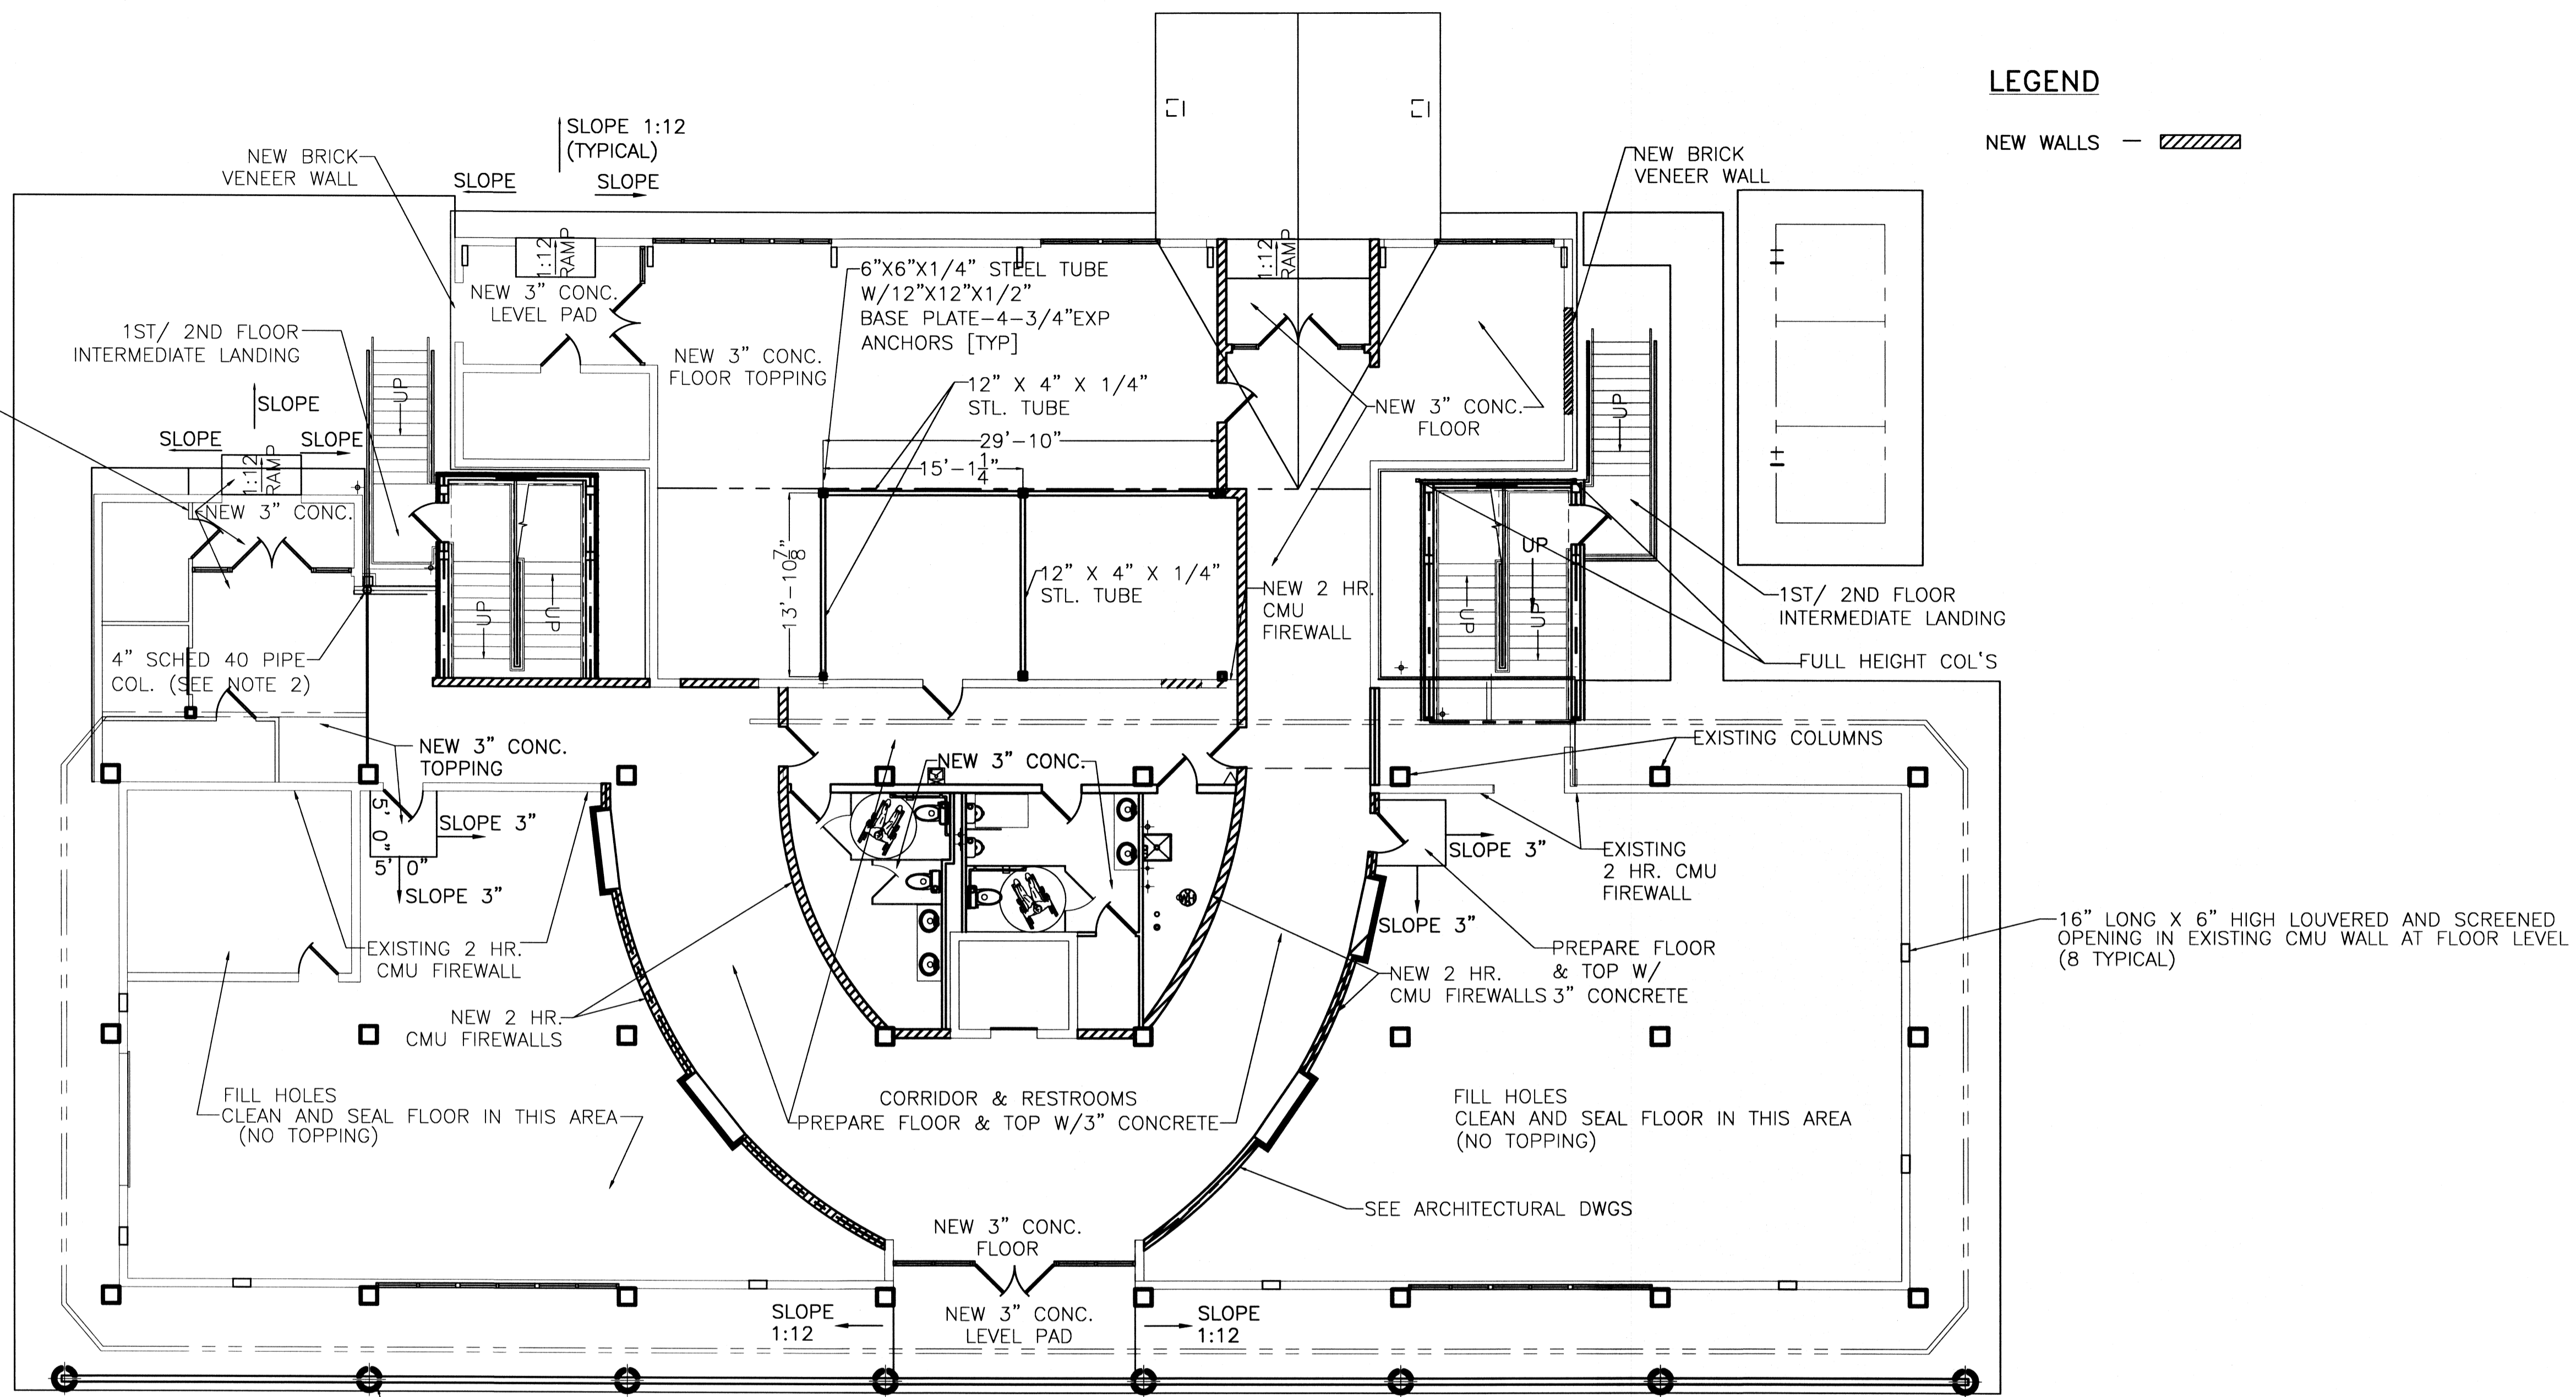

LEGEND

NEW WALLS - [Hatched Pattern]

FIRST FLOOR STRUCTURAL PLAN

SCALE: 1/8" = 1'-0"

NEW COLUMNS, BEAMS & ROOF- SEE SHT. A-1

NOTES:

- ELEVATOR CONTRACTOR SHALL RELOCATE 1ST FLOOR STOPS TO ACCOUNT FOR RAISING FLOOR 3".
- INSTALL 4" SCHEDULE 40 PIPE COLUMN W/ 6" X 8" X 1/4" PLATE T & B @ FLOORS 1 THRU 6 TO SUPPORT EXISTING HORIZONTAL WF BEAM PRESENTLY ATTACHED TO VERTICAL COLUMN AT EXTERIOR OF WALL. WELD NEW COLUMN TO BOTTOM OF EXISTING BEAM ABOVE. REMOVE EXTERIOR COLUMN, TRIM BEAM TO WALL AND ADD NEW SIDING TO MATCH. PATCH INTERIOR WALL (4 LAYERS OF 5/8" GYPSUM W/ GYP. BOARD).
- ALL MISC. STEEL SHALL BE ASTM A36.

[Cloud Symbol] = ADDENDUM 7 CHANGE

ADDENDUM 7 REVISED: 08/20/07ab
 REVISED: 05/21/07
 REVISED: 03/07/07

RENOVATE OFFICE BUILDING

1ST FLOOR STRUCTURAL PLAN

ST. TAMMANY PARISH ADMIN. COMPLEX
 520 OLD SPANISH TRAIL
 SLIDELL, LOUISIANA

DAMMON ENGINEERING, INC.
 1095 FLORIDA AVENUE 985-649-5832 SLIDELL, LA. 70458
 DAMMONENGINEERING.COM

SCALE: AS NOTED

FILE:

JOB NO. 1729

DATE: 1-8-07

SHEET

S - 1

OF