

NOTE: KITCHEN CABINETS SHALL BE MEDIUM COMMERCIAL GRADE, FACTORY BUILT. COUNTER TOPS SHALL BE MANMADE MARBLE OR EQUAL.

NOTE: INSTALL DUCTWORK ENTRANCES AS REQUIRED. SEE DWG. M-3 FOR A/C DETAILS.

SEE DWG. S-2 FOR NEW CONCRETE FLOOR, THIS AREA [TYPICAL 2 PLACES EA FLOOR]

ROOM	FINISH SCHEDULE											REMARKS					
	FLOOR	BASE	WALLS	CEILING	CLG HT												
	CONCRETE	VINYL TILE	CERAMIC TILE	PAINTED WOOD	VINYL	WOOD	NONE	PANELING	GYPSUM BOARD	GREENBOARD	PAINT	CERAMIC TILE	ACOUSTIC TILE	GYPSUM BOARD	FRP BOARD	OPEN	TEXT. CONC.
300																	
301																	
302																	

THIRD FLOOR PLAN  
 SCALE: 1/8" = 1'-0"

DOOR	DOOR & HARDWARE SCHEDULE											REMARKS													
	TYPE	FRAME	HINGE	LOCK	ACCESSORIES																				
	SOLID WOOD	HOLLOW	ALUM./GLASS	STEEL	MASONITE	STEEL	ALUMINUM	WOOD	CASED OPENING	DOUBLE SWING	BUTT 1 1/2"	PASSAGE	PRIVATEY	DEADBOLT	KEYED HANDLE	PUSH PULL	THRESHOLD	WEATHERSTRIP	DOOR STOP	ALUMEN	WIRE GLASS	VIEW GLASS			
1	3/0x7/0																							RELOCATE AS NEEDED	
2	3/0x7/0																								
3	3/0x7/0																								
4	(2) 3/0x7/0																							EXISTING TO REMAIN (GLASS)	
5	3/0x7/0																							1 HOUR RATED	
6	3/0x7/0																								
7	3/0x7/0																								
8	3/0x7/0																							STAIN & VARNISH	

DOORS SHOWN WITH ▲ SHALL BE EQUIPPED WITH ELECTRIC STRIKE FOR CARD READER  
 UNDERCUT ALL DOORS 3/4" TO ALL FOR PROPER EXHAUST AIR FLOW

WINDOW	WINDOW SCHEDULE											REMARKS											
	TYPE	FRAME	GLASS	LITES	ACCESSORIES																		
	FIXED	VERTICAL SLIDE	HORIZONTAL SLIDE	STORE FRONT	STEEL	ALUMINUM	WOOD	TINTED	PLAIN	GLAZED	WIREGLASS	NONE	2/2	4/4	6/6	8/8	LOCK	ALARM	SCREEN	SHUTTER	NONE		
A	4/0x5/0																						APPROXIMATELY 3,700 SQ. FT.
B	6/0x4/0																						SERVICE WINDOW

\*FINAL SIZES TO BE DETERMINED BY VENDOR FROM FIELD MEASUREMENTS [TYP. ALL FLOORS]

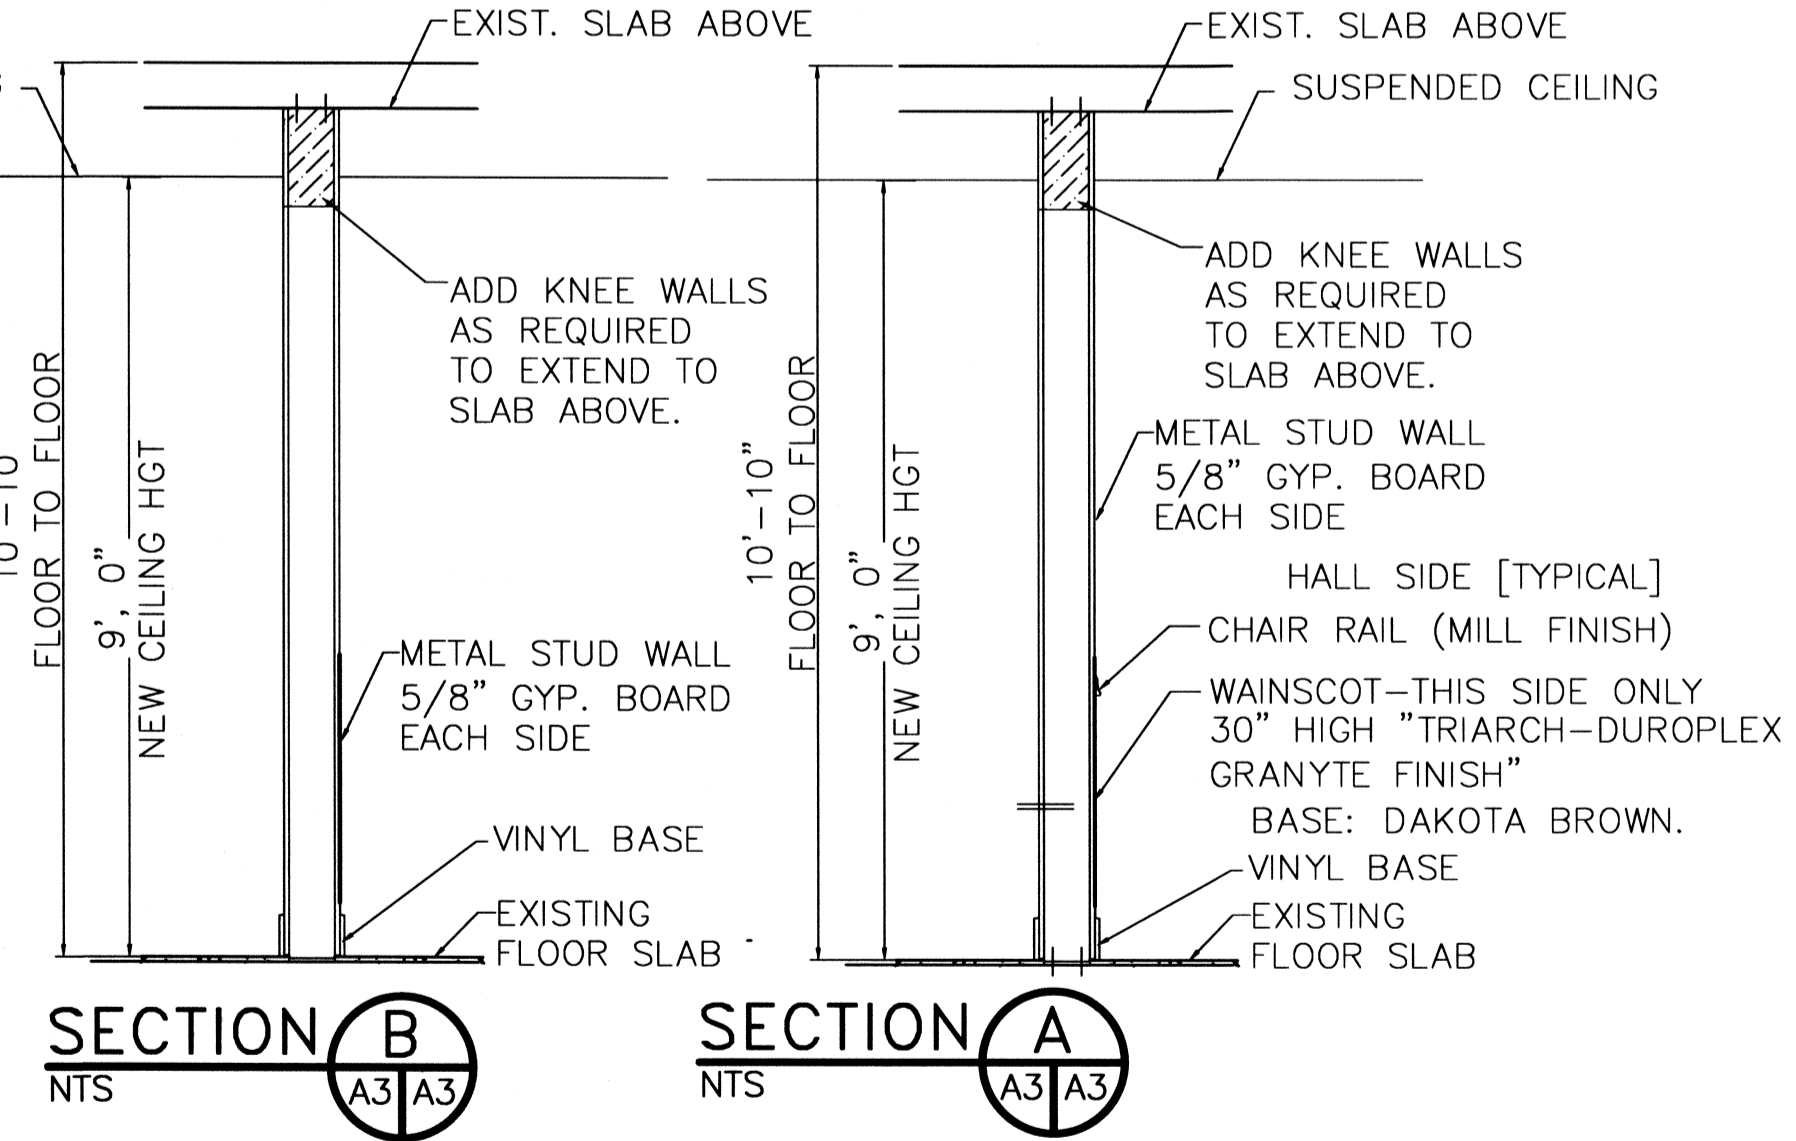

SECTION B  
 NTS

SECTION A  
 NTS

TYPICAL ONLY WHERE WALL IS NOT 9 FT. HIGH

☁ = ADDENDUM CHANGE  
 ☁ = 09/19/07 CHANGE

☐ -INDICATES AREAS CHANGED- 10/17/08

RFP 6 REVISED: 10/17/08ab  
 REVISED: 11/05/07ab  
 REVISED: 09/19/07ab  
 ADDENDUM REVISED: 08/20/07ab  
 REVISED: 05/21/07ab  
 REVISED: 05/17/07  
 REVISED: 02/19/07  
 REVISED: 01/22/07