




LEGEND

RFI #'s	NEW WALL	
CHARGE ORDER #'s	NEW 1 HOUR RATED WALL	
	EXISTING WALL	
	CURTAIN WALL	
	SECURITY ACCESS DOOR (SCANNER BY OTHERS)	
	RETURN AIR CASIED OPENING IN WALL (ROOM TO CEILING)- TO EQUAL 200 SQ. IN.	


NOTE
INSTALL DUCTWORK ENTRANCES AS REQUIRED - SEE DWG. M-8 FOR A/C DETAILS

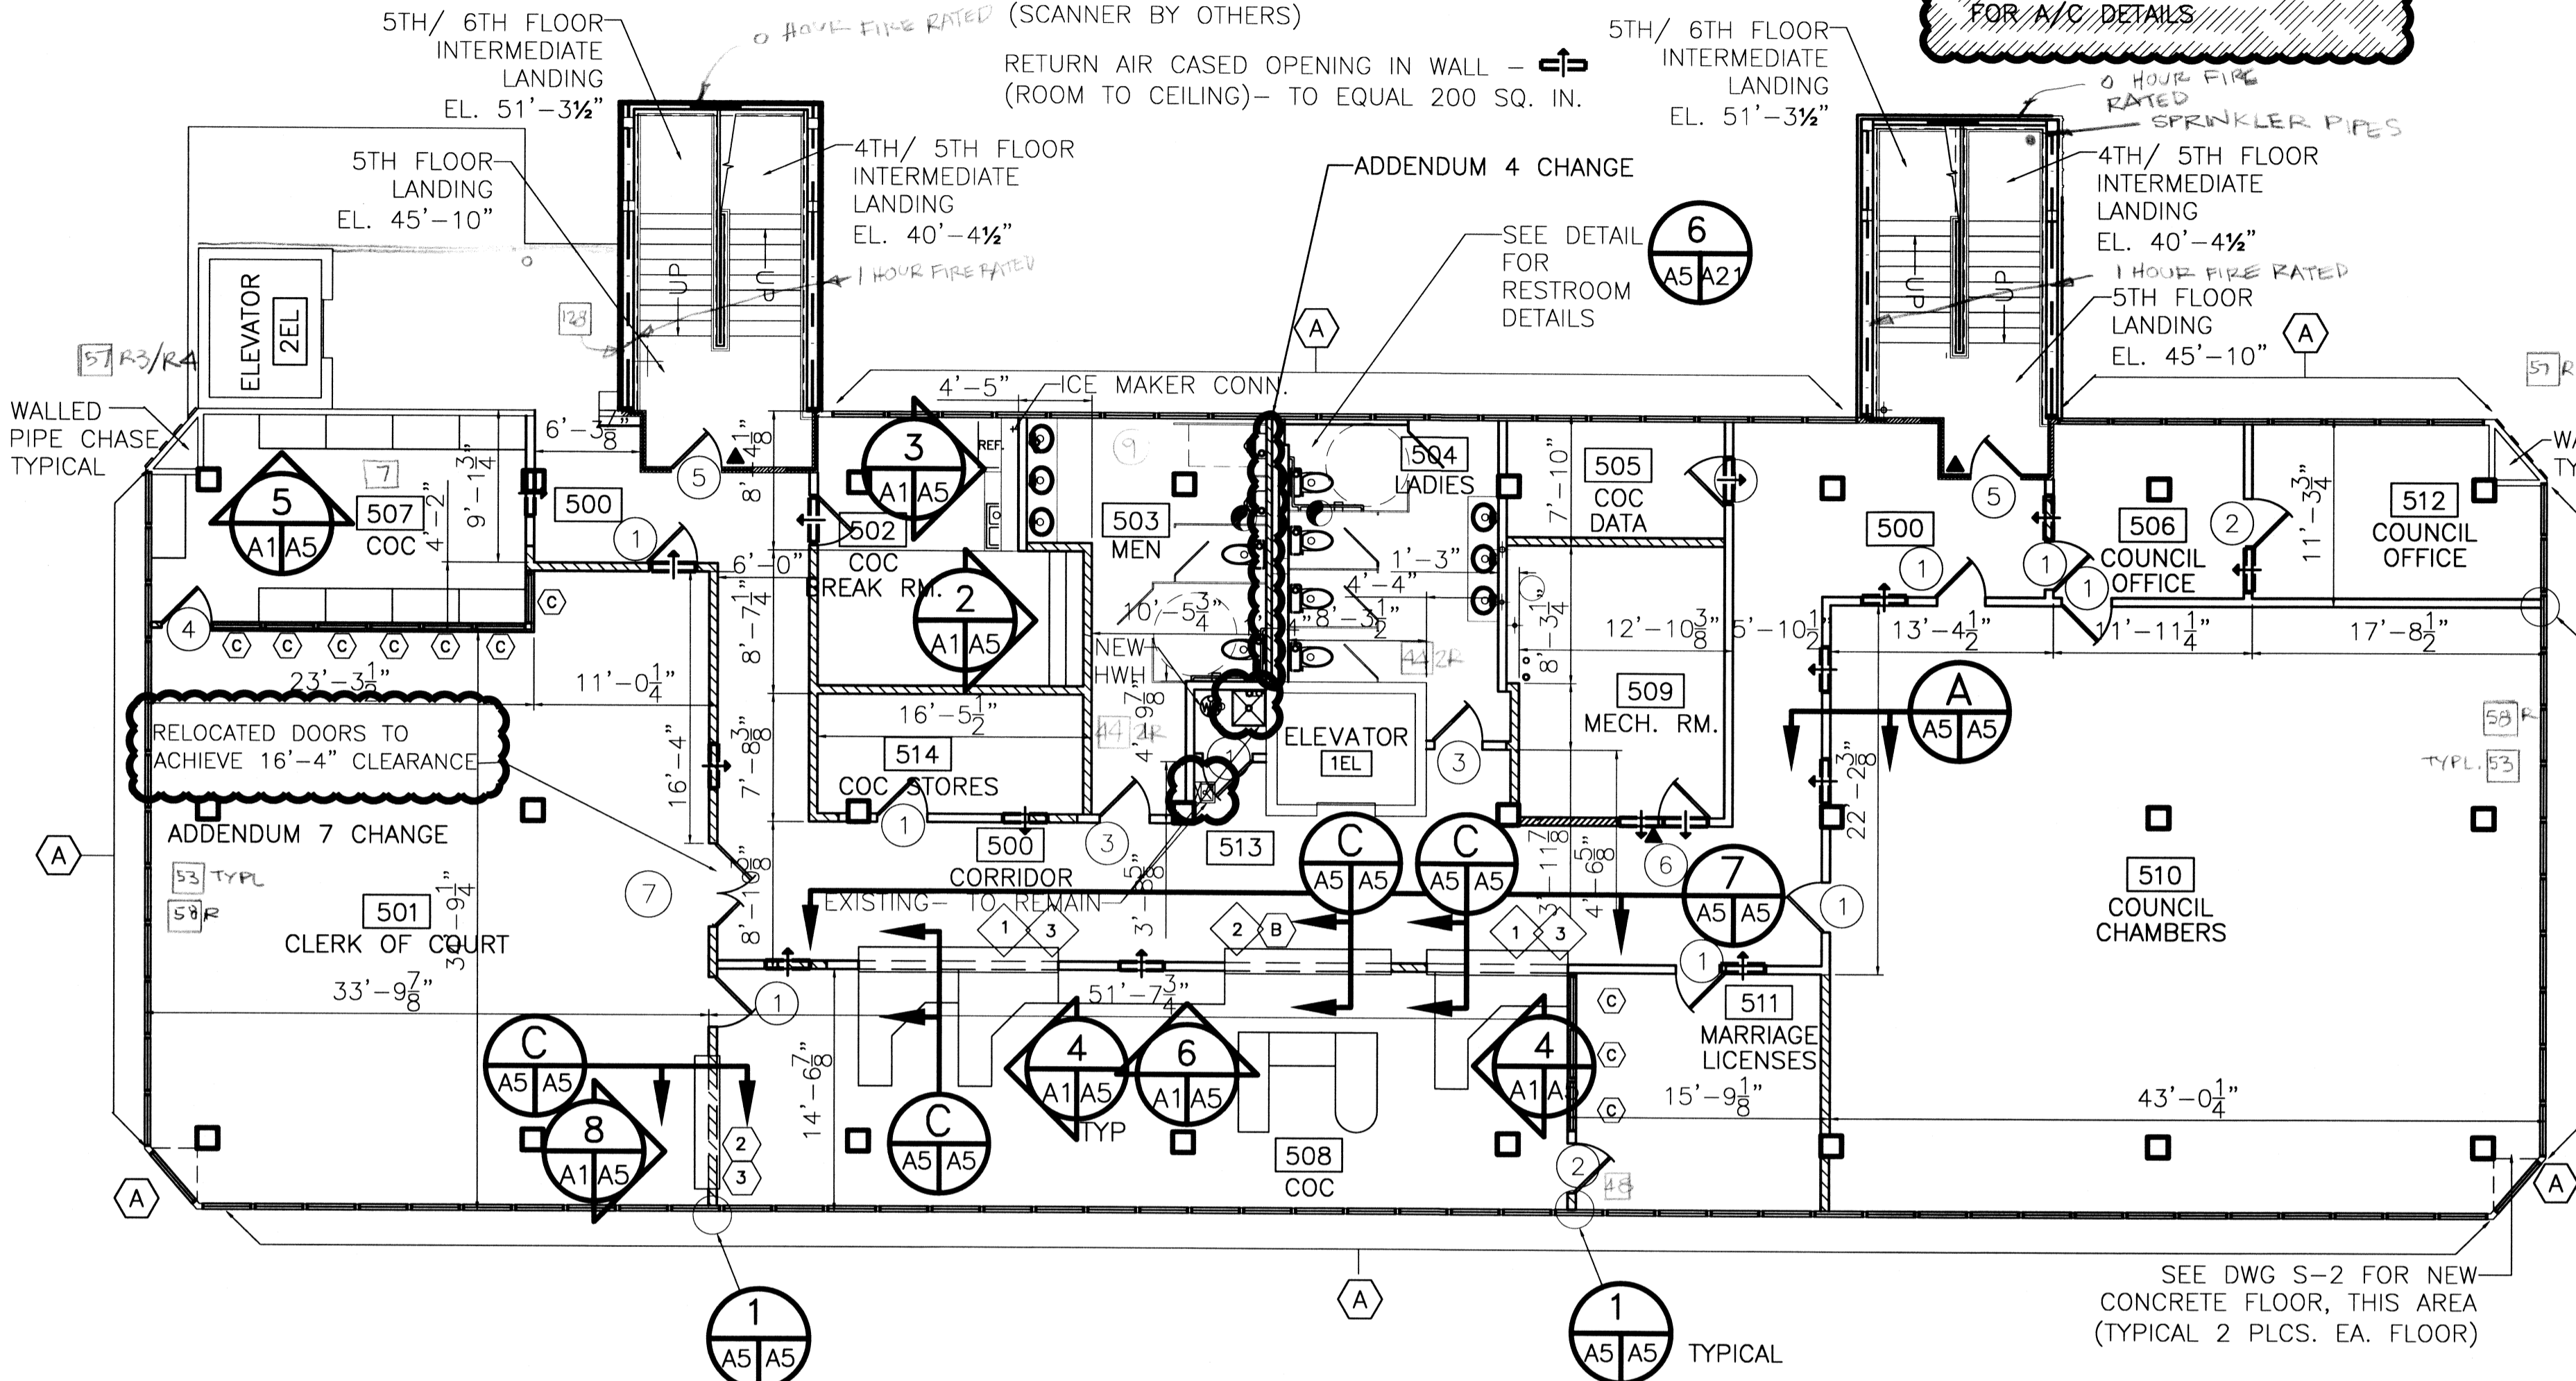


FIFTH FLOOR PLAN
SCALE: 1/8" = 1'-0"

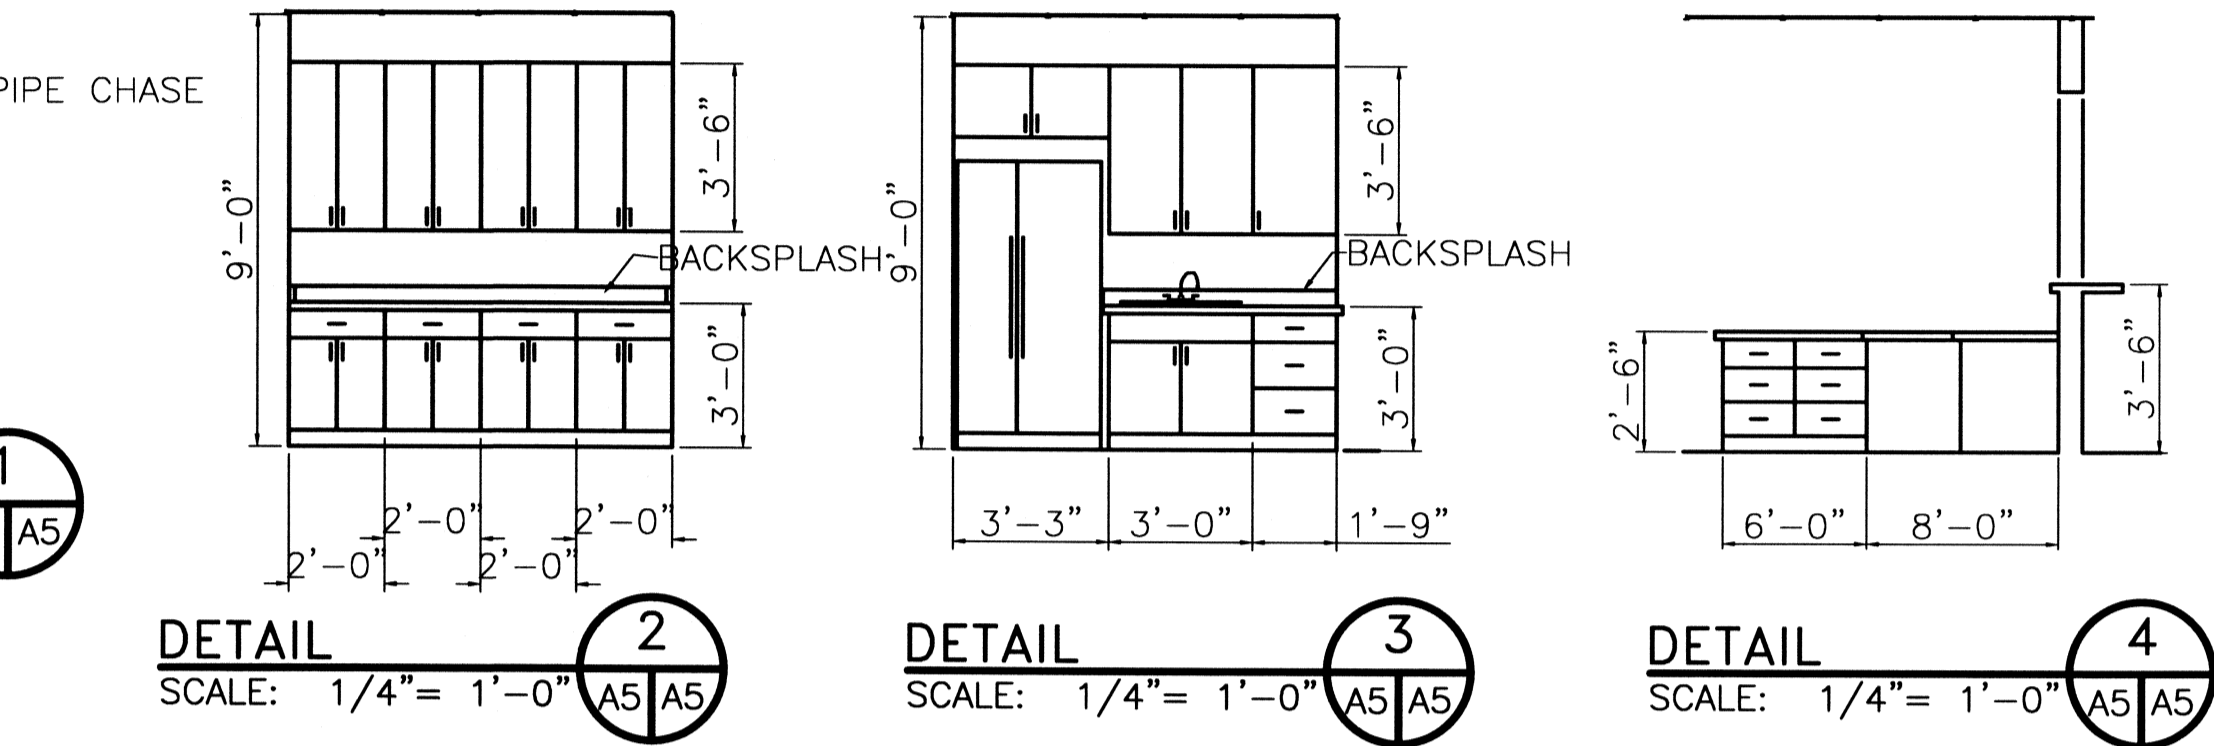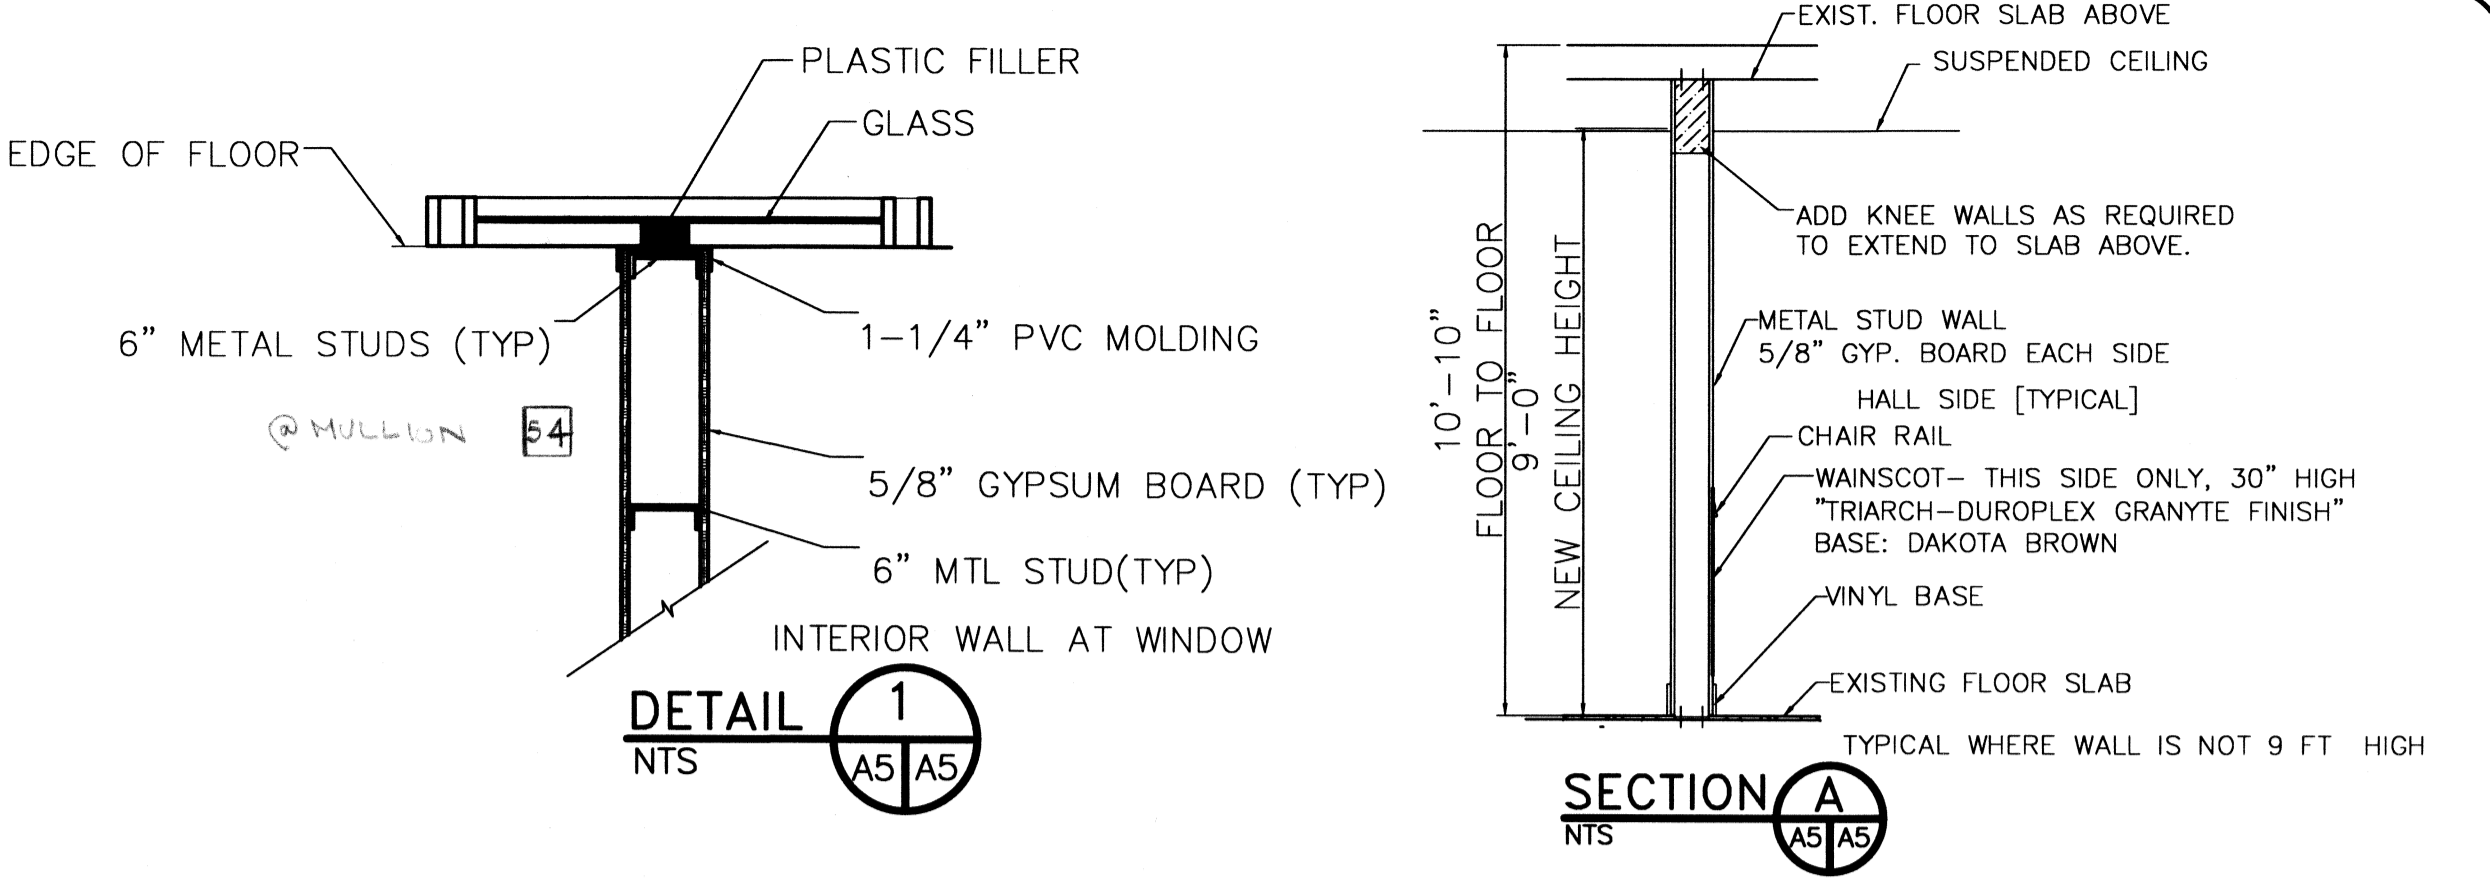


- 1 18" BAR TOP FINISHED AT 30" HIGH ABOVE 2 X 6 WALL. 5' HIGH X 8' WIDE SHEETROCK OPENING ABOVE.
- 2 18" BAR TOP FINISHED AT 36" HIGH ABOVE 2 X 6 WALL. 4'-6" HIGH X 8' WIDE SHEETROCK OPENING ABOVE.
- 3 FIT OPENING WITH ELECTRIC OPERATED STAINLESS STEEL ROLL DOWN GRILLE (ALPINE MALL DOWN OR EQUIVALENT)

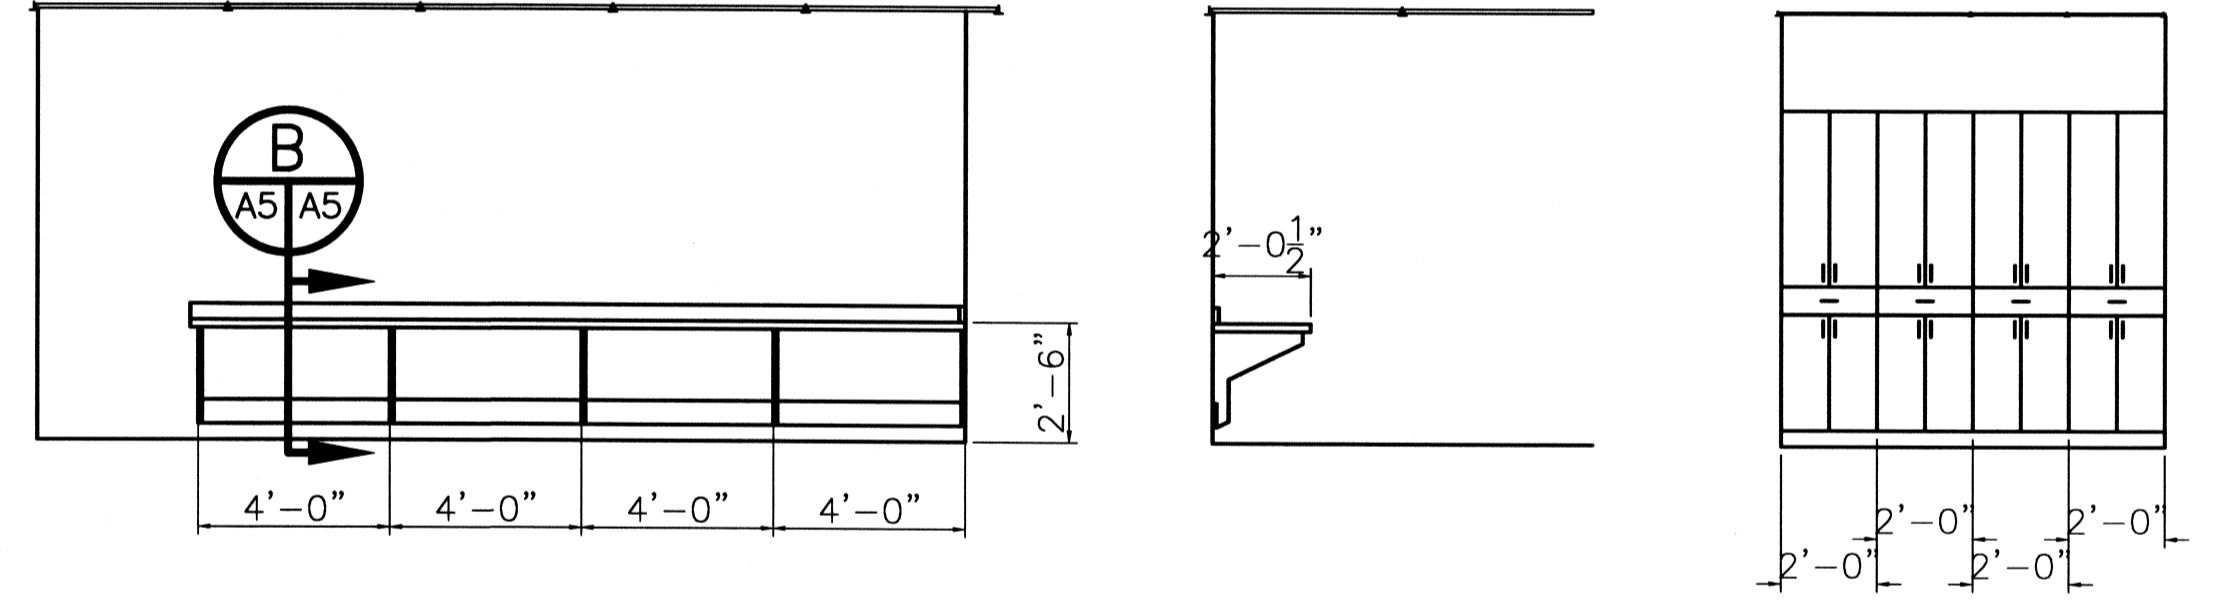

DETAIL 5 SCALE: 1/4" = 1'-0"
SECTION B SCALE: 1/4" = 1'-0"
DETAIL 6 SCALE: 1/4" = 1'-0"

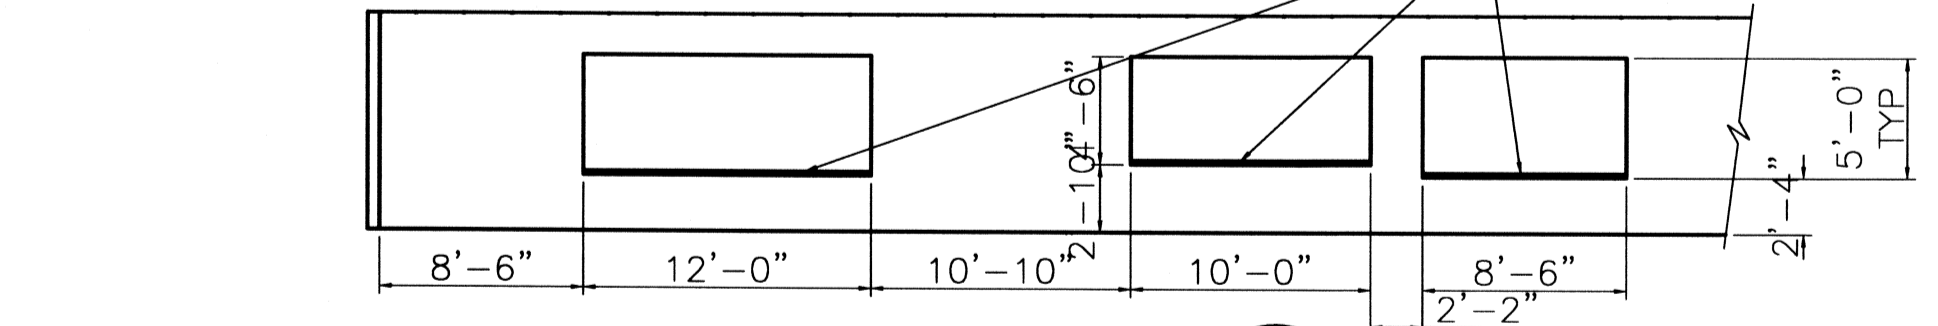

DETAIL 7 SCALE: 1/8" = 1'-0"

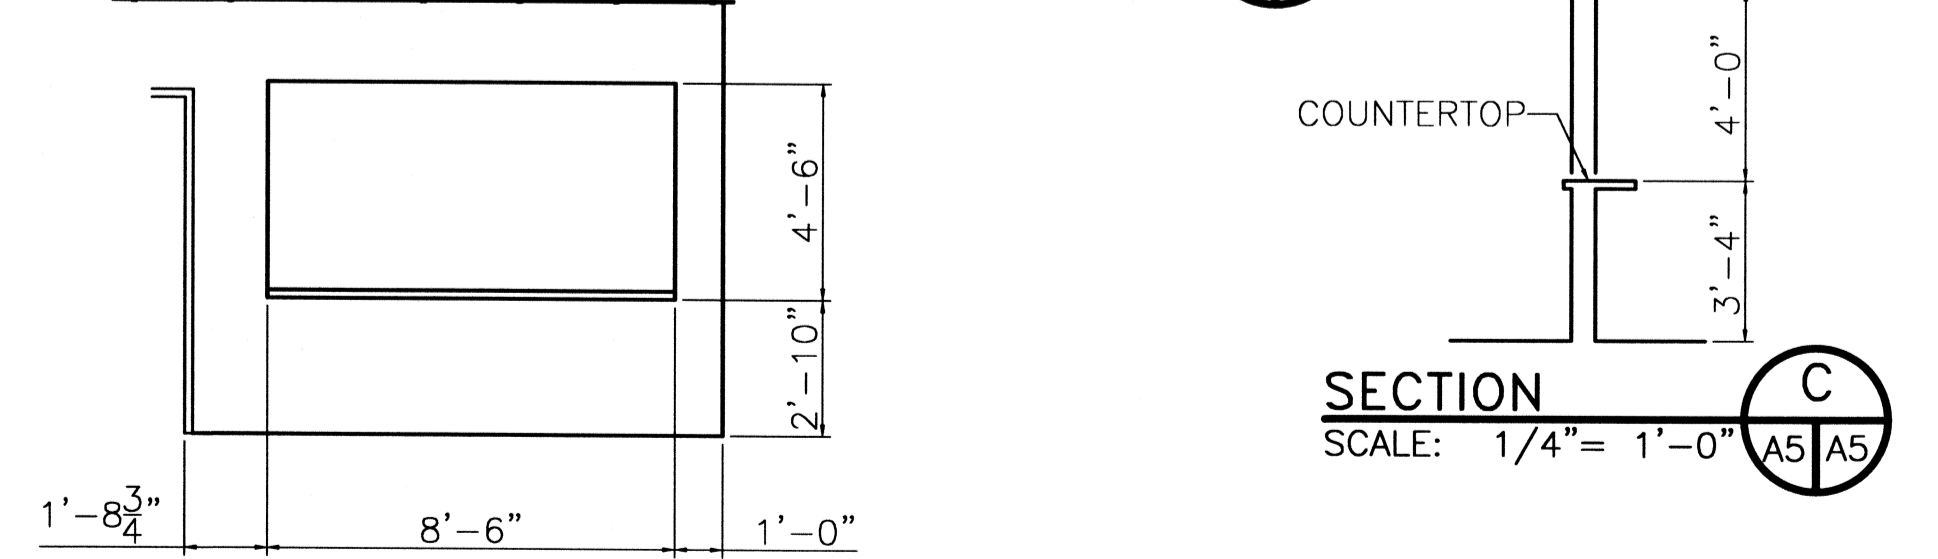

DETAIL 8 SCALE: 1/4" = 1'-0"

MATERIAL FOR COUNTERS AND DESKS SHALL BE 3/4" PLYWOOD W/ LAMINATE COVER ON EXPOSED SIDE AND EDGES

REVISD: 03/18/09cd
REVISD: 11/05/07ab
REVISD: 10/10/07ab
REVISD: 09/19/07ab
REVISD: 08/20/07ab
REVISD: 05/17/07ab
REVISD: 02/19/07
REVISD: 01/23/07

NOTE:
KITCHEN CABINETS SHALL BE MEDIUM COMMERCIAL GRADE, FACTORY BUILT. COUNTER TOPS SHALL BE MANMADE MARBLE OR EQUAL.

ROOM	FINISH SCHEDULE											REMARKS	
	FLOOR	BASE	WALLS	CEILING	CLG HT	CONCRETE	VINYL TILE	CARPET	PAINTED WOOD	CERAMIC TILE	WOOD		30" WAINSCOT
500					8'-6"								CARPET & PAD
501					9'-0"								
502					9'-0"								
503					9'-0"								
504					9'-0"								
505					9'-0"								
506					9'-0"								
507					9'-0"								
508					9'-0"								
509					10'-6"								
510					9'-0"								
511					9'-0"								
512					9'-0"								
513					9'-0"								
514					9'-0"								

*PEEL & STICK CUSHION BACK CARPET
CARPET SHALL HAVE CUSHION BACK PEEL & STICK
ROOMS 500,501,507,508
UNDERCUT ALL DOORS 3/4" TO ALL FOR PROPER EXHAUST AIR FLOW

DOOR & HARDWARE SCHEDULE										REMARKS	
TYPE	FRAME	HINGE	LOCK	ACCESSORIES							
1 3/0x7/0	SOLID WOOD	ALUM./GLASS	STEEL	STEEL	STEEL	STEEL	STEEL	STEEL	STEEL	STEEL	STAIN & VARNISH
2 3/0x7/0	HOLLOW	ALUM./GLASS	STEEL	STEEL	STEEL	STEEL	STEEL	STEEL	STEEL	STEEL	
3 3/0x7/0	SOLID WOOD	ALUM./GLASS	STEEL	STEEL	STEEL	STEEL	STEEL	STEEL	STEEL	STEEL	
4 3/0x7/0	SOLID WOOD	ALUM./GLASS	STEEL	STEEL	STEEL	STEEL	STEEL	STEEL	STEEL	STEEL	HALF GLASS
5 3/0x7/0	SOLID WOOD	ALUM./GLASS	STEEL	STEEL	STEEL	STEEL	STEEL	STEEL	STEEL	STEEL	1 HOUR RATED
6 3/0x7/0	SOLID WOOD	ALUM./GLASS	STEEL	STEEL	STEEL	STEEL	STEEL	STEEL	STEEL	STEEL	
7 3/0x7/0 & 2/0x7/0	SOLID WOOD	ALUM./GLASS	STEEL	STEEL	STEEL	STEEL	STEEL	STEEL	STEEL	STEEL	

DOORS SHOWN WITH ▲ SHALL BE EQUIPPED WITH ELECTRIC STRIKE FOR CARD READER

WINDOW SCHEDULE										REMARKS	
TYPE	FRAME	GLASS	LITES	ACCESSORIES							
A 4/0x5/0 *	FIXED	ALUM./GLASS	STEEL	STEEL	STEEL	STEEL	STEEL	STEEL	STEEL	STEEL	APPROXIMATELY 3,700 SQ. FT.
B 10/0x4/0	HORIZONTAL SLIDE	ALUM./GLASS	STEEL	STEEL	STEEL	STEEL	STEEL	STEEL	STEEL	STEEL	SLIDING SERVICE WINDOW
C 3/0x4/0	FIXED	ALUM./GLASS	STEEL	STEEL	STEEL	STEEL	STEEL	STEEL	STEEL	STEEL	

*FINAL SIZES TO BE DETERMINED BY VENDOR FROM FIELD MEASUREMENTS [TYP. ALL FLOORS]

= ADDENDUM 4 CHANGE = 09/19/07 CHANGE

5TH FLOOR RENOVATE PLAN
ST. TAMMANY PARISH ADMIN. COMPLEX
520 OLD SPANISH TRAIL
SLIDELL, LOUISIANA

RENOVATE OFFICE BUILDING
DAMMON ENGINEERING, INC.
1095 FLORIDA AVENUE 985-649-6832 SLIDELL, LA. 70458
DAMMONENGINEERING.COM

SCALE: AS NOTED
FILE:
JOB NO. 1729
DATE: 1-9-07
SHEET
A-5
OF

CONTRACT SET- 10/10/07