

LEGEND
 □ RFI # 2
 ○ CHANGE ORDER # 2

43 EQ. SP. @ 3'-1 1/2" = 137'-4 5/8"

12" COMPUTER GENERATED VINYL SIGN MOUNTED ON 3/8" MIN. BACKER BOARD, EXTERIOR GRADE PLYWOOD. SEAL EXPOSED ENDS.



RICH CREAM PAINT TYP

LT. BRONZE ANODIZED WINDOW FRAME TYP

EL. 84'-2 3/8"

EL. 67'-7 1/2"

EL. 56'-9"


EL. 45'-10"

EL. 34'-11"

EL. 24'-0"

EL. 13'-1"

EL. 0"

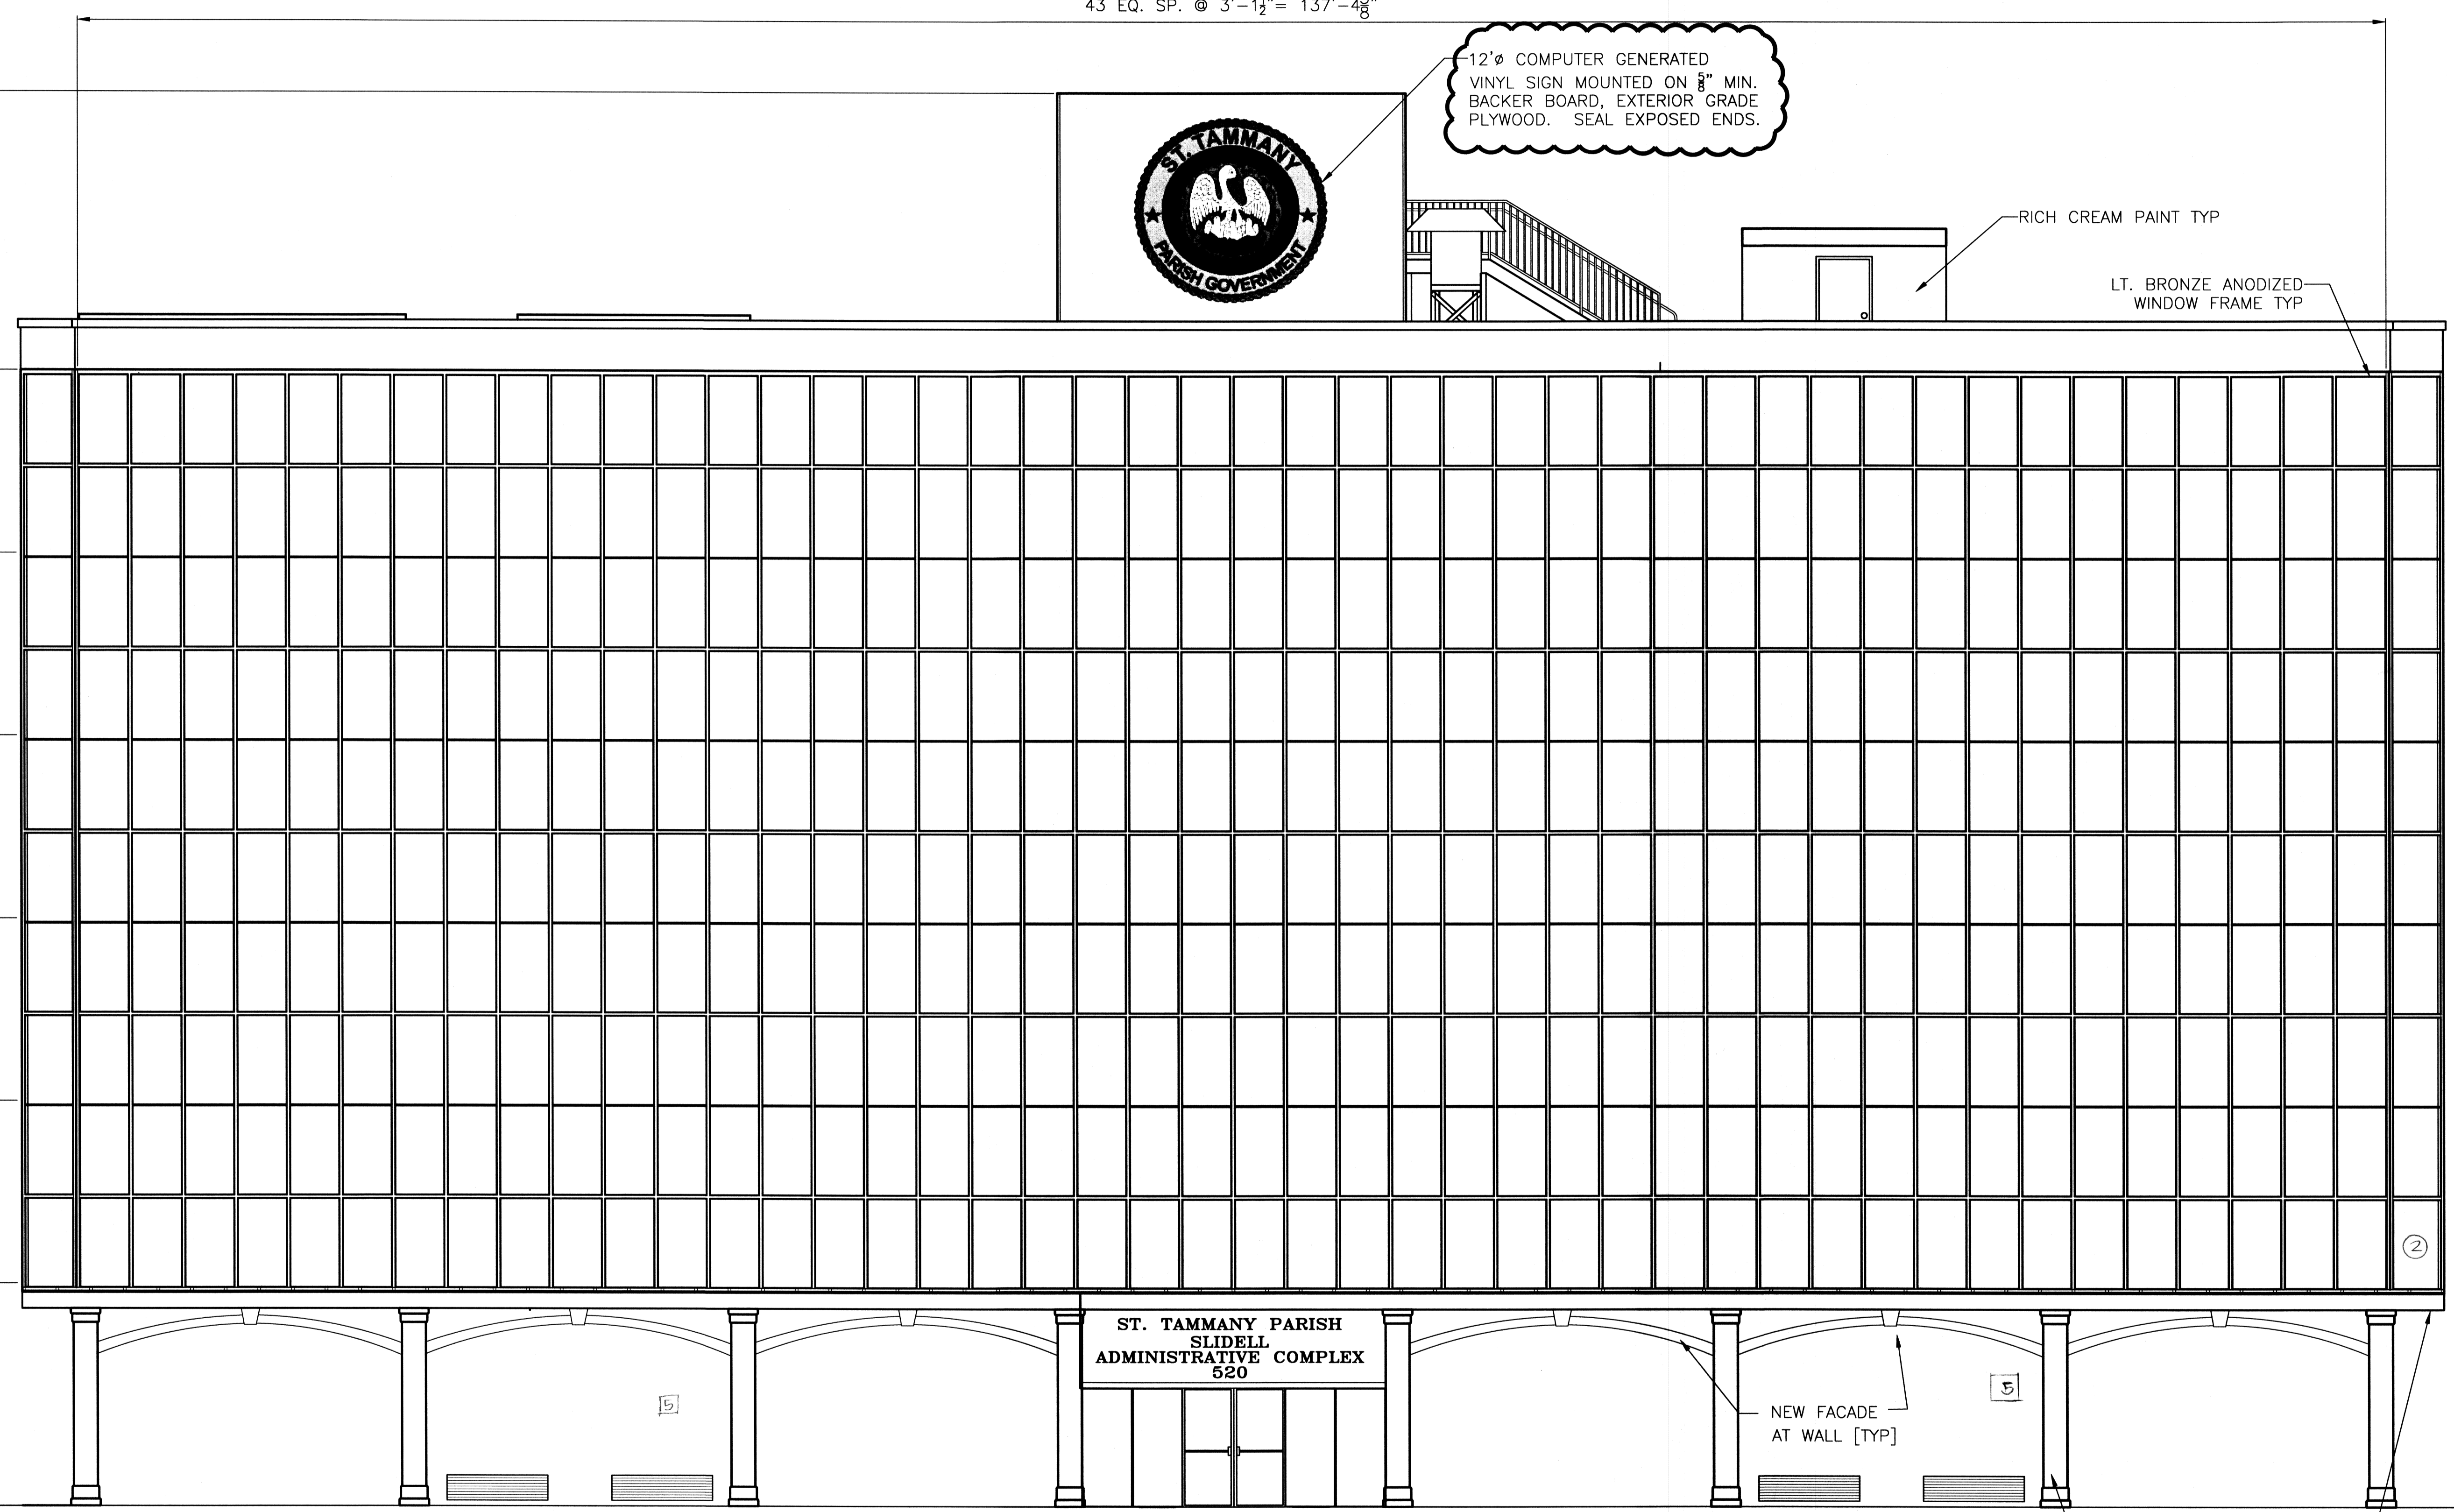

ST. TAMMANY PARISH
 SLIDELL
 ADMINISTRATIVE COMPLEX
 520

NEW FACADE
 AT WALL [TYP]

NEW DECORATIVE COLUMNS
 & BEAMS

SOUTH ELEVATION
 SCALE: 3/16" = 1'-0"

= ADDENDUM 2 CHANGE

REVISED: 05/17/07ab
 REVISED: 05/07/07ab
 REVISED: 03/07/07ab
 REVISED: 02/19/07

SOUTH ELEVATION
 ST. TAMMANY PARISH ADMIN. COMPLEX
 520 OLD SPANISH TRAIL
 SLIDELL, LOUISIANA

RENOVATE OFFICE BUILDING
DAMMON ENGINEERING, INC.
 1095 FLORIDA AVENUE 985-649-5832 SLIDELL, LA. 70458
 DAMMONENGINEERING.COM

SCALE: AS NOTED

FILE:

JOB NO. 1729

DATE: 1-8-07

SHEET

A-8

OF

CONTRACT SET- 10/10/07