


SECOND FLOOR REFLECTED CEILING PLAN
 SCALE: 1/8" = 1'-0"

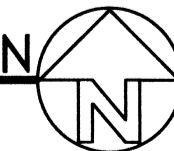

2ND FLOOR REFL. CLG. PLAN
 ST. TAMMANY PARISH ADMIN. COMPLEX
 520 OLD SPANISH TRAIL
 SLIDELL, LOUISIANA

RENOVATE OFFICE BUILDING
DAMMON ENGINEERING, INC.
 1095 FLORIDA AVENUE 985-649-5832 SLIDELL, LA. 70458
 DAMMONENGINEERING.COM

SCALE: AS NOTED

FILE:

JOB NO. 1729

DATE: 1-8-07

SHEET

A.13

OF

REVISED: 05/21/07ab
 REVISED: 03/07/07ab

CONTRACT SET- 10/10/07