


ROOF PLUMBING PLAN
 SCALE: 1/8" = 1'-0"

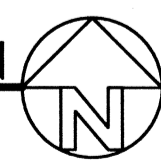

ROOF PLUMBING PLAN
 ST. TAMMANY PARISH ADMIN. COMPLEX
 520 OLD SPANISH TRAIL
 SLIDELL, LOUISIANA

RENOVATE OFFICE BUILDING
DAMMON ENGINEERING, INC.
 1096 FLORIDA AVENUE 985-649-5832 SLIDELL, LA. 70458
 DAMMONENGINEERING.COM

SCALE: AS NOTED
 FILE:
 JOB NO. 1729
 DATE: 1-8-07

SHEET
P-7
 OF

REVISED: 03/07/07ob

RFP #2 11-13-07