



REVDATE: FILE NAME: C:\Schlafly\ENGR 08010_SOF Rivertine\Drawings Elec 5-As-buils\E2.4.dwg LAYOUT NAME: E2.4 PLOTTED: Friday, May 28, 2010 3:06pm

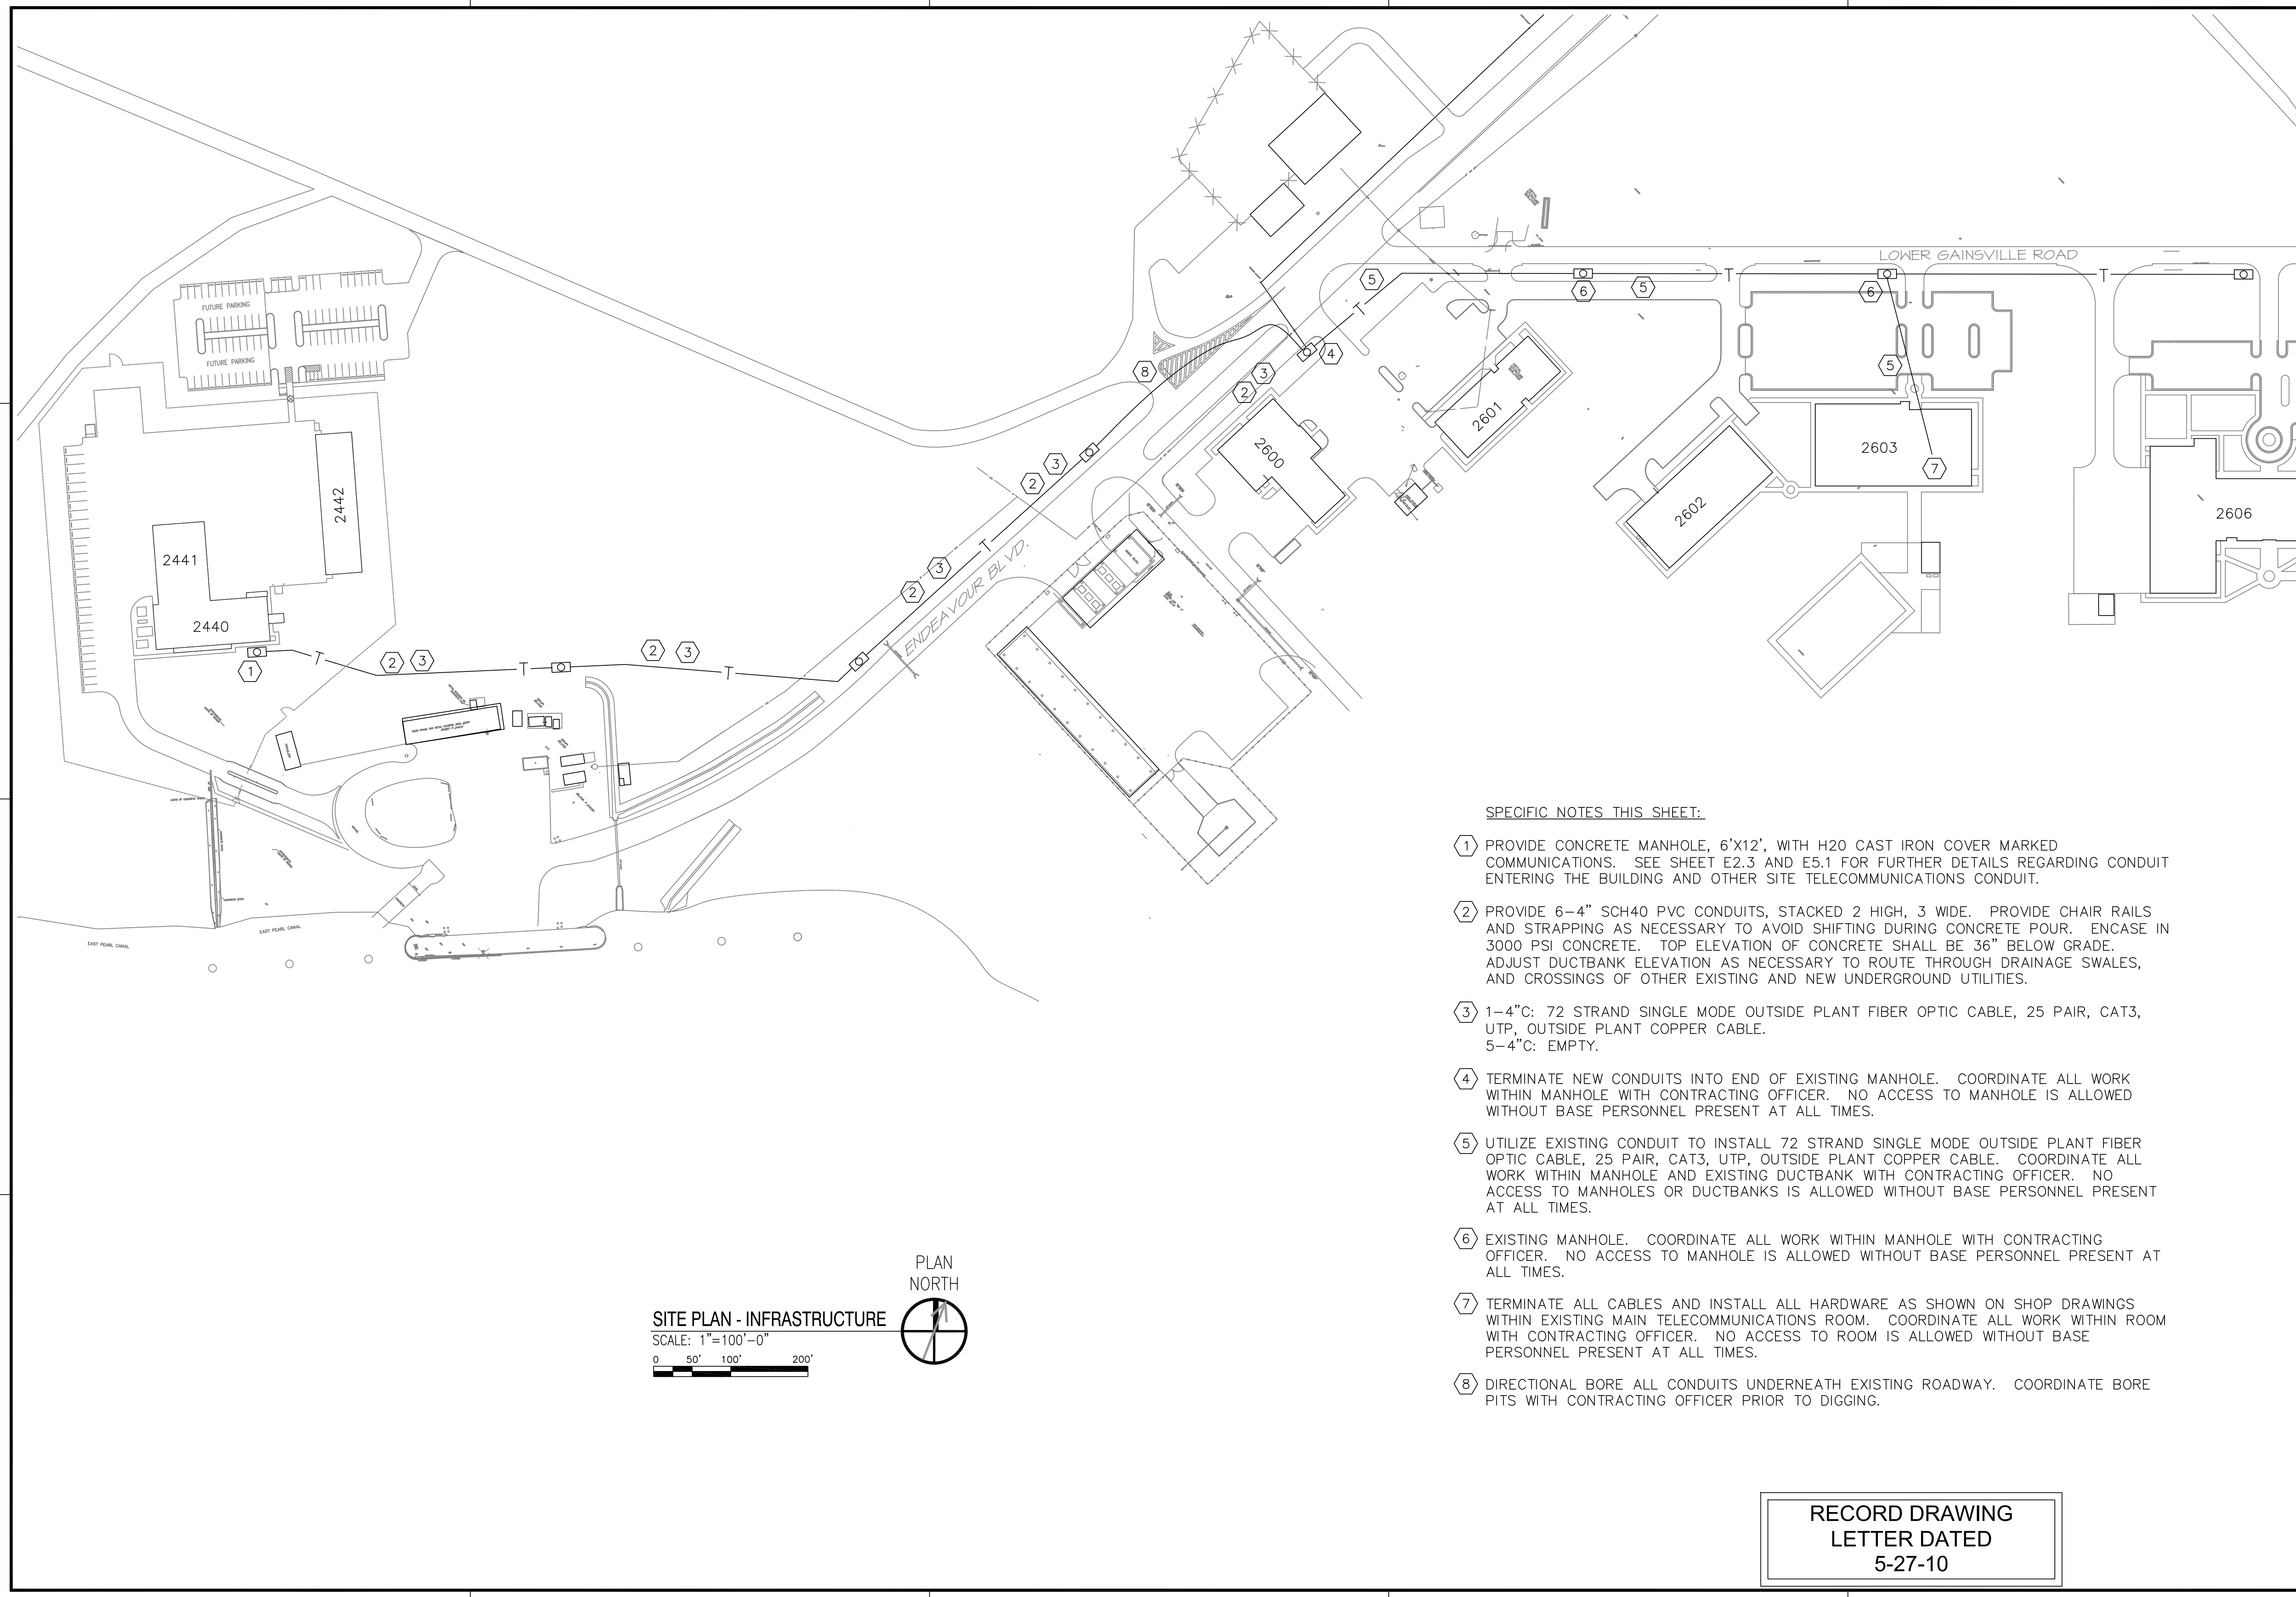

SITE PLAN - INFRASTRUCTURE


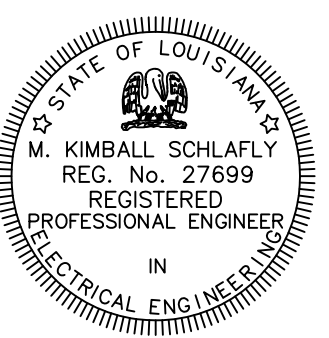
SCALE: 1" = 100'-0"
 0 50' 100' 200'

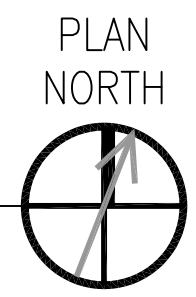

SPECIFIC NOTES THIS SHEET:

- ① PROVIDE CONCRETE MANHOLE, 6'X12', WITH H2O CAST IRON COVER MARKED COMMUNICATIONS. SEE SHEET E2.3 AND E5.1 FOR FURTHER DETAILS REGARDING CONDUIT ENTERING THE BUILDING AND OTHER SITE TELECOMMUNICATIONS CONDUIT.
- ② PROVIDE 6-4" SCH40 PVC CONDUITS, STACKED 2 HIGH, 3 WIDE. PROVIDE CHAIR RAILS AND STRAPPING AS NECESSARY TO AVOID SHIFTING DURING CONCRETE POUR. ENCASE IN 3000 PSI CONCRETE. TOP ELEVATION OF CONCRETE SHALL BE 36" BELOW GRADE. ADJUST DUCTBANK ELEVATION AS NECESSARY TO ROUTE THROUGH DRAINAGE SWALES, AND CROSSINGS OF OTHER EXISTING AND NEW UNDERGROUND UTILITIES.
- ③ 1-4"C: 72 STRAND SINGLE MODE OUTSIDE PLANT FIBER OPTIC CABLE, 25 PAIR, CAT3, UTP, OUTSIDE PLANT COPPER CABLE.
 5-4"C: EMPTY.
- ④ TERMINATE NEW CONDUITS INTO END OF EXISTING MANHOLE. COORDINATE ALL WORK WITHIN MANHOLE WITH CONTRACTING OFFICER. NO ACCESS TO MANHOLE IS ALLOWED WITHOUT BASE PERSONNEL PRESENT AT ALL TIMES.
- ⑤ UTILIZE EXISTING CONDUIT TO INSTALL 72 STRAND SINGLE MODE OUTSIDE PLANT FIBER OPTIC CABLE, 25 PAIR, CAT3, UTP, OUTSIDE PLANT COPPER CABLE. COORDINATE ALL WORK WITHIN MANHOLE AND EXISTING DUCTBANK WITH CONTRACTING OFFICER. NO ACCESS TO MANHOLES OR DUCTBANKS IS ALLOWED WITHOUT BASE PERSONNEL PRESENT AT ALL TIMES.
- ⑥ EXISTING MANHOLE. COORDINATE ALL WORK WITHIN MANHOLE WITH CONTRACTING OFFICER. NO ACCESS TO MANHOLE IS ALLOWED WITHOUT BASE PERSONNEL PRESENT AT ALL TIMES.
- ⑦ TERMINATE ALL CABLES AND INSTALL ALL HARDWARE AS SHOWN ON SHOP DRAWINGS WITHIN EXISTING MAIN TELECOMMUNICATIONS ROOM. COORDINATE ALL WORK WITHIN ROOM WITH CONTRACTING OFFICER. NO ACCESS TO ROOM IS ALLOWED WITHOUT BASE PERSONNEL PRESENT AT ALL TIMES.
- ⑧ DIRECTIONAL BORE ALL CONDUITS UNDERNEATH EXISTING ROADWAY. COORDINATE BORE PITS WITH CONTRACTING OFFICER PRIOR TO DIGGING.

RECORD DRAWING
LETTER DATED
5-27-10

	5-27-10																
AS-BUILT REVISIONS	DATE																
SYN	DESCRIPTION																
 NAVAC																	
SCHLAFLY ENGINEERING LLC 121 SOUTH GENOIS STREET NEW ORLEANS LA 70119 PHONE 504-415-3347 FAX 504-482-7943 M. KIMBALL SCHLAFLY, P.E. LA REG 27699 <small>SEPTEMBER 4, 2009</small>																	
																	
<small>DES: K. SCHLAFLY DRW: K. SCHLAFLY</small> <small>REVIEWED BY: R. WILTSE</small> <small>PM/DM: T. ARTRIP</small> <small>CHIEF ENG/ARCH: P. DAMMON</small>																	
DEPARTMENT OF THE NAVY NAVAL FACILITIES ENGINEERING COMMAND SOUTHEAST NAVAL AIR STATION JACKSONVILLE MISSISSIPPI JOHN C. STENNIS SPACE CENTER SOF RIVERINE AND COMBATANT CRAFT OPERATIONS FACILITY	SITE PLAN - INFRASTRUCTURE																
<table border="1" style="width: 100%; border-collapse: collapse;"> <tr> <td>CODE ID. NO. N4412</td> <td>SIZE D</td> </tr> <tr> <td>SCALE: 1" = 100'-0"</td> <td></td> </tr> <tr> <td>MAXIMO NO. #####</td> <td></td> </tr> <tr> <td>STA. PROJ. NO. P-210</td> <td></td> </tr> <tr> <td>WORK ORDER NO. 510247</td> <td></td> </tr> <tr> <td>CONSTR. CONTR. NO. N62467-05-D-0096</td> <td></td> </tr> <tr> <td>NAVAC DRAWING NO. 15026756</td> <td></td> </tr> <tr> <td>SHEET 109 of 132</td> <td></td> </tr> </table>		CODE ID. NO. N4412	SIZE D	SCALE: 1" = 100'-0"		MAXIMO NO. #####		STA. PROJ. NO. P-210		WORK ORDER NO. 510247		CONSTR. CONTR. NO. N62467-05-D-0096		NAVAC DRAWING NO. 15026756		SHEET 109 of 132	
CODE ID. NO. N4412	SIZE D																
SCALE: 1" = 100'-0"																	
MAXIMO NO. #####																	
STA. PROJ. NO. P-210																	
WORK ORDER NO. 510247																	
CONSTR. CONTR. NO. N62467-05-D-0096																	
NAVAC DRAWING NO. 15026756																	
SHEET 109 of 132																	
E2.4 <small>DRAWFORM REVISION: 01 JAN 2009</small>																	