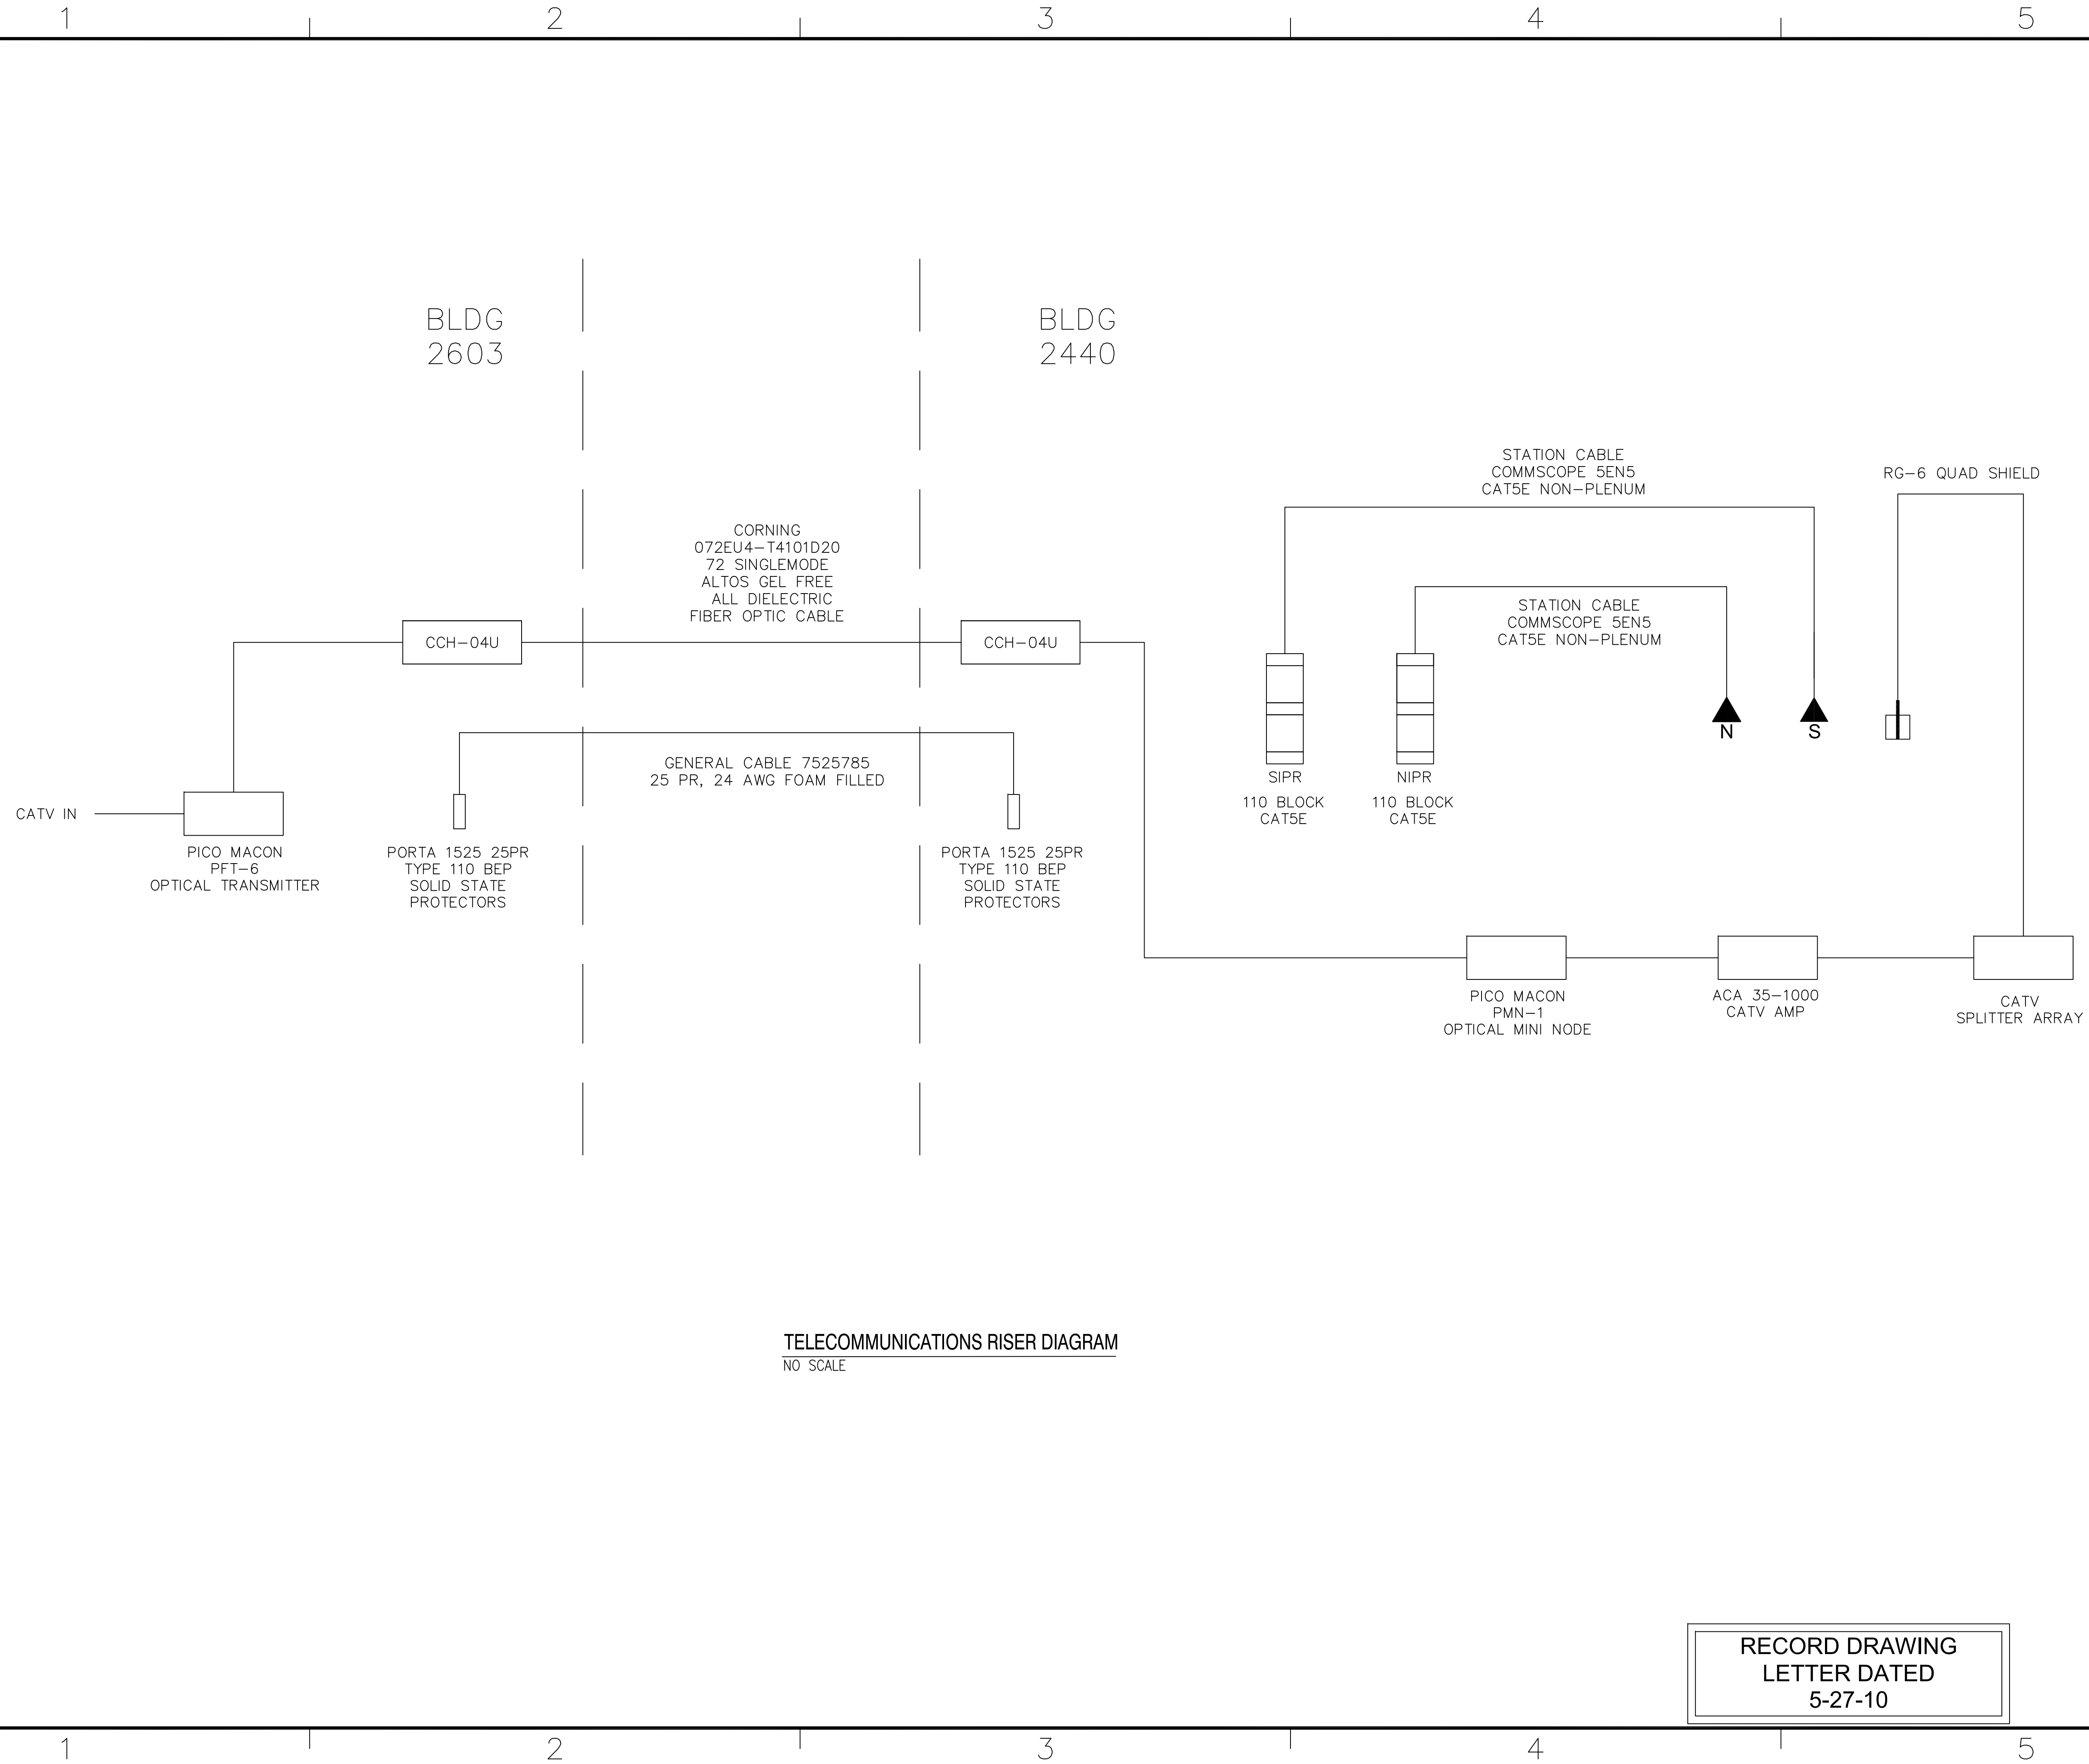

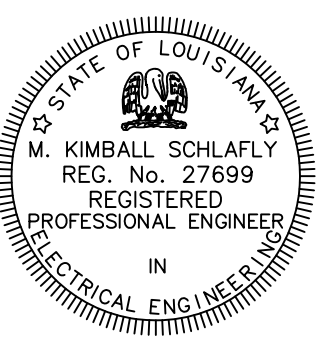


REVDATE: FILE NAME: C:\Schlafly\ENGR 08010\_SOF Rivertine Drawings Elec 5-As-buils ES.1.dwg LAYOUT NAME: ES.4 PLOTTED: Friday, May 28, 2010 - 4:42pm



RECORD DRAWING  
LETTER DATED  
5-27-10

|   |             |      |
|---|-------------|------|
| AS-BUILT REVISIONS  | DATE        | APPR |
| 5-27-10   |             |      |
| SYN   | DESCRIPTION |      |
| <br><b>NAVFAC</b><br><b>SCHLAFLY ENGINEERING LLC</b><br>121 SOUTH GENOIS STREET<br>NEW ORLEANS LA 70119<br>PHONE 504-415-3347<br>FAX 504-482-7943<br>M. KIMBALL SCHLAFLY, P.E.<br>LA REG 27699<br><small>SEPTEMBER 4, 2009</small> |             |      |
| <br><small>DES: K. SCHLAFLY   DRW: K. SCHLAFLY</small><br><small>REVIEWED BY: R. WILTSE</small><br><small>PM/DM: T. ARTRIP</small><br><small>CHIEF ENG/ARCH: P. DAMMON</small>  |             |      |
| <small>DEPARTMENT OF THE NAVY</small><br><b>NAVAL FACILITIES ENGINEERING COMMAND SOUTHEAST</b><br><small>NAVAL AIR STATION JACKSONVILLE</small><br><small>MISSISSIPPI</small><br><b>JOHN C. STENNIS SPACE CENTER</b><br><b>SOF RIVERINE AND COMBATANT CRAFT OPERATIONS FACILITY</b><br><b>TELCO RISER DIAGRAM</b>     |             |      |
| CODE ID. NO. N4412  | SIZE D      |      |
| SCALE: 1/8"=1'-0"   |             |      |
| MAXIMO NO. #####  |             |      |
| STA. PROJ. NO. P-210  |             |      |
| WORK ORDER NO. 510247   |             |      |
| CONSTR. CONTR. NO. N62467-05-D-0096   |             |      |
| NAVFAC DRAWING NO. 15026766   |             |      |
| SHEET 119 OF 132  |             |      |
| E5.4  |             |      |
| DRAWFORM REVISION: 01 JAN 2009  |             |      |