


BOAT STORAGE BUILDING HVAC PLAN
SCALE: 3/8"=1'-0"



DAMIEN W. SERAUSKAS, P.E.
PROFESSIONAL ENGINEERING SERVICES
15 CYPRESS POINT LANE NEW ORLEANS, LA 70131
VOICE: (504)866-2600 FAX: (504)218-9480

SYM	DESCRIPTION	DATE	APPR
1	RECORD DRAWING	06/10/2010	DWS
	AS-BUILT CONDITIONS SHOWN	06/10/2010	DWS

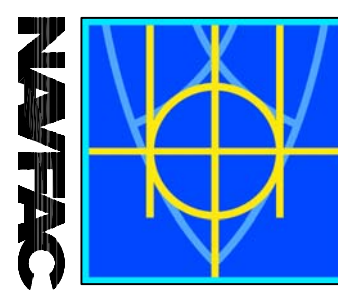

DAMMON
ENGINEERING, INC.
CHIEF ENGINEER
DAMMON, P. E. 6004 N. WINTER
SUITE 100
SLIDERS LA 70568
(980) 649-5832

DEPARTMENT OF THE NAVY
NAVAL FACILITIES ENGINEERING COMMAND
NAVAL FACILITIES ENGINEERING COMMAND SOUTHEAST
NAVAL AIR STATION JACKSONVILLE
MISSISSIPPI
JOHN C. STENNIS SPACE CENTER
SOF RIVERINE AND COMBATANT
CRAFT OPERATIONS FACILITY - PRE-FINAL
BOAT STORAGE BUILDING HVAC PLAN

DESIGNED BY: R. WINTER
DRAWN BY: T. ARTHUR
CHECKED BY: P. DAMMON
PROJECT NO.: 102487-05-0-0096
SHEET 87 OF 132

PROJECT NO.: 102487-05-0-0096
SHEET 87 OF 132
M2.1