


(M)N 89°04'41" W

(P)N 89°05'57" W

(M)S 00°13'29" E


244.25'

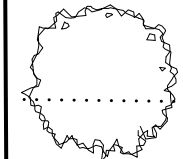

S 89°05'57" E

180.00'

N 00°13'28" W
36.21'

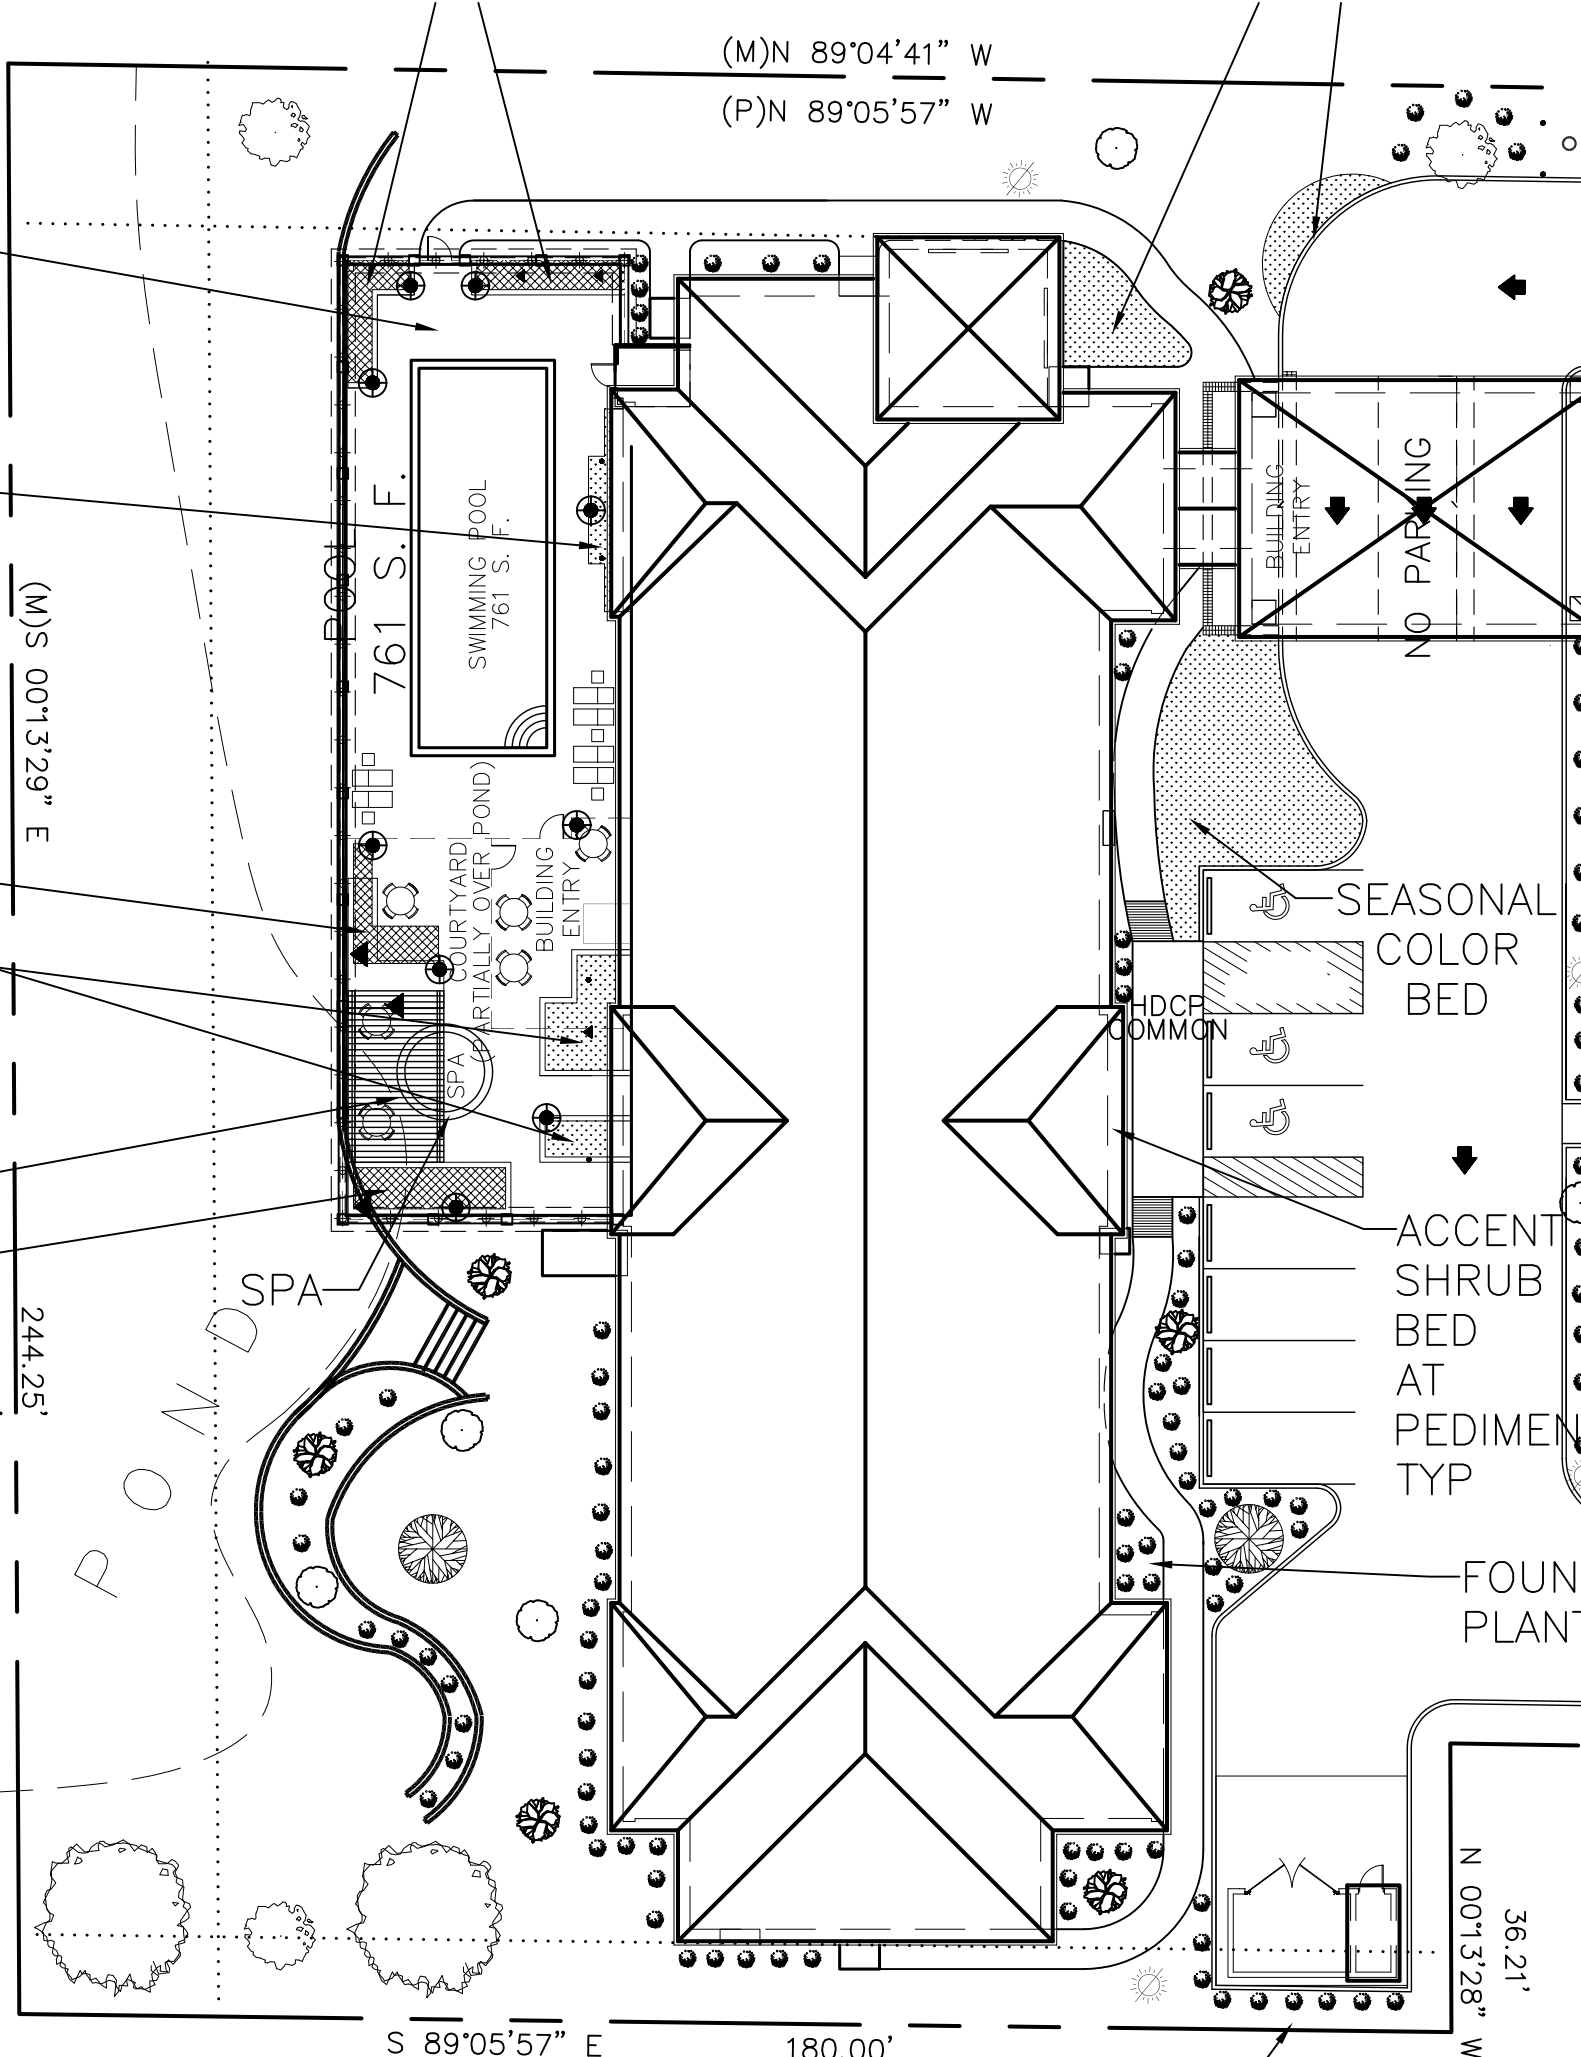

761 S. F.

SWIMMING POOL
761 S. F.

COURTYARD
(PARTIALLY OVER POND)

SPA

SPA

BUILDING
ENTRY

BUILDING
ENTRY

NO PARKING

SEASONAL
COLOR
BED

HDCP
COMMON

ACCENT
SHRUB
BED
AT
PEDIMENT
TYP

FOUR
PLANT

