

REVISIONS:

OWNER/DEVELOPER  
MIKE DESAI  
TEL: (601) 415-9519  
432 GARDEN GROVE STREET  
VICKSBURG, MS 39180




**N**  
NORMAN PATTEN & ASSOC.  
ARCHITECTURE & PLANNING  
413 CEDRA ST. @ MAIN - CEDRA HILL, TX 75104 - 972/293-2929  
npotten@fiosh.net

10-18-12  
DATE

---  
JOB NO.

SHEET NO.

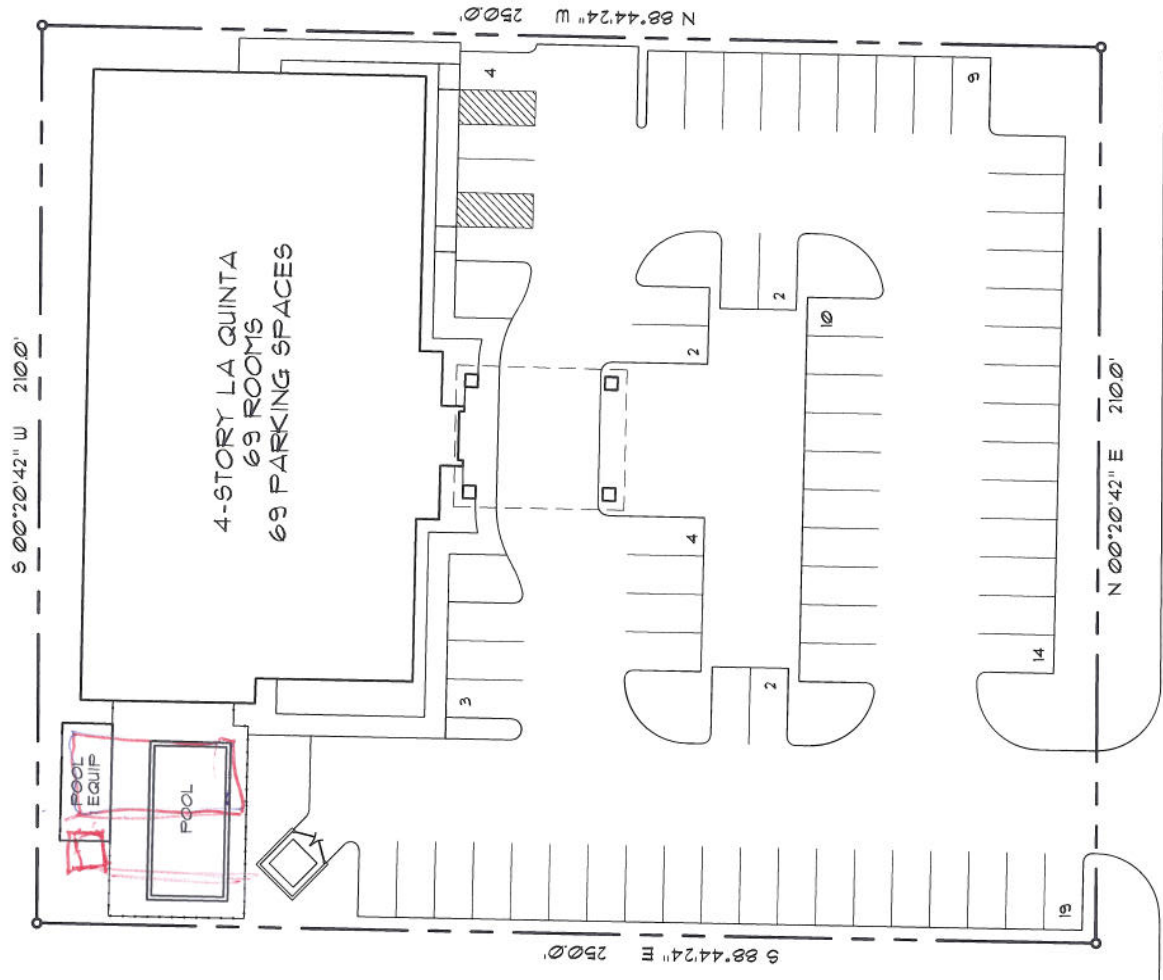

INTERSTATE HIGHWAY 59  
SERVICE ROAD



PRELIMINARY SITE PLAN

SCALE: 1" = 20'-0"

REVISIONS:

OWNER/DEVELOPER:  
MIKE DESAI  
TEL: (601) 415-9519  
432 GARDEN GROVE STREET  
VICKSBURG, MS 39180



NORMAN PATTEN & ASSOC.  
ARCHITECTURE & PLANNING  
413 CEDAR ST @ MAIN - CEDAR HILL, TX 75104 - 972/293-2929  
npatten@foshnet


10-18-12  
DATE:

JOB NO.

SHEET NO.

ROOM MIX

ROOM TYPE	1ST	2ND	3RD	4TH	TOTAL
KING	3	11	11	11	36
DOUBLE QUEEN	6	9	9	9	33
FLOOR TOTAL	9	20	20	20	69

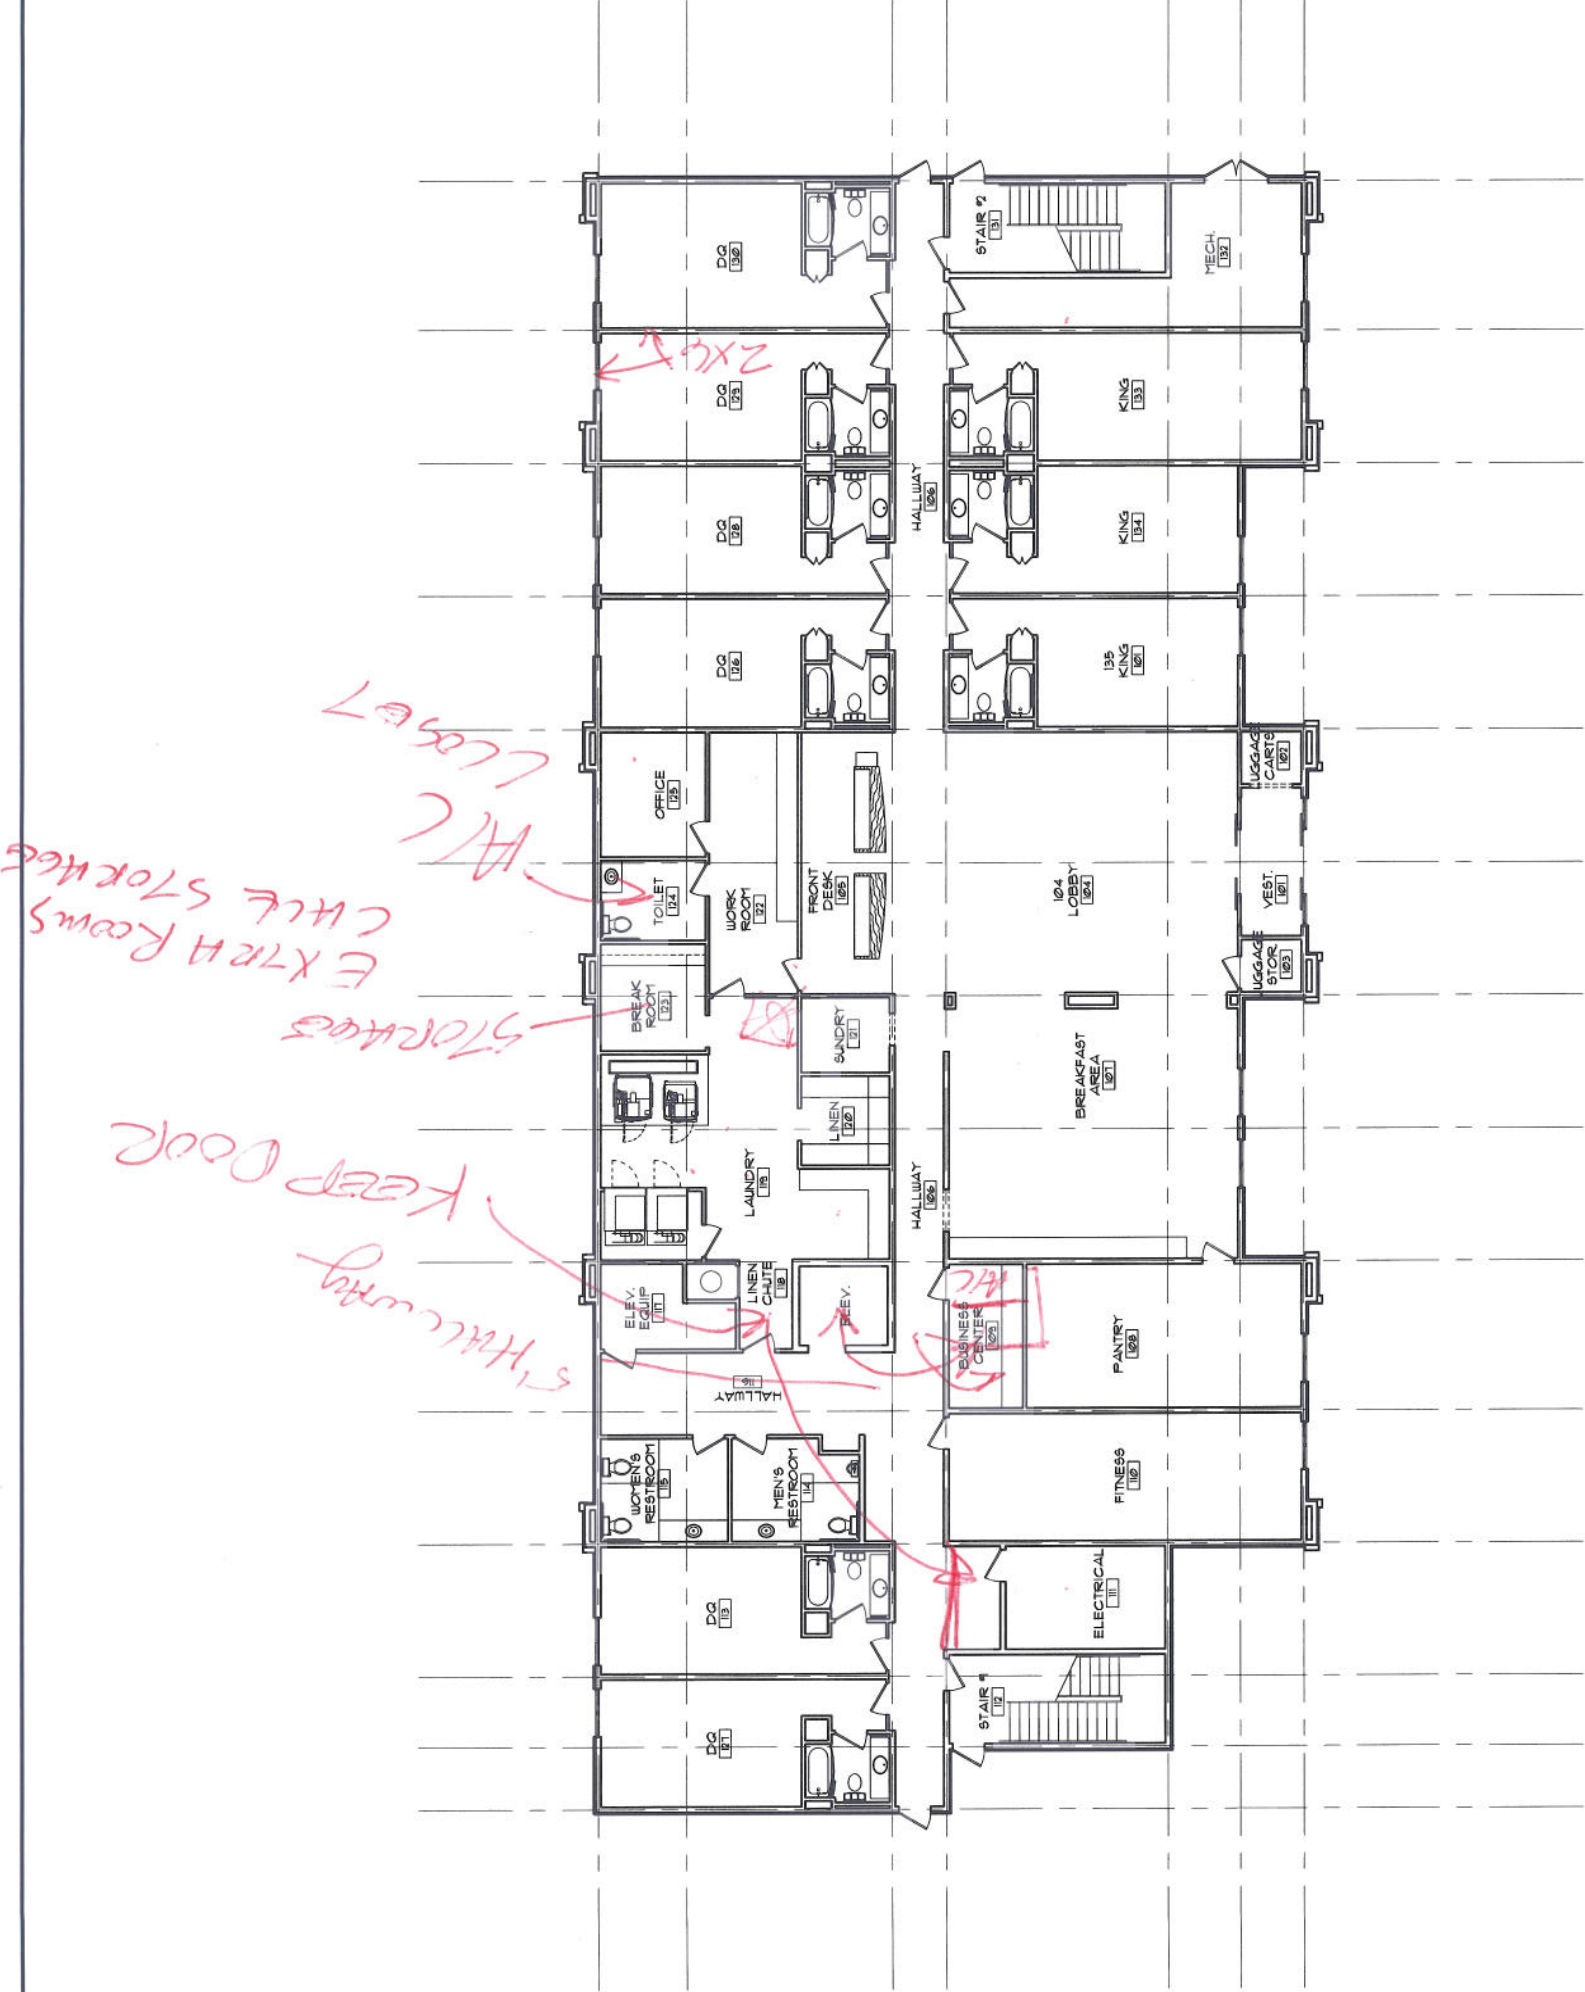

1ST FLOOR PLAN  
SCALE: 1/8" = 1'-0"  
TOTAL: 37,253 SF.

REVISIONS:

OWNER/DEVELOPER:  
MIKE DEGAI  
TEL: (601) 415-9919  
432 GARDEN GROVE STREET  
VICKSBURG, MS 39180




**N**  
NORMAN PATTEN & ASSOC.  
ARCHITECTURE & PLANNING  
413 CEDAR ST. @ MAIN - CEDAR HILL, TX 75104 - 972/293-2929  
npatten@flash.net

10-18-12  
DATE:

---  
JOB NO.

SHEET NO.

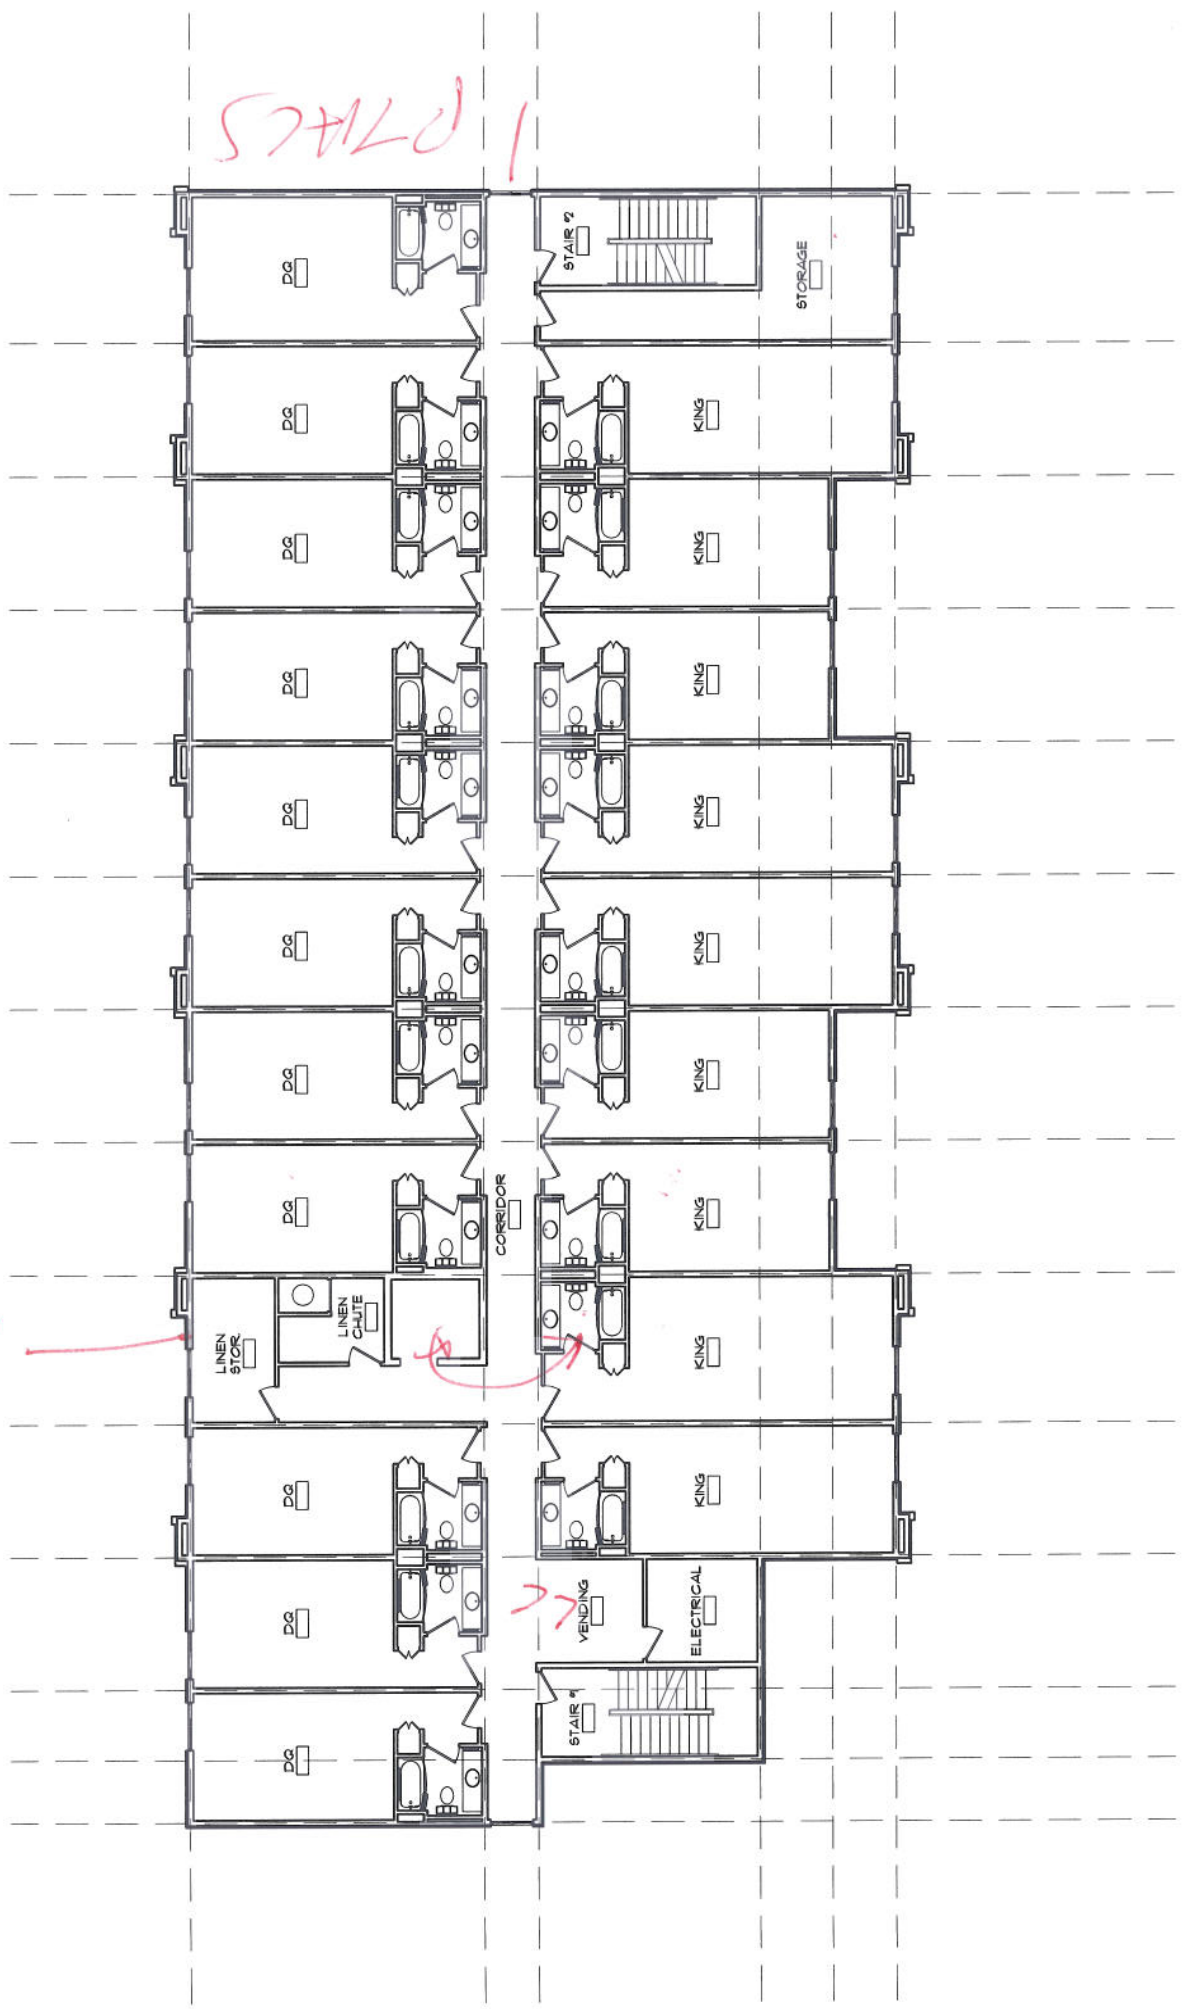

2ND-4TH FLOOR PLAN  
SCALE: 1/8" = 1'-0"

REVISIONS:

OWNER/DEVELOPER  
MIKE DESAI  
TEL: (601) 415-9519  
432 GARDEN GROVE STREET  
VICKSBURG, MS 39180




**N**  
NORMAN PATTEN & ASSOC.  
ARCHITECTURE & PLANNING  
413 CEDAR ST. @ MAIN - CEDAR HILL, TX 75104 - 972/ 293 - 2929  
npatten@flash.net


10-18-12  
DATE

---  
JOB NO.

SHEET NO.

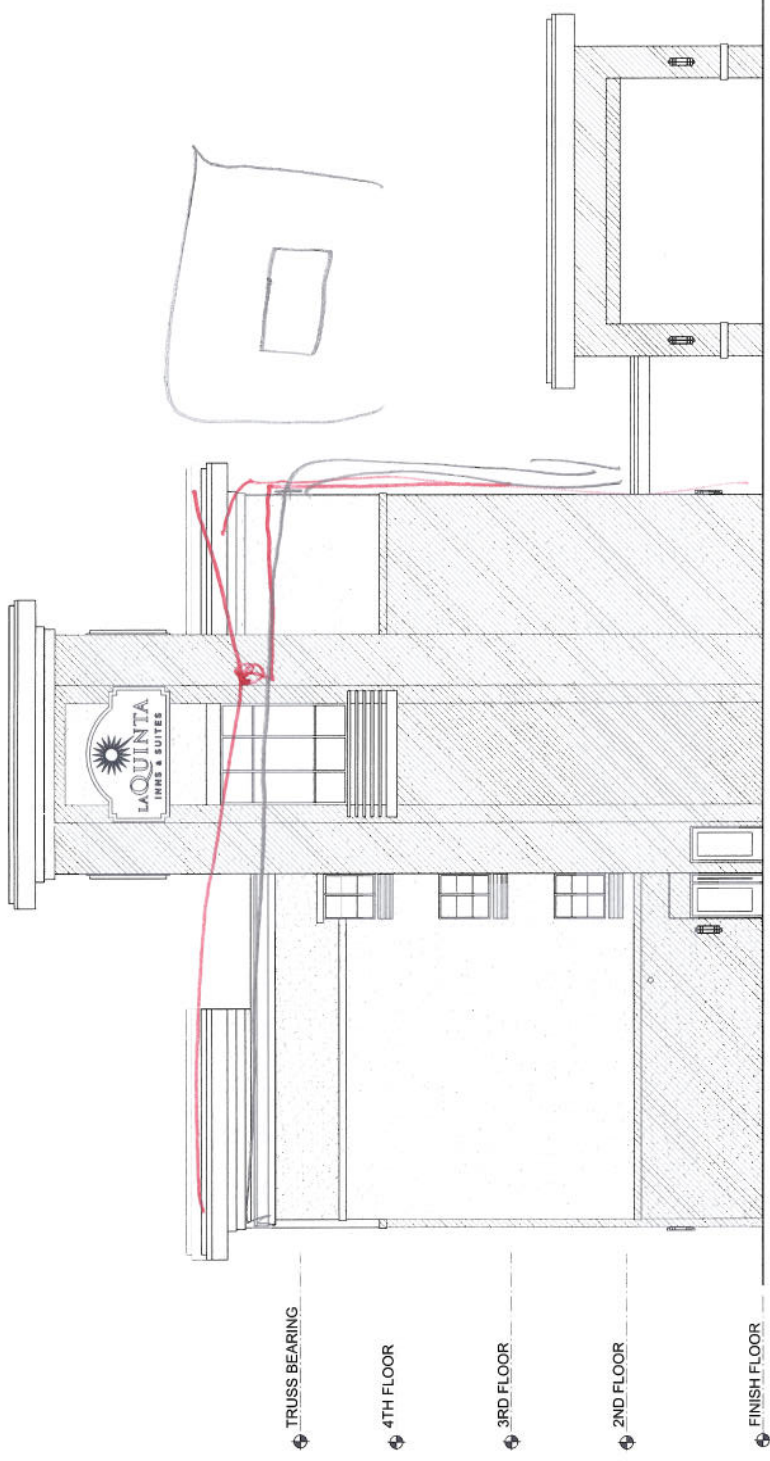

02-SIDE ELEVATION  
SCALE: 1/8" = 1'-0"

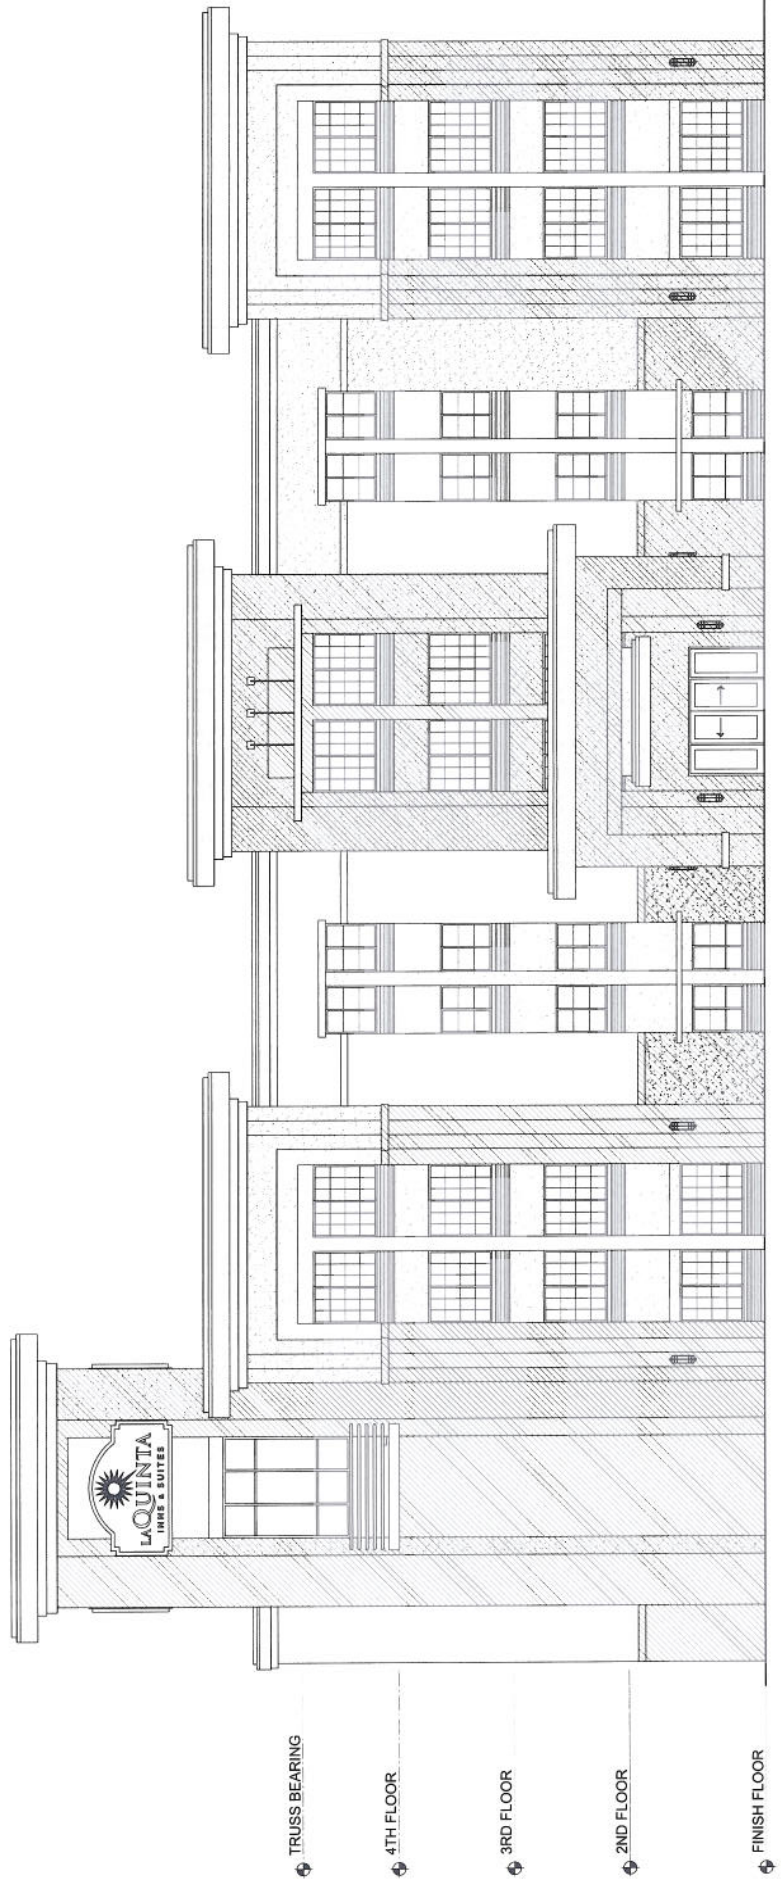

01-FRONT ELEVATION  
SCALE: 1/8" = 1'-0"