


DETAIL

SCALE: NONE

TYPICAL PANEL CORNER CONNECTIONS SECTION

SCALE: NONE

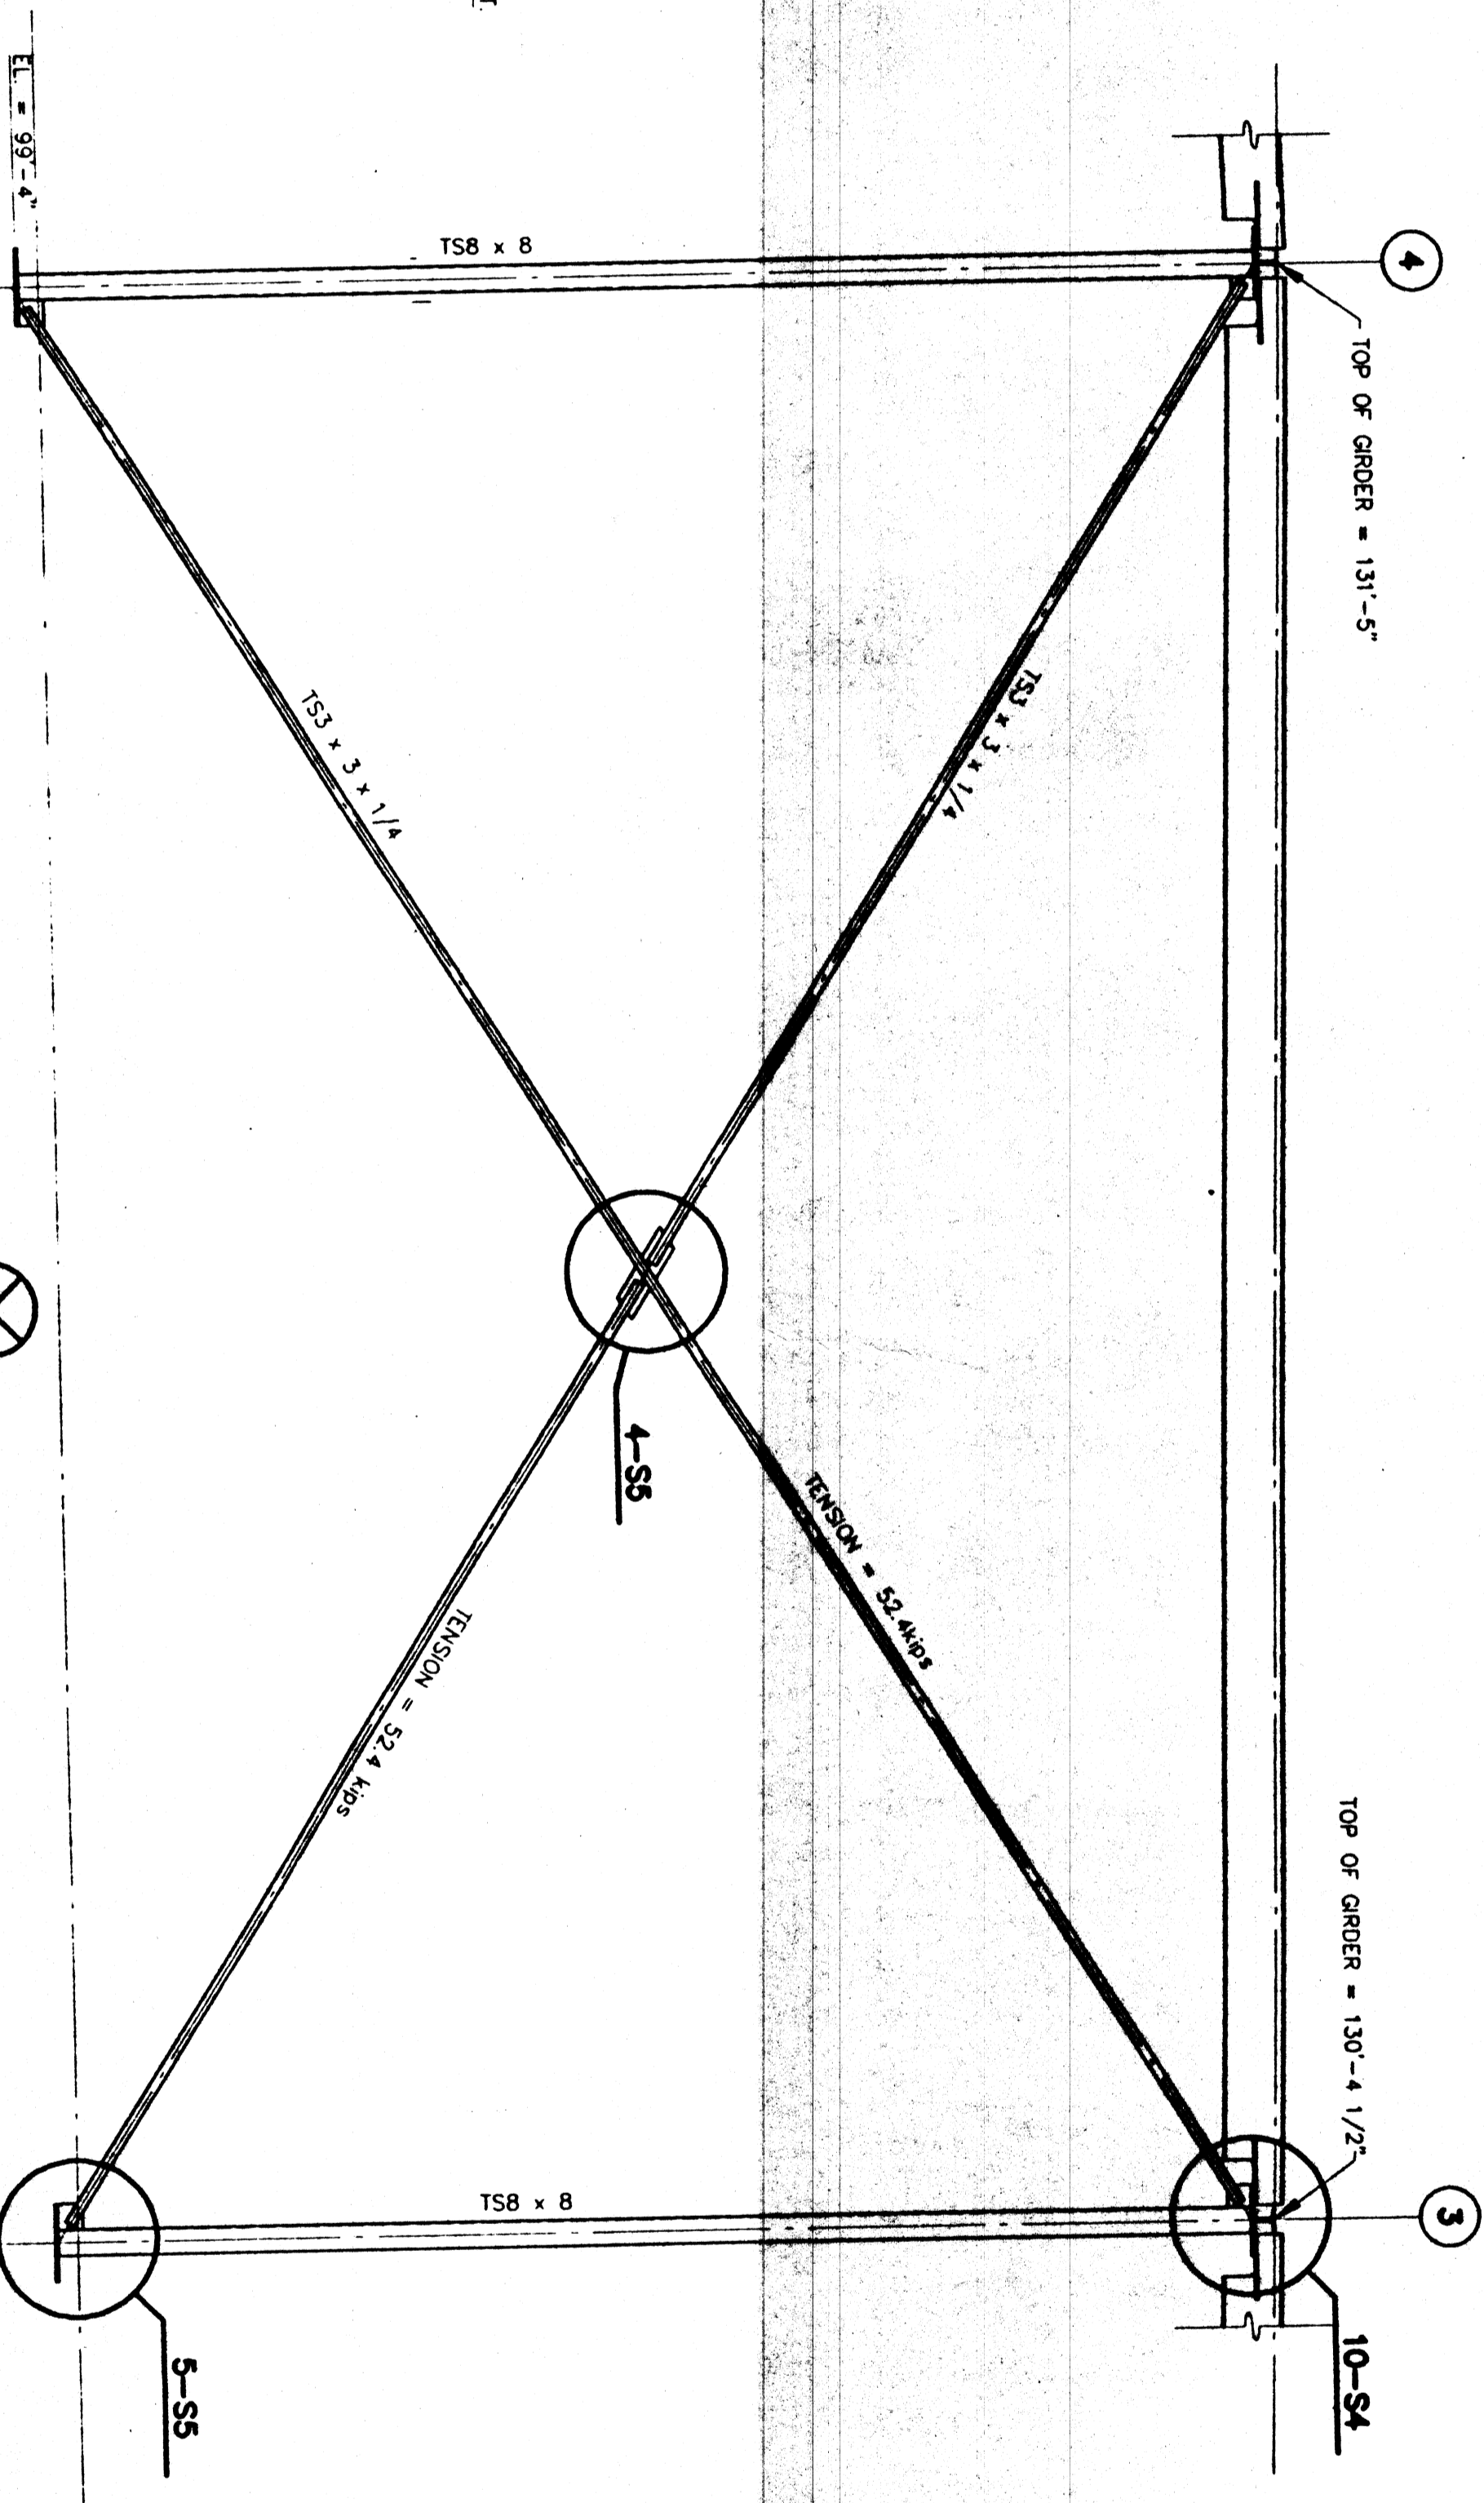

BRACE ELEVATION

SCALE: 1/4\"/>

GENERAL NOTES

1. FOUNDATIONS & WALL FOOTINGS HAVE BEEN PROPORTIONED FOR A NET ALLOWABLE SOIL BEARING PRESSURE OF 1500 PSF. SHEAR FOOTINGS HAVE BEEN PROPORTIONED FOR A NET ALLOWABLE SOIL BEARING PRESSURE OF 1000 PSF. FOUNDATIONS SHALL BE CONSTRUCTED IN ACCORDANCE WITH THE DESIGN CONCEPTS AND SPECIFICATIONS SET FORTH IN THE FOUNDATION REPORT DATED 6/9/97.
2. SOIL BEARING CAPACITY AND FOUNDATION DESIGN SHALL BE VERIFIED AT THE SITE BY A REGISTERED PROFESSIONAL ENGINEER.
3. BOTTOM OF FOOTINGS MUST EXTEND 1'-0\"/>

SECTION

SCALE: 3/4\"/>

SECTION

SCALE: 3/4\"/>

1. ALL STRUCTURAL STEEL DETAILS SHALL COMPLY WITH AISC SPECIFICATIONS FOR STRUCTURAL STEEL CONNECTIONS.
2. STRUCTURAL STEEL SHALL CONFORM TO THE FOLLOWING GRADES: A36 (FOR SLAB), A572 (FOR BEAM), A588 (FOR BRACE).
3. CHANNELS, ANGLES, PLATES, ETC. (LWD) SHALL BE GRADE A36.
4. ALL WELDS SHALL BE WELDED TO SUPPLEMENTARY STEEL WORK WITH (2) 1/2\"/>

AS-BUILTS

CONTRACTOR TO VERIFY ALL DIMENSIONS AND CONDITIONS OF EXISTING STRUCTURE AND TO REPORT ANY DISCREPANCIES TO THE ARCHITECT IMMEDIATELY UPON DISCOVERY.

<p><b>McKesson Drug Company</b> 232 Stone Road St. Louis, Missouri 63103</p> <p>Contractor: ARCO Design / Build</p> <p>Architect: Henderson Group</p>	<p>Civil Engineer: J.V. Burkes and Associates 2900 E. Gauss Blvd. - Suite B St. Louis, Missouri 63103</p> <p>Structural Engineer: J.V. Burkes and Associates 2900 E. Gauss Blvd. - Suite B St. Louis, Missouri 63103</p>
---	--

JOB # 10-1-97

DATE: 10-1-97

HC JOB # 97001-04

LOUISIANA TEMPORARY PERMIT NO. TP9735