

FILE NAME: C:\Users\jagyma\Documents\Projects\Dammon\Drawings\0101 - Site Plan.dwg DATE: 01/25/19 10:53:14 AM

N21°06'15"E 392.7'

S68°44'00"E 462.20'

SITE ENTRANCE



N68°53'45"W 462.20'

S21°06'15"W 390.99'

1 SITE PLAN  
SCALE: 1"= 20'-0"

**DAMMON**  
ENGINEERING, INC.  
LOUISIANA & MISSISSIPPI

www.dammonengineering.com  
info@dammonengineering.com  
PH: 985.649.9832

Chief Engineer: Brian Metch, PE  
504 Old Spanish Trail  
Slidell, LA 70688

#	DESCRIPTION	REVISIONS	DATE

SEAL:

RENOVATIONS  
P A P P A R T M E N T S

205 PARKVIEW BLVD  
MANDERLIE, LA 70471


JOB No: [ ] DATE: 01-25-19  
DRAWN BY: JAGYMA CHECKED BY: CKD

SHEET TITLE:  
SITE PLAN


DRAWING NUMBER:  
**C101**




FILE NAME: C:\Users\jdammon\OneDrive\Documents\Dammon\A102.dwg DATE: 01/25/19 TIME: 10:58:53 AM

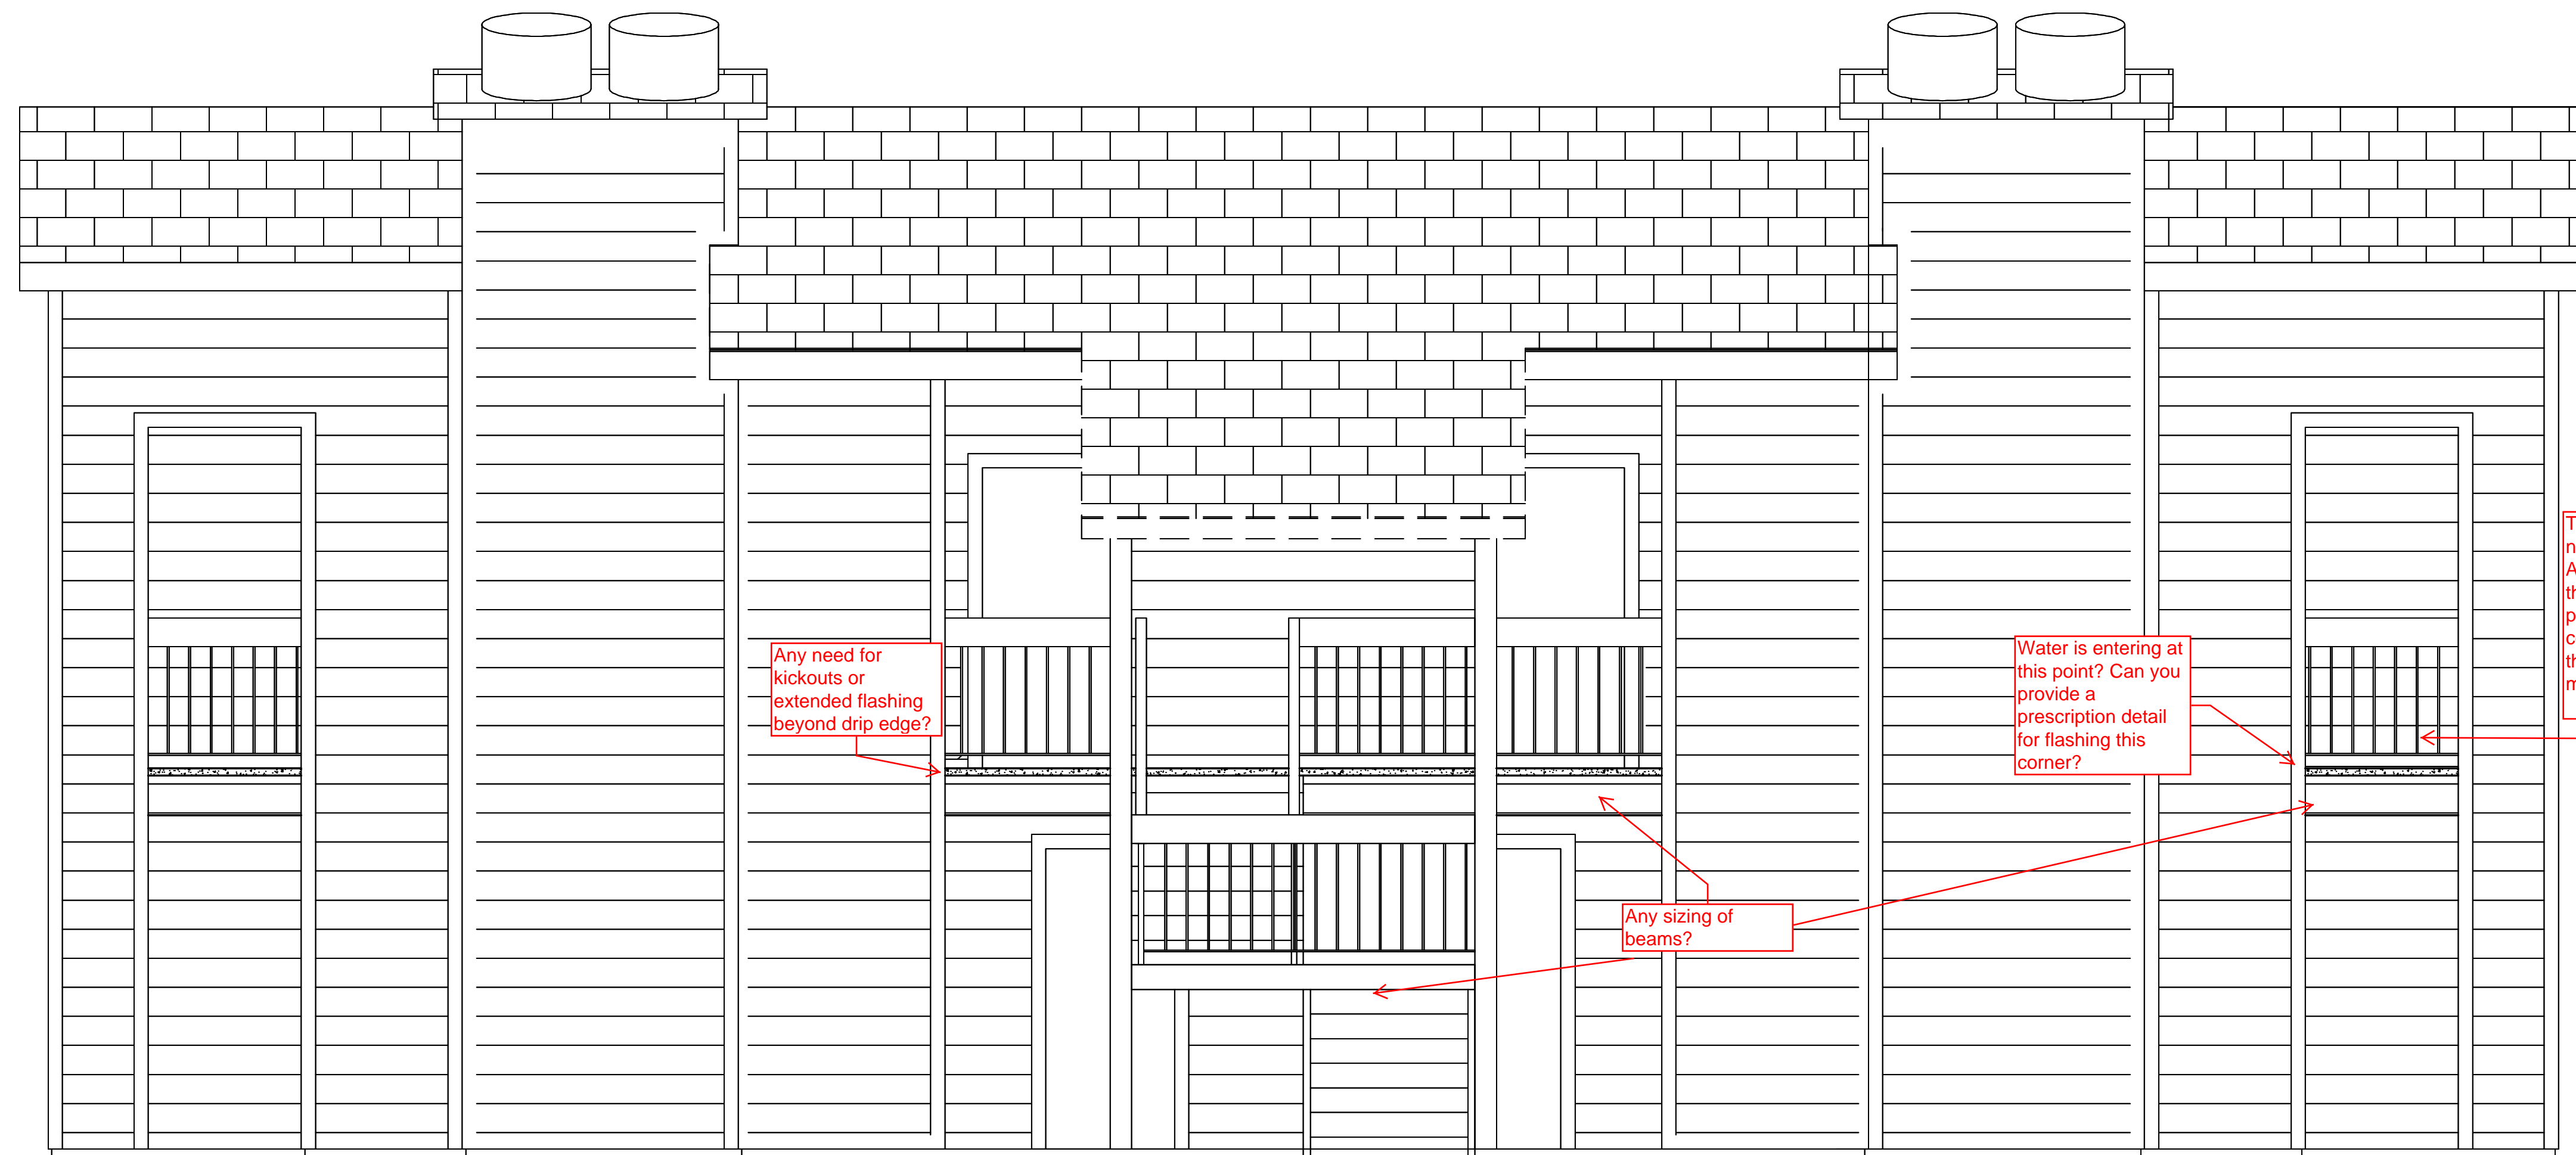


**4 BUILDING SECTION**  
SCALE: 3/8" = 1'-0"

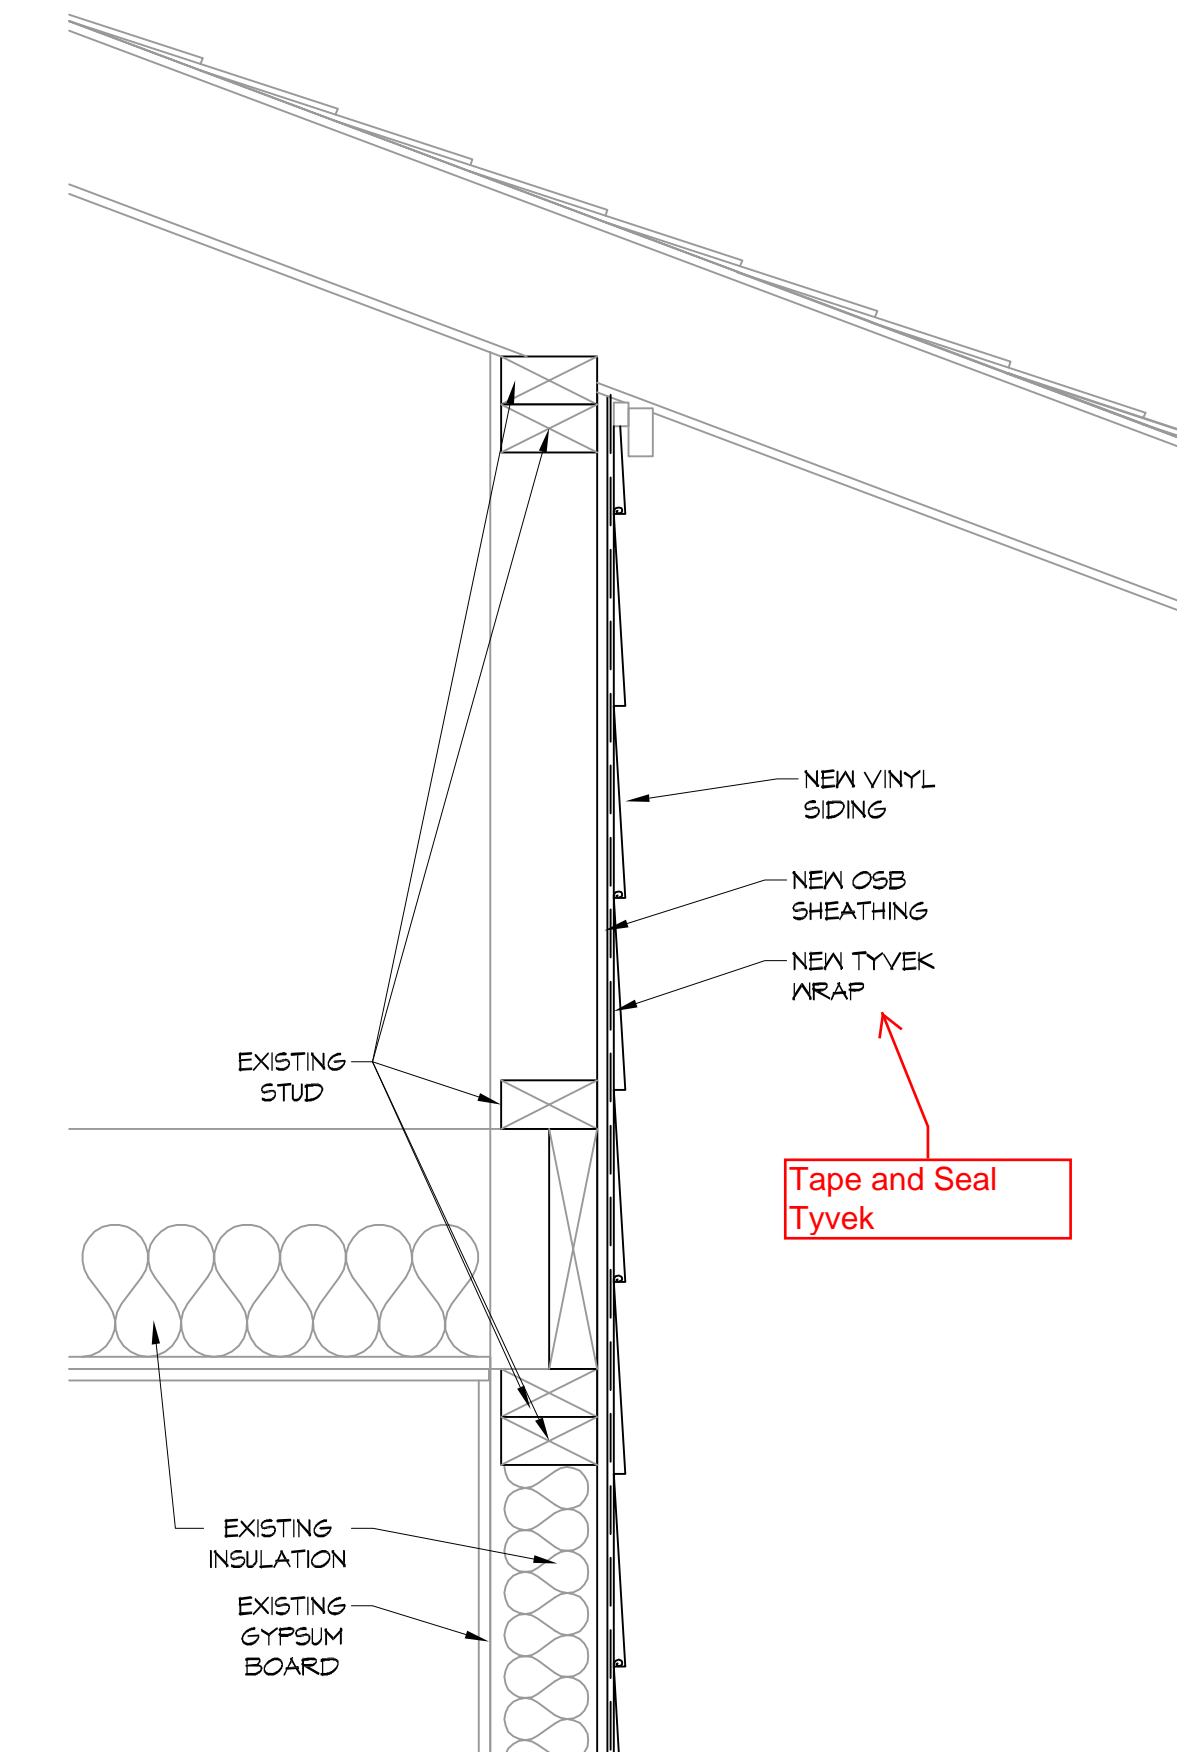

**7 VINYL WALL DETAIL**  
SCALE: 1-1/2" = 1'-0"

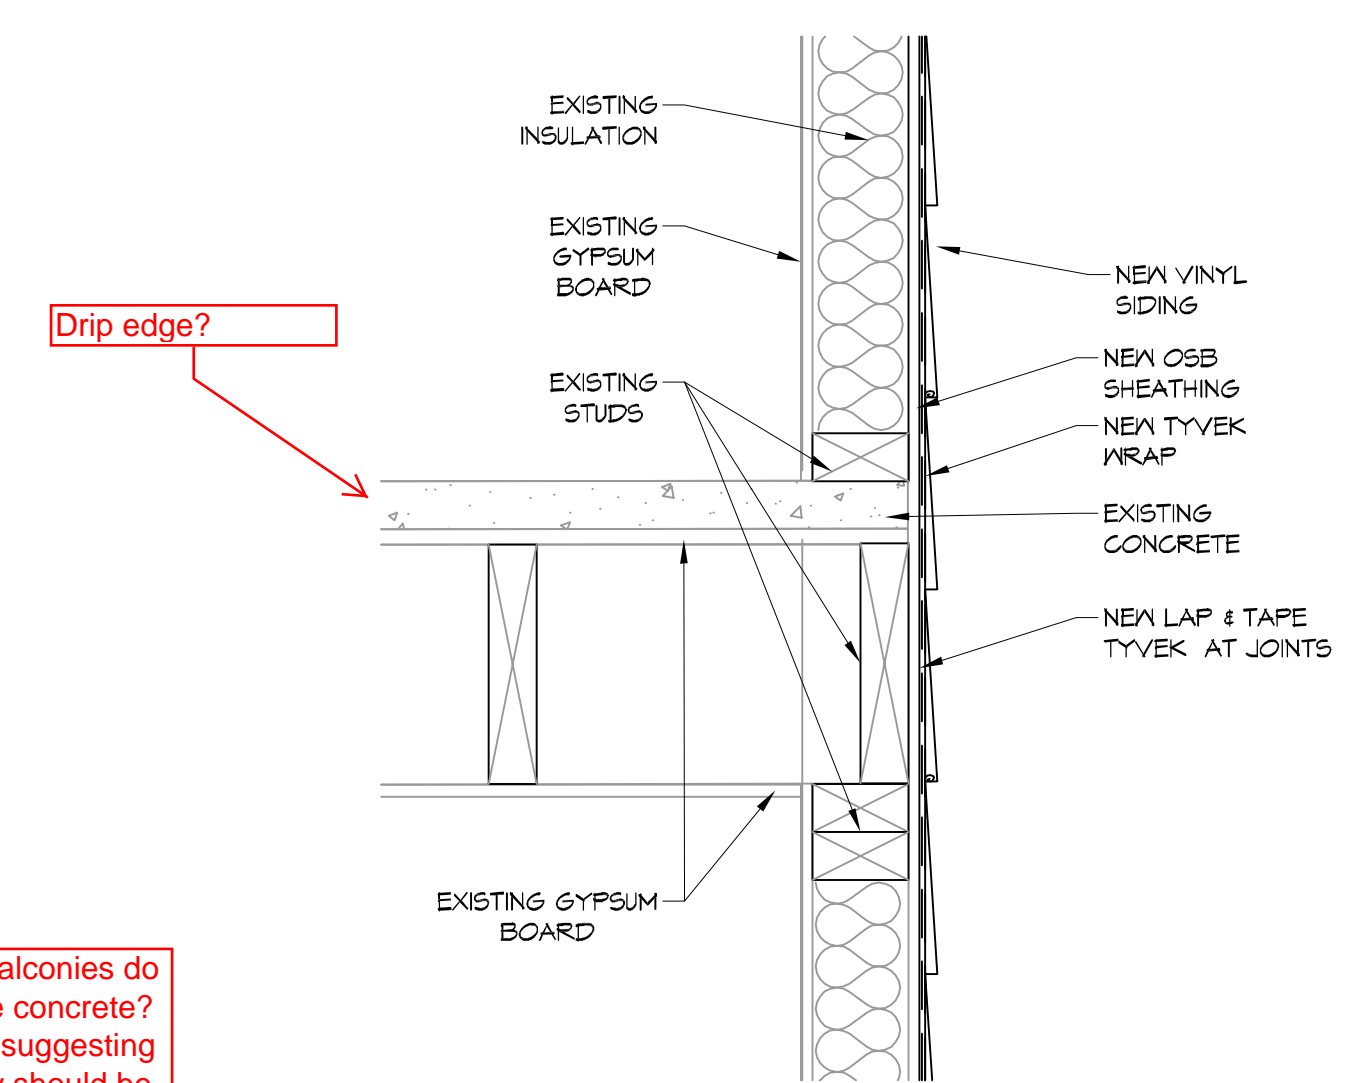

**6 VINYL WALL DETAIL**  
SCALE: 1-1/2" = 1'-0"

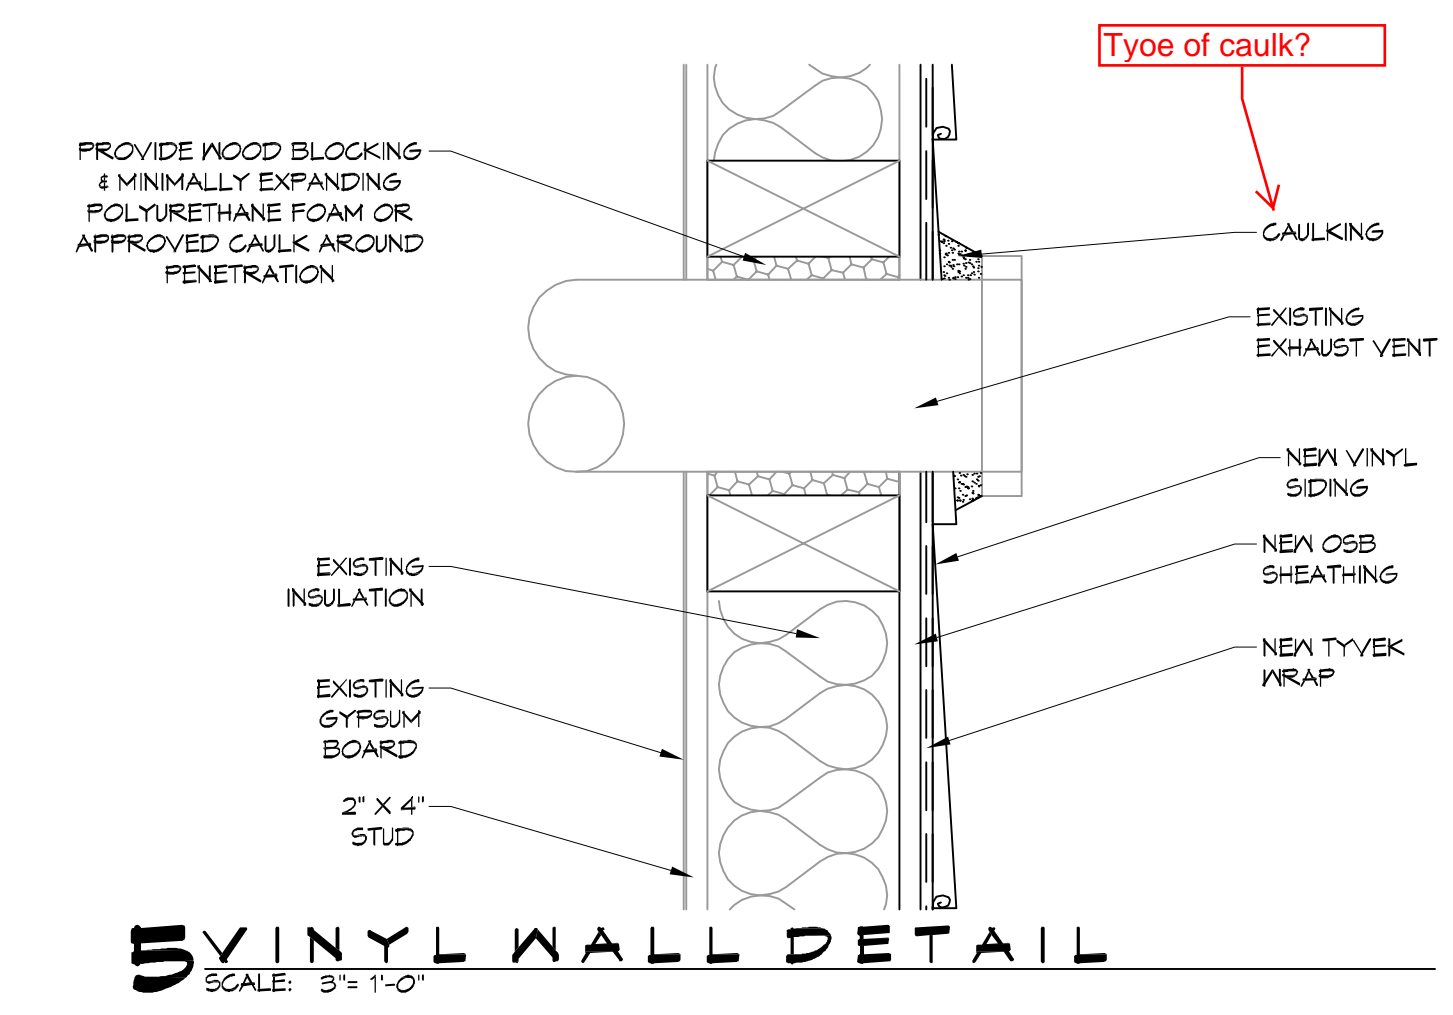

**5 VINYL WALL DETAIL**  
SCALE: 3/8" = 1'-0"

**DAMMON ENGINEERING, INC.**  
 LOUISIANA & MISSISSIPPI  
 Chief Engineer: Brian Metch, PE  
 504 Old Spanish Trail  
 Slidell, LA 70688  
 www.dammonengineering.com  
 info@dammonengineering.com  
 PH: 985.649.9832

#	DESCRIPTION	REVISIONS	DATE

SEAL:

**RENOVATIONS APARTMENTS**  
 205 PARKVIEW BLVD  
 MANDEVILLE, LA 70471  
 JOB No: [ ] DATE: 01-25-19  
 DRAWN BY: JASMAN CHECKED BY: CKD

SHEET TITLE:  
**BUILDING SECTION**

DRAWING NUMBER:  
**A102**