



## FAX TRANSMITTAL

Date: August 9, 2007

To: Brandon

Fax No: 641-5950

From: Keith Schleusener

Pages: (including cover sheet) 3

Project Name: Lakeshore Church

Project No:

Subject: Floor plan review


Message: We reviewed your latest floor plans and have enclosed some comments. These plans are now ready for you to start the design development documents. I have indicated an idea that we have for the ac unit over the offices with a single duct extending into the sanctuary. Please do the layout of air conditioning, lighting, receptacles, telephone and plumbing for us to reviewing prior to circuiting and sizing.

My friend has completed the new exterior elevations and we are meeting with Don on the costs. The only impact that they will have on the floor plans is in the foyer, which I indicate on the plans. I will be getting those to you very soon.

It is my understanding that we will have a well and sewer treatment plant on site. I am attempting to run that down right now.

Signed: 

123'-0"

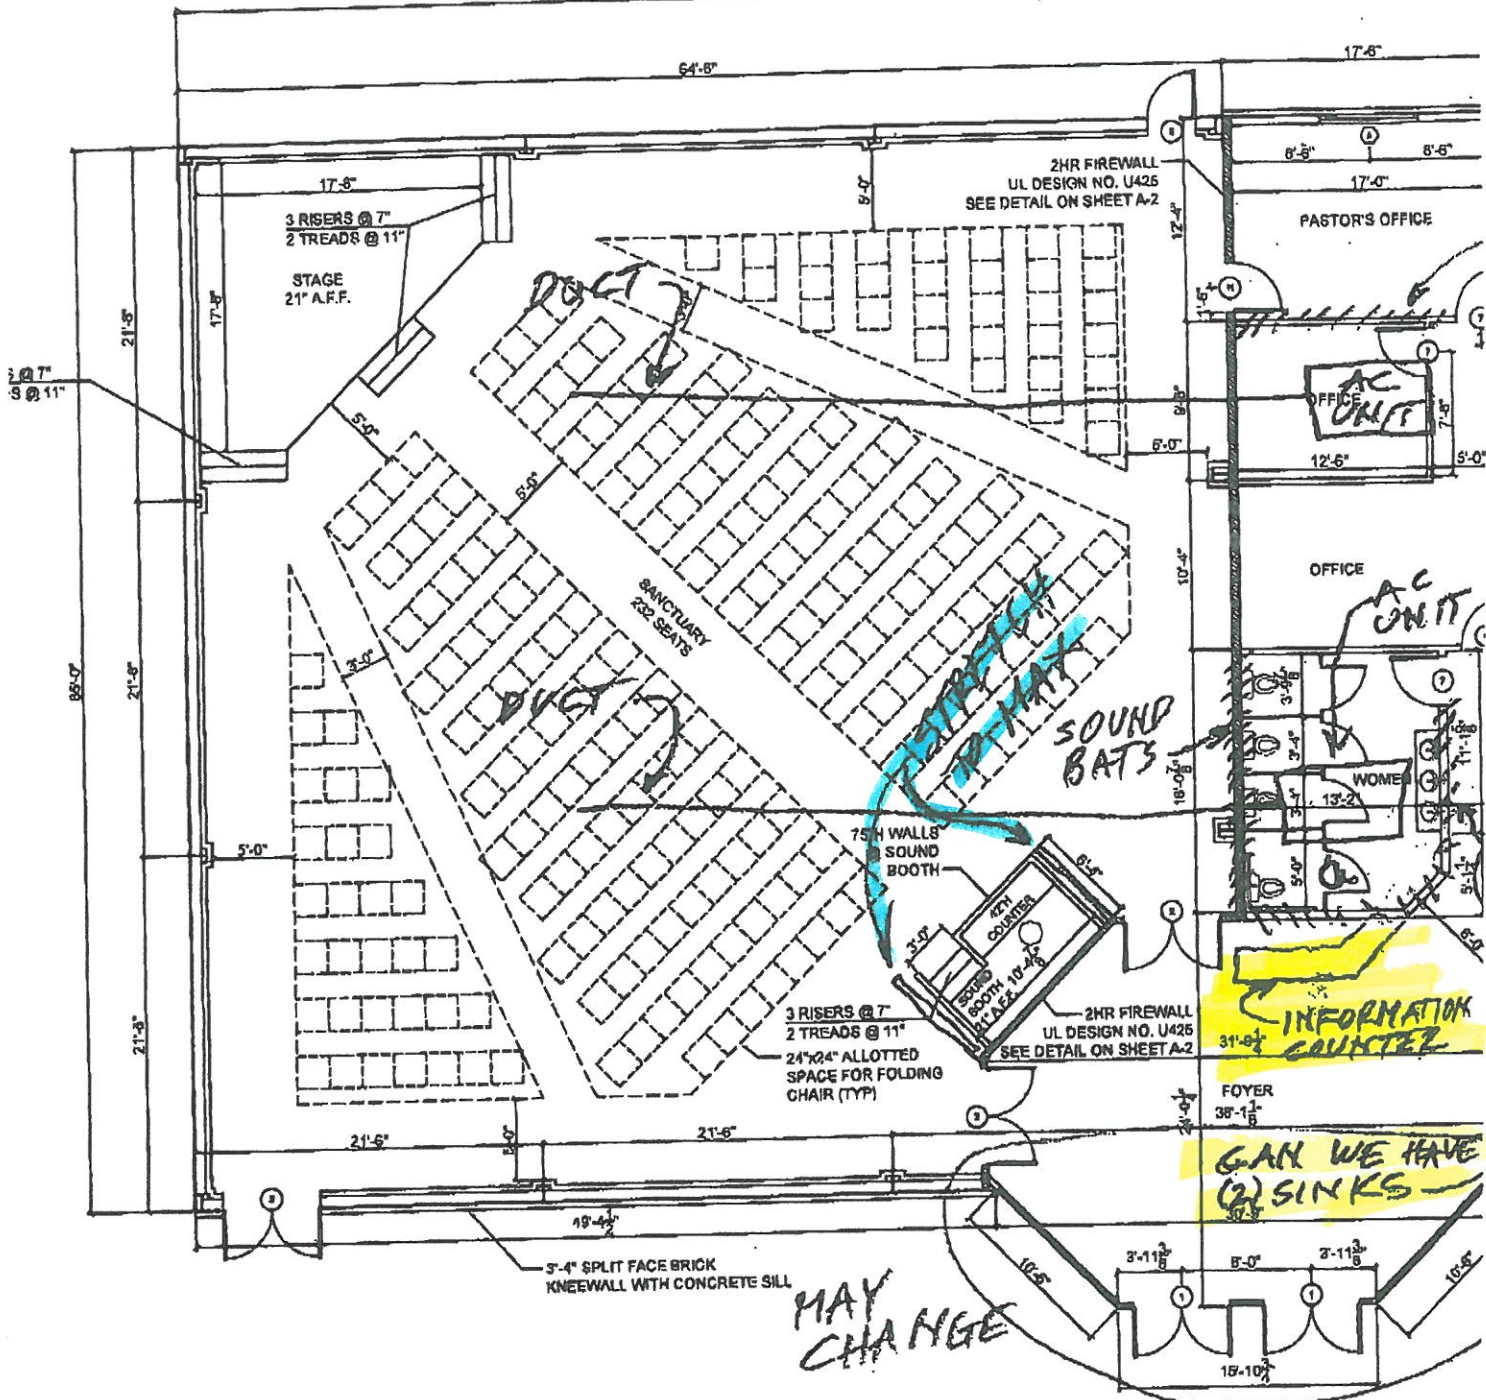


### GENERAL CONSTRUCTION NOTES

FLOOR PLAN  
SCALE 3/16"=1'-0"

AND INSULATION ASSEMBLIES SHALL MEET THE REQUIREMENTS IN 719.  
 D INSULATION SHALL HAVE A FLAME SPREAD OF 0-25 AND SMOKE INDEX OF 0-450, EXCEPT FOR  
 COMBUSTIBLE (WOOD FRAME) CONSTRUCTION.  
 ALL COMPLY WITH IBC 2003.  
 5' LANDINGS, LEVEL WITH FINISHED FLOOR, OUTSIDE EXTERIOR THRESHOLDS SHALL BE NOT MORE THAN 1/2" IN HEIGHT AND SHALL BE ED IF MORE THAN 1/4".  
 ARE TO CENTERLINE, FACE OF STUDS, CENTER OF COLUMNS, OR CENTER.  
 VERIFY TO VERIFY ALL SITE CONDITIONS, BUILDING LOCATIONS, AND CONDITIONS PRIOR TO CONSTRUCTION.  
 SHALL BE NEW AND U.L. LISTED.  
 SHALL BE CONCEALED UNTIL APPROVED BY LOCAL INSPECTORS.  
 SHALL COMPLY WITH ALL PARISH, STATE, AND LOCAL CODES.  
 TO GUARANTEE WORK FOR ONE YEAR.  
 SHALL FURNISH WATER AND POWER FROM EXISTING SOURCES.  
 SHALL BE THICK CAULK.  
 SHALL BE SHERWIN WILLIAMS OR EQUIVALENT. ALL WORK SHALL BE 3 COATS. COLOR SELECTION BY OWNER.  
 CLEANUP ON A REGULAR BASIS. NO TRASH STORED IN BUILDING.

14. USE 6" STUDS, OR 4" STAGGERED STUDS AT ALL PLUMBING WALLS.
15. PROVIDE GALVANIZED METAL PAN WITH DRAIN AT WATER HEATER LOCATION.
16. ALL CORNERS SHALL BE PROPERLY BRACED FOR WIND LOADS. A 45° SHEATHING SHALL BE PROVIDED EVERY 20 FEET OF WALL LENGTH.
17. FLOORING SHALL BE NON-SLIP.
18. INTERIOR LOCKS ON DOORS IN MEANS OF EGRESS SHALL NOT REQUIRE THE USE OF A KEY, SPECIAL KNOWLEDGE, OR SPECIAL DEVICE TO OPEN IN THE DIRECTION OF EGRESS. ALL DOORS SHALL HAVE LEVER TYPE HANDLES.
19. INTERIOR WALLS AND CEILING SHALL HAVE A FLAME SPREAD OF 76-200 AND A SMOKE DEVELOPMENT RATING OF 0-450 ACCORDING TO IBC 2003 SECTION 803.1.
20. ALL WORK SHALL COMPLY WITH THE LATEST EDITION OF ALL LOCAL, STATE, AND NATIONAL CODES COVERING THE TYPE OF WORK BEING PERFORMED.
21. PROVIDE PORTABLE FIRE EXTINGUISHERS IN ACCORDANCE WITH NFPA 101. SEE APPENDIX "E" OF NFPA 101 FOR DISTRIBUTION OF EXTINGUISHERS.
22. ALL FIRE WALLS SHALL EXTEND TIGHT TO ROOF SHEATHING, AND BE SEALED WITH AN APPROVED FIRE CAULK.
23. ALL ELECTRICAL, MECHANICAL, AND PLUMBING MATERIALS PENETRATING FIRE WALLS SHALL BE FIRE CAULKED. (PENETRATIONS THROUGH RATED CONSTRUCTION SHALL BE SEALED WITH A MATERIAL CAPABLE OF PREVENTING THE PASSAGE OF FLAMES AND HOT GASES IN ACCORDANCE WITH IBC 2003 SECTION 712.)
24. OFFICE COUNTER SHALL HAVE A HCP ACCESSIBLE WRITING SURFACE, MAX.

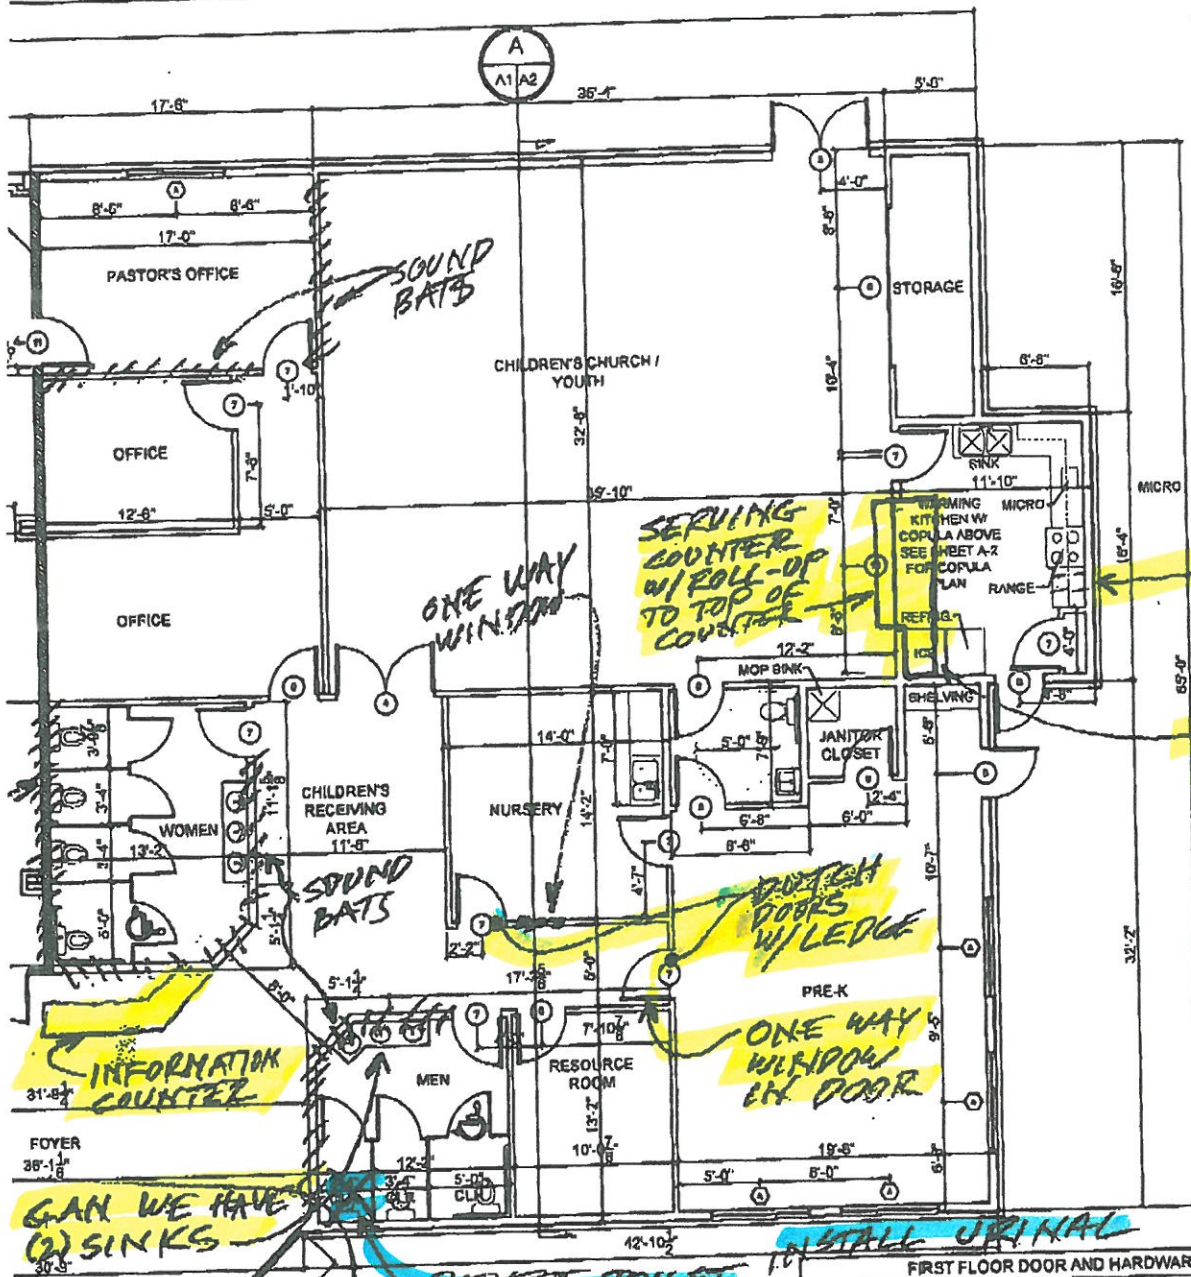

FLOOR PLAN  
1. AVENUE CHURCH

FLOOR PLAN  
SCALE: 3/16"=1'-0"

**OCCUPANT LOAD:**

- OCCUPANCY CLASSIFICATION PER IBC 2003 (SECTION 303.1) ASSEMBLY GROUP: A-3
- OCCUPANT LOADS ARE CALCULATED PER VALUES GIVEN BY NFPA 101, 2003, TABLE 7.3.1.2

TOTAL BLDG. = 7,895 SQ. FT.  
 SANCTUARY = 4,180 SQ. FT. (NON-FIXED SEATING)  
 232 OCCUPANTS  
 ASSEMBLY AREA = 3,680 SQ. FT. @ 15/OCCUPANT  
 242 OCCUPANTS  
 WARMING KITCHEN AREA = 175 SQ. FT. @ 100/OCCUPANT  
 2 OCCUPANTS  
 TOTAL OCCUPANTS = 478 OCCUPANTS

**FIRST FLOOR DOOR AND HARDWARE SCHEDULE**

| NO. | TYPE | FINISH | LOCK | ACCESS | REMARKS |
|-----|------|--------|------|--------|---------|
| 1   | ...  | ...    | ...  | ...    | ...     |
| 2   | ...  | ...    | ...  | ...    | ...     |
| 3   | ...  | ...    | ...  | ...    | ...     |
1. DOORS IN PATH OF EGRESS SHALL BE READILY OPERABLE FROM THE EXTERIOR SIDE WITHOUT THE USE OF A KEY OR SPECIAL KNOWLEDGE OR EFFORT. (IBC 703 - 1.10.1.1)  
 2. A READILY OPERABLE FROM SHALL BE PROVIDED ON THE EXTERIOR SIDE OR ADJACENT TO THE DOOR BY OTHER MEANS.  
 THE DOOR SHALL BE IN LETTING 1" (MIN) HIGH ON A CONTRASTING BACKGROUND. (IBC 703 - 1.10.1.1.2)  
 3. ALL HINGERS SHALL HAVE SMOOTH EDGES.  
 4. ALL EXTERIOR DOORS SHALL BE RATED FOR 20 MINUTE LOUVER.

**WINDOW SCHEDULE**

| NO. | TYPE | FINISH | ACCESS | REMARKS |
|-----|------|--------|--------|---------|
| 1   | ...  | ...    | ...    | ...     |
| 2   | ...  | ...    | ...    | ...     |
| 3   | ...  | ...    | ...    | ...     |
**FIRST FLOOR FINISH SCHEDULE**

| NO. | ROOM | FINISH | REMARKS |
|-----|------|--------|---------|
| 1   | ...  | ...    | ...     |
| 2   | ...  | ...    | ...     |
| 3   | ...  | ...    | ...     |
OWNER TO VERIFY STYLE, COLOR AND BRAND  
 (OWNER TO PROVIDE TO BE INSTALLED IN LOCATIONS INDICATED BY OWNER)