



SECTION LOOKING TOWARDS IBERVILLE STREET.

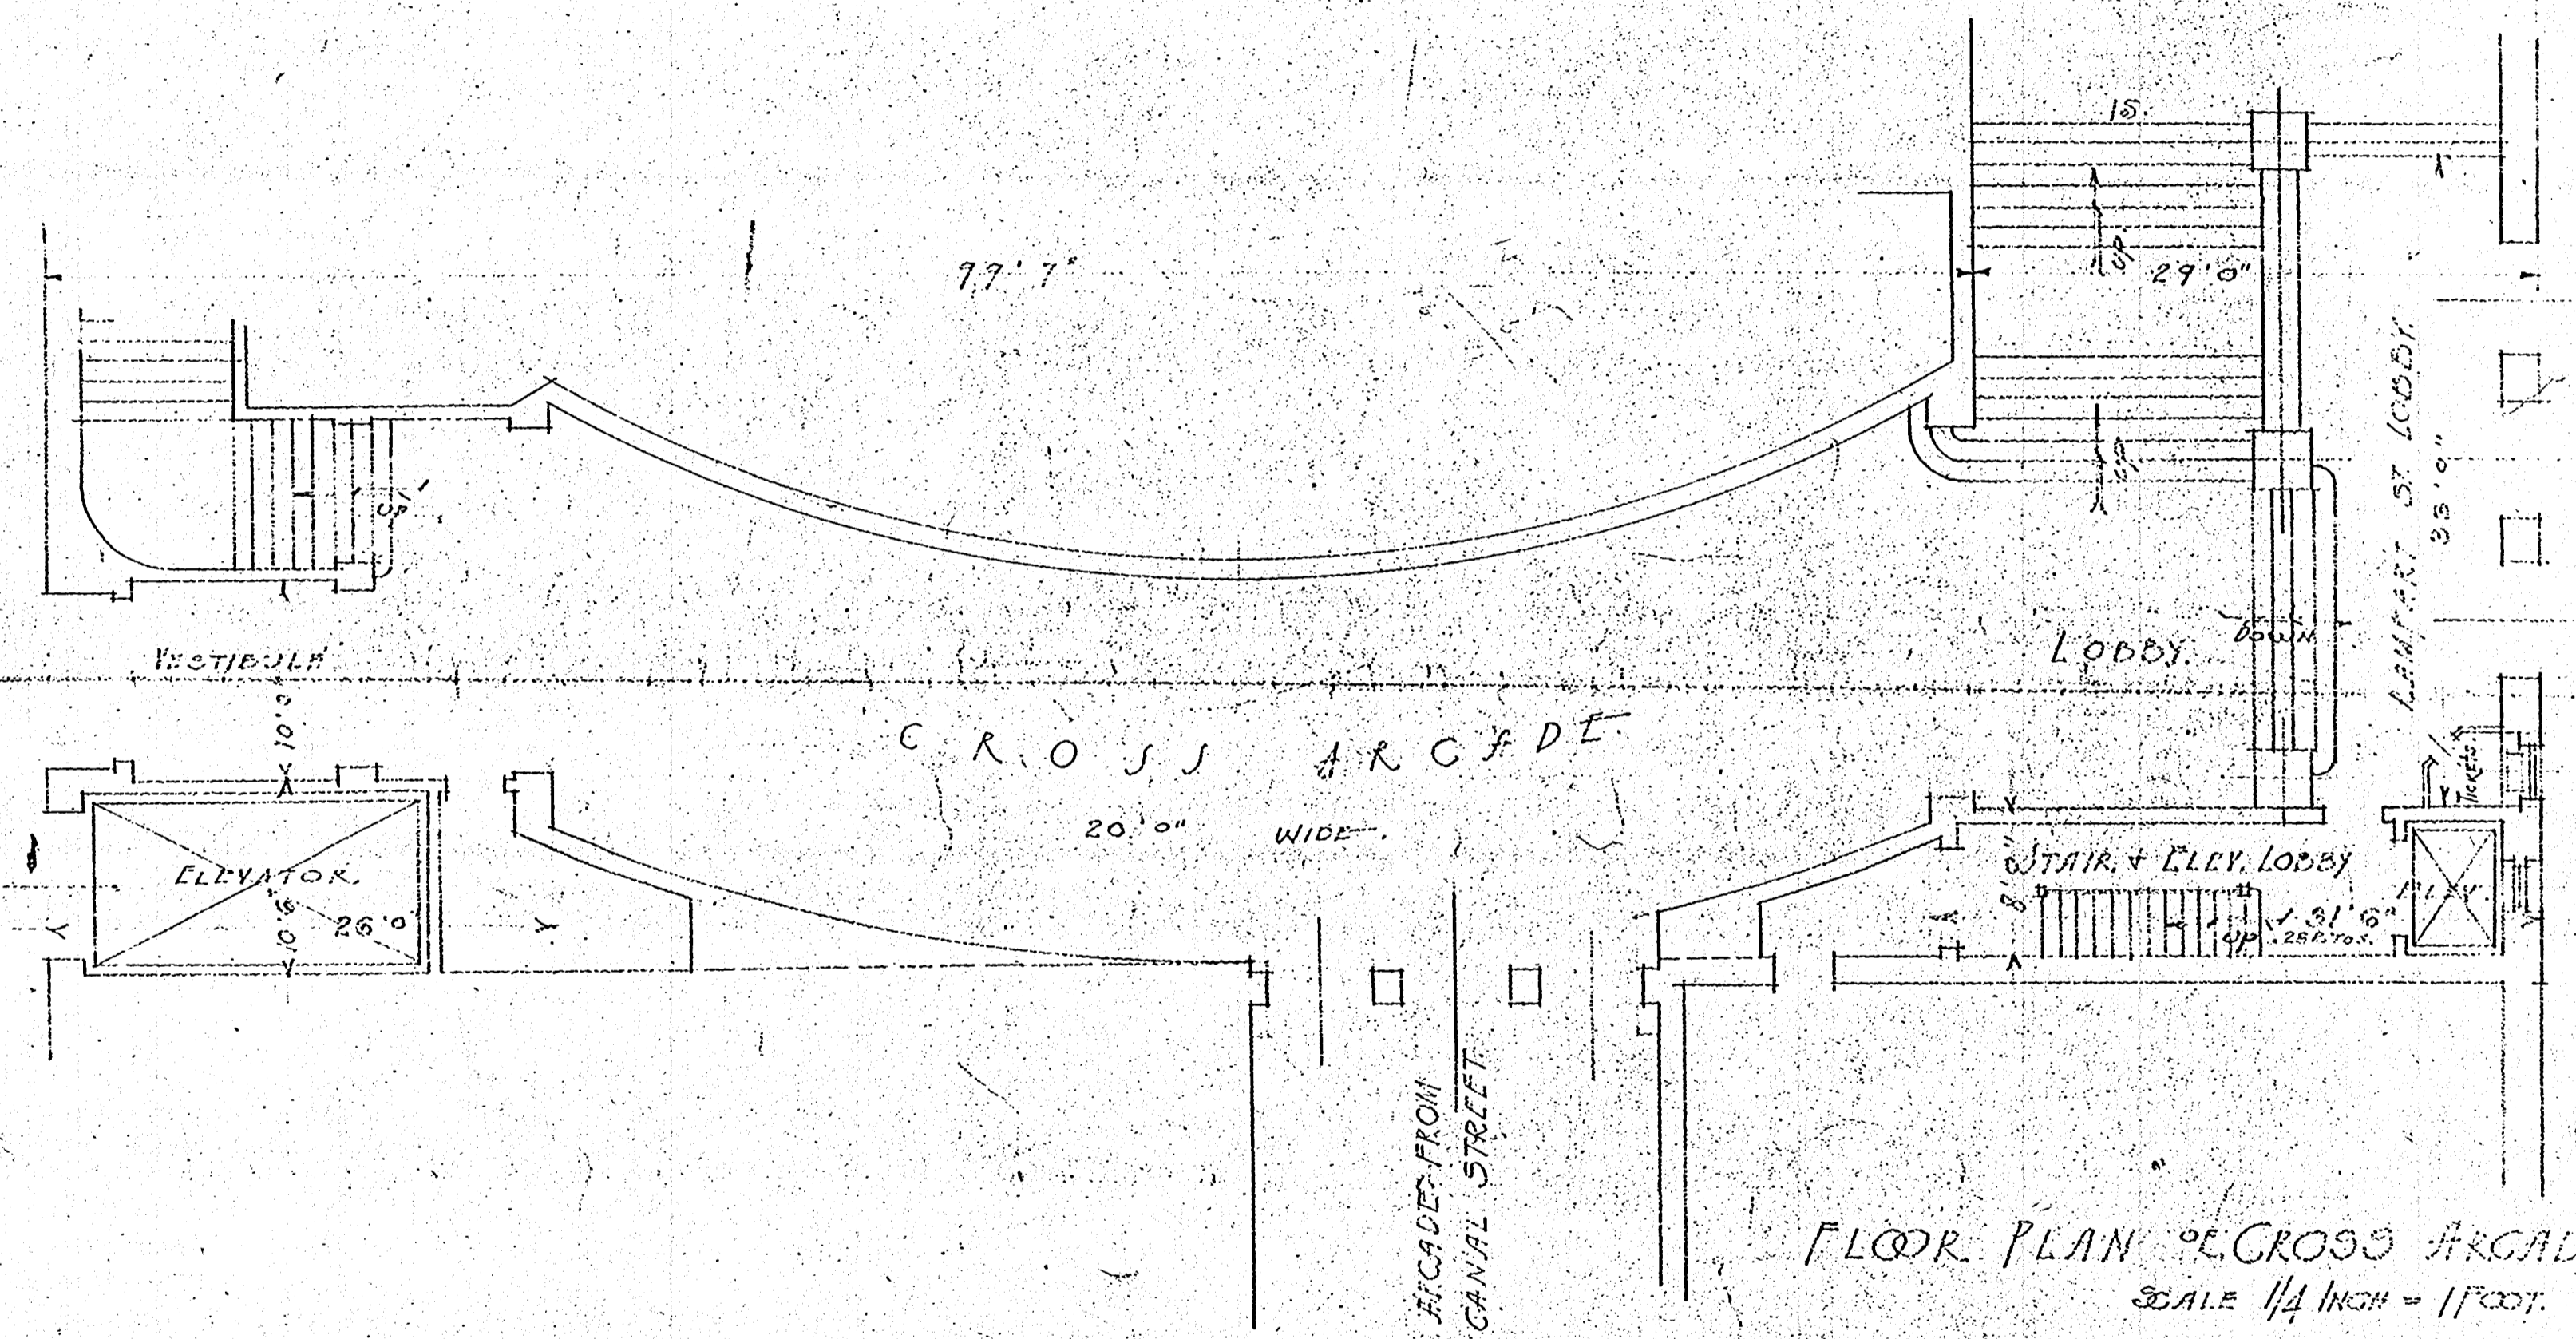

FLOOR PLAN OF CROSS ARCADE
SCALE 1/4 INCH = 1 FOOT.

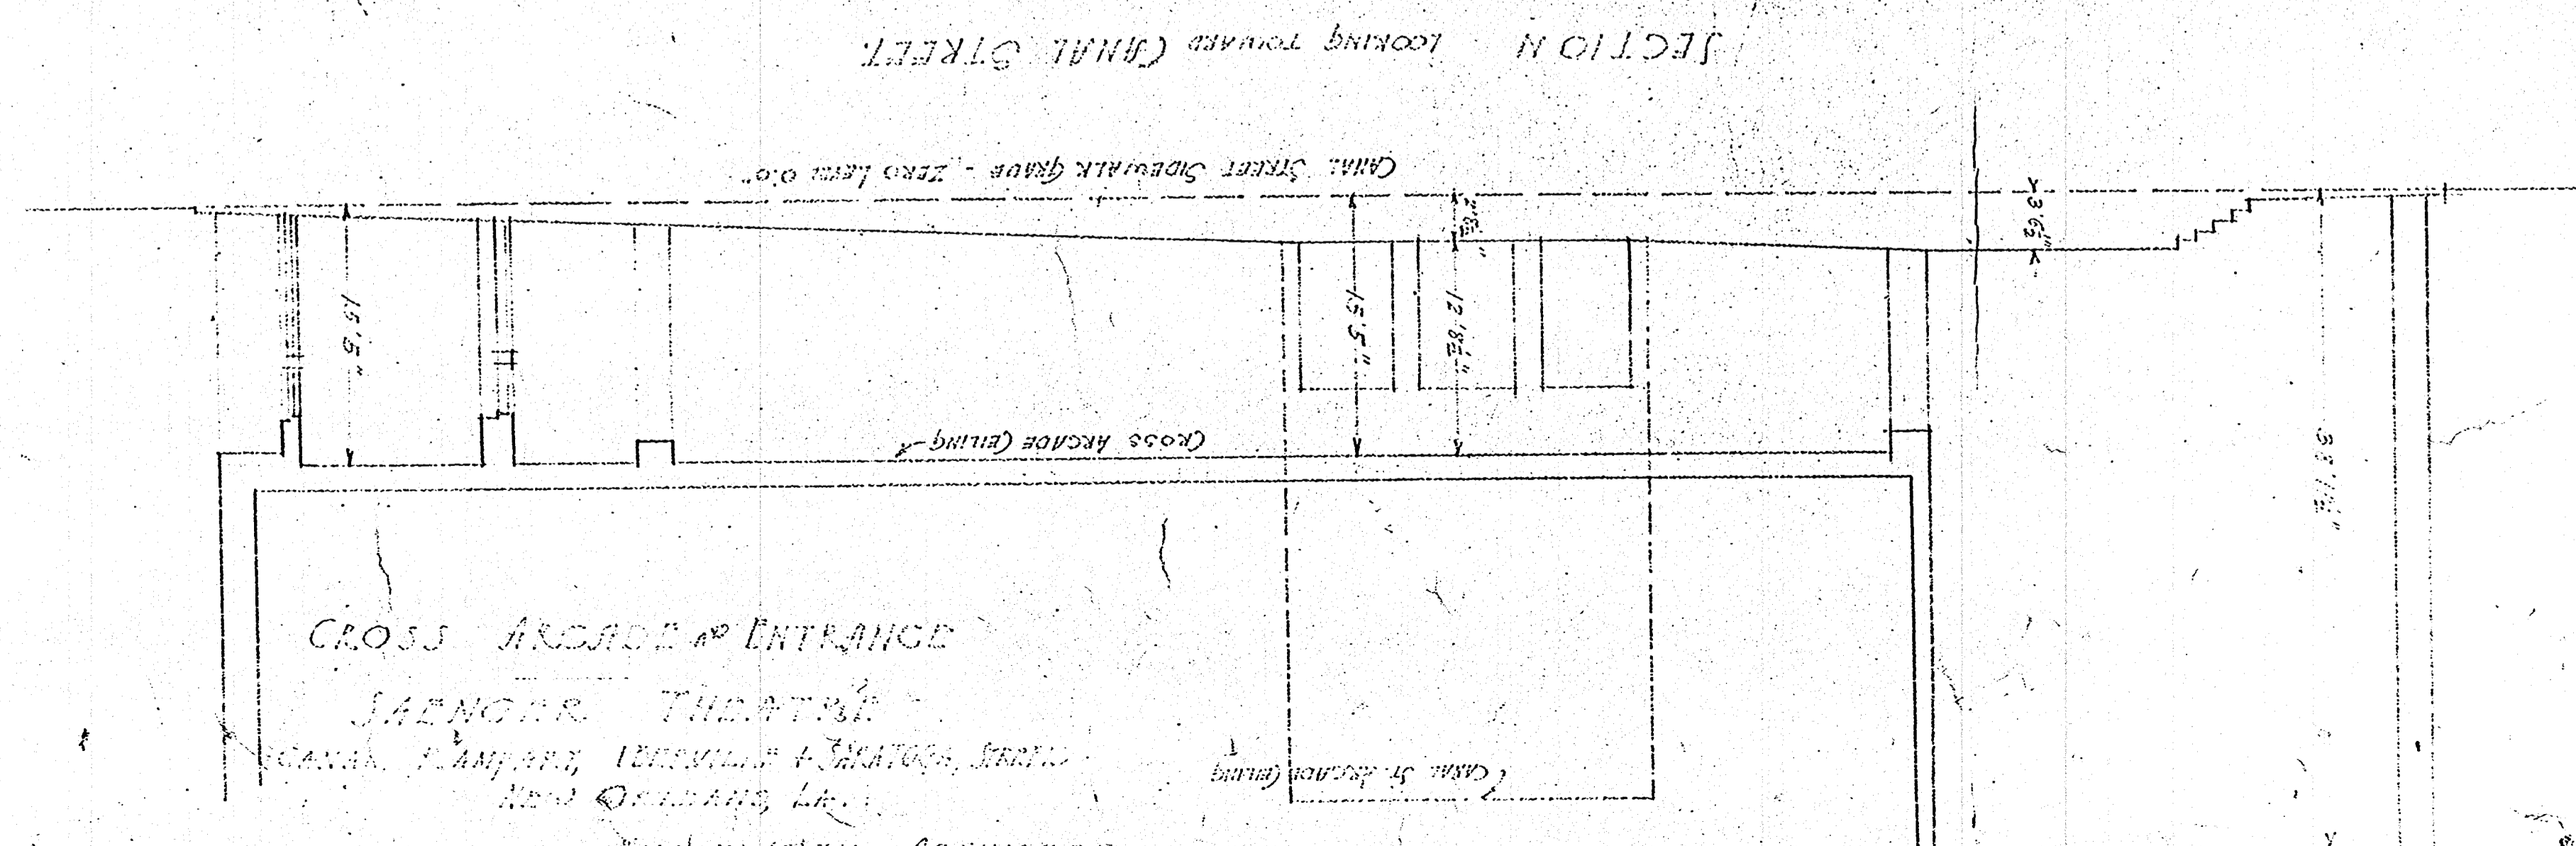

SECTION N. LOOKING TOWARDS CANAL STREET.

CROSS ARCADE ENTRANCE
 JAENOR THEATRE
 CANAL STREET, IBERVILLE & TANTOGE STREETS
 NEW ORLEANS, LA.
 HALEY WELLS ARCHITECTS
 100 CANAL STREET
 NEW ORLEANS, LA.