



SECTION LOOKING TOWARD IBERVILLE STREET

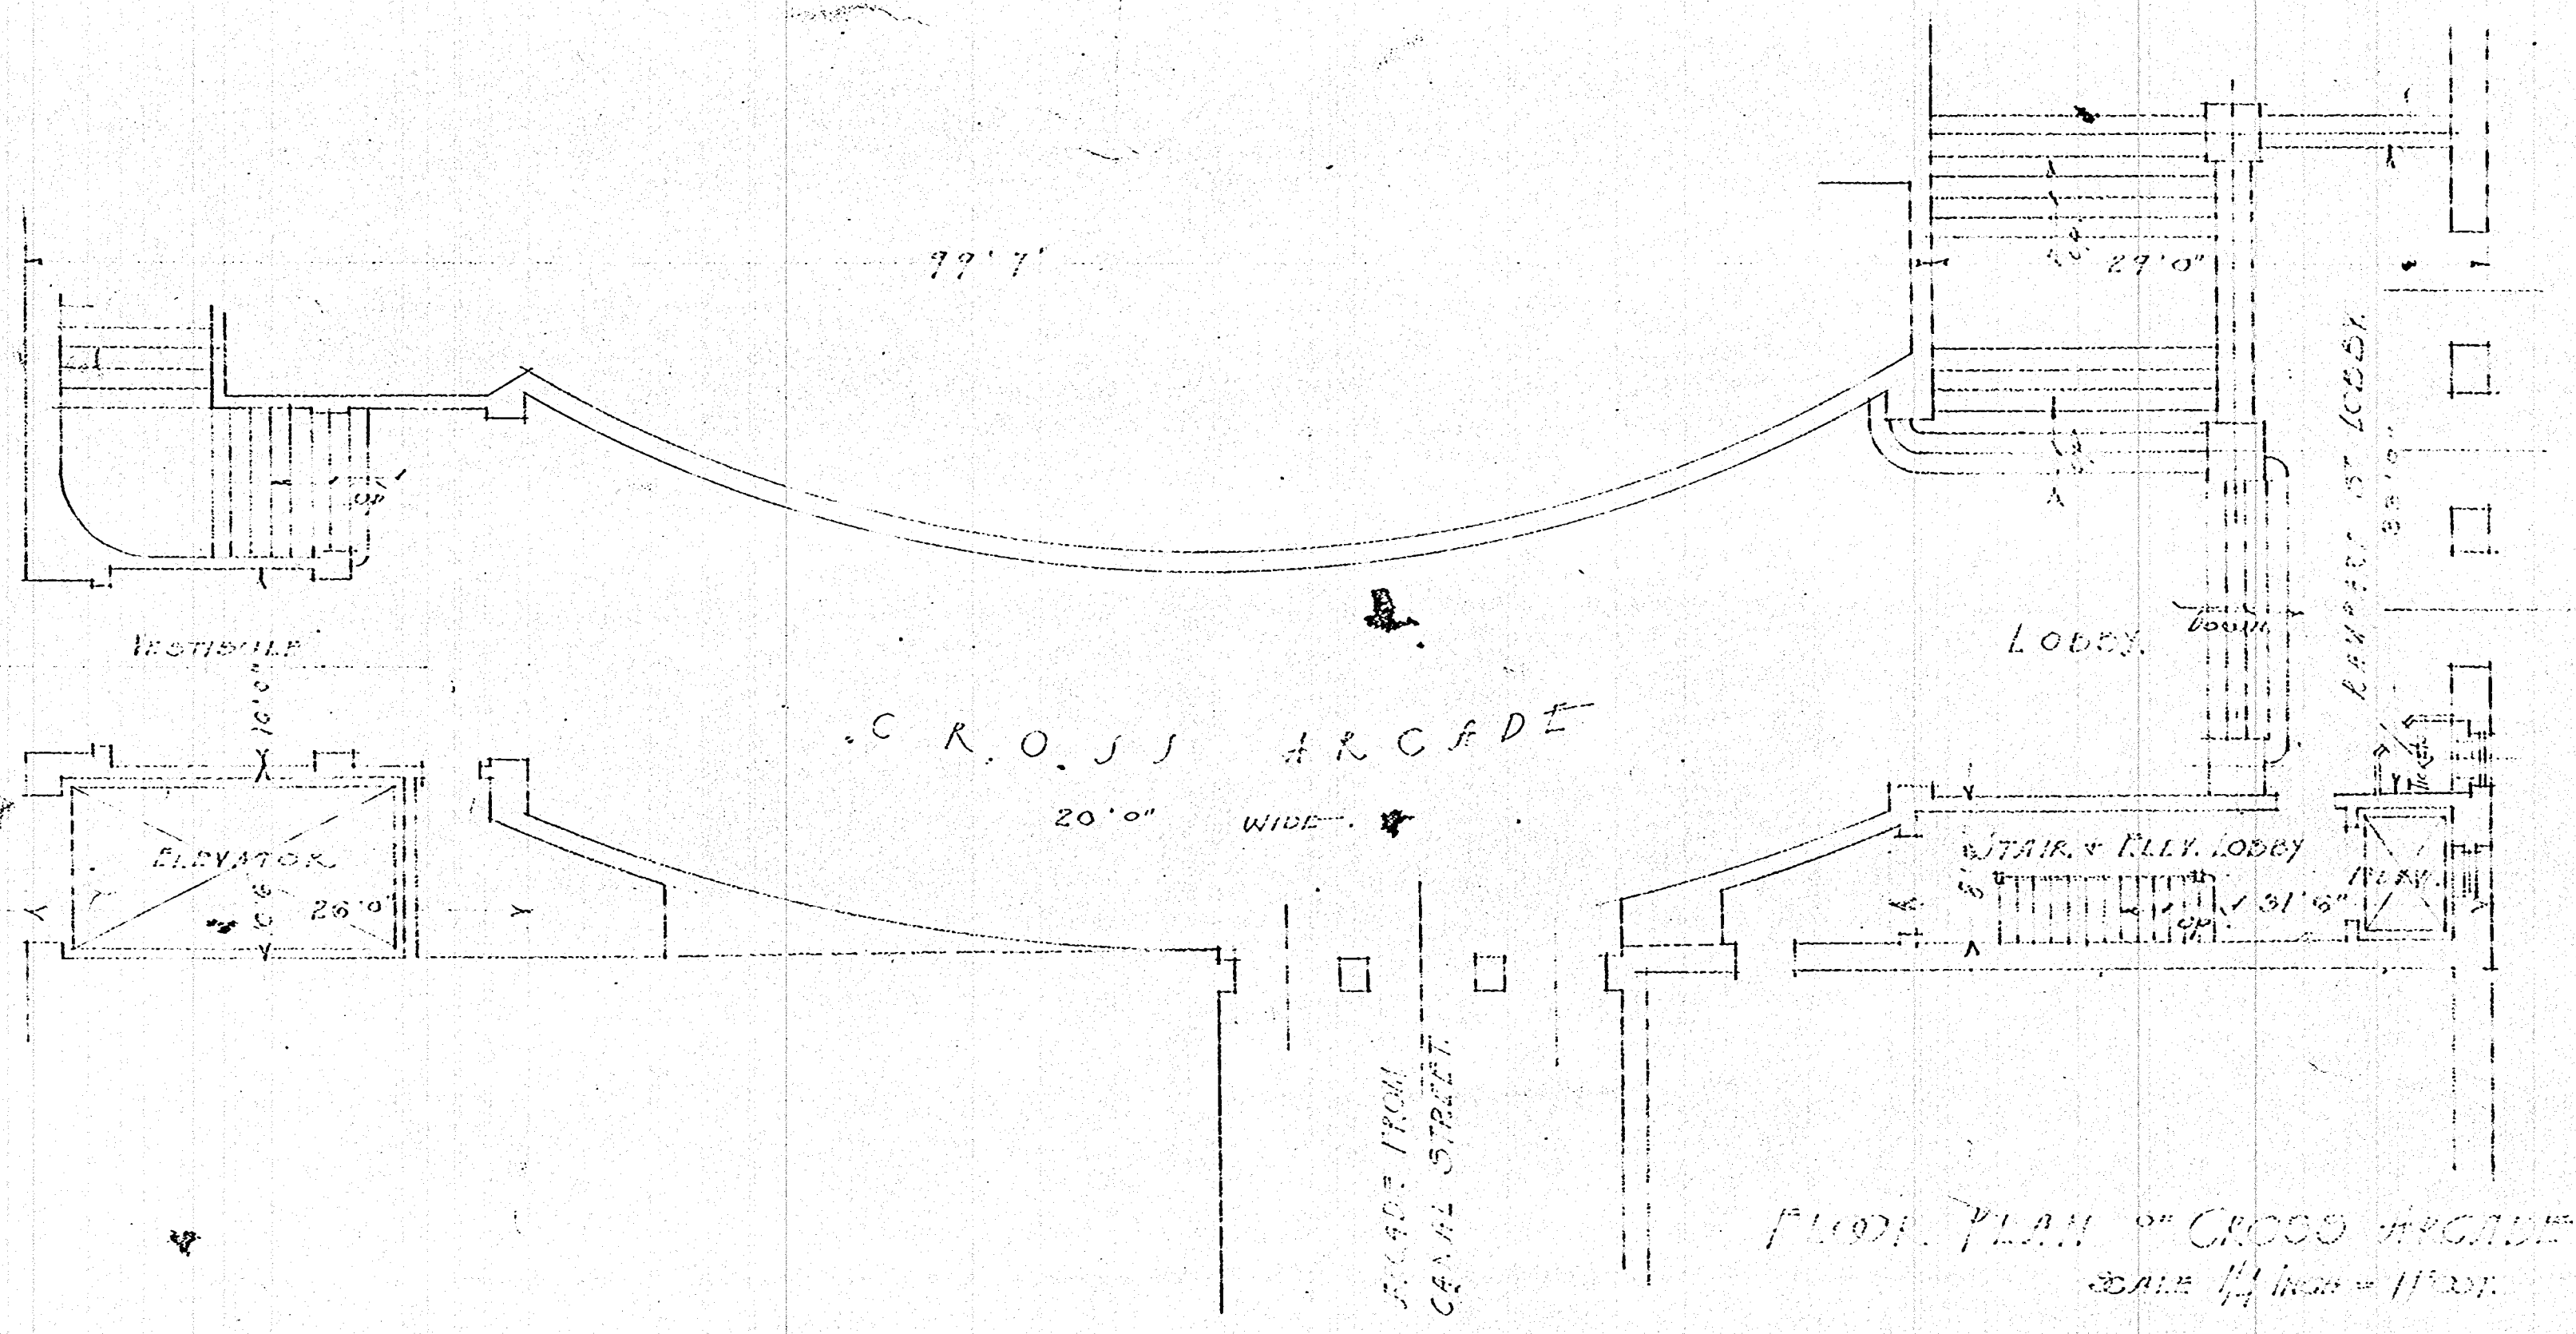

FLOOR PLAN OF CROSS ARCADE
SCALE 1/4" = 1'-0"

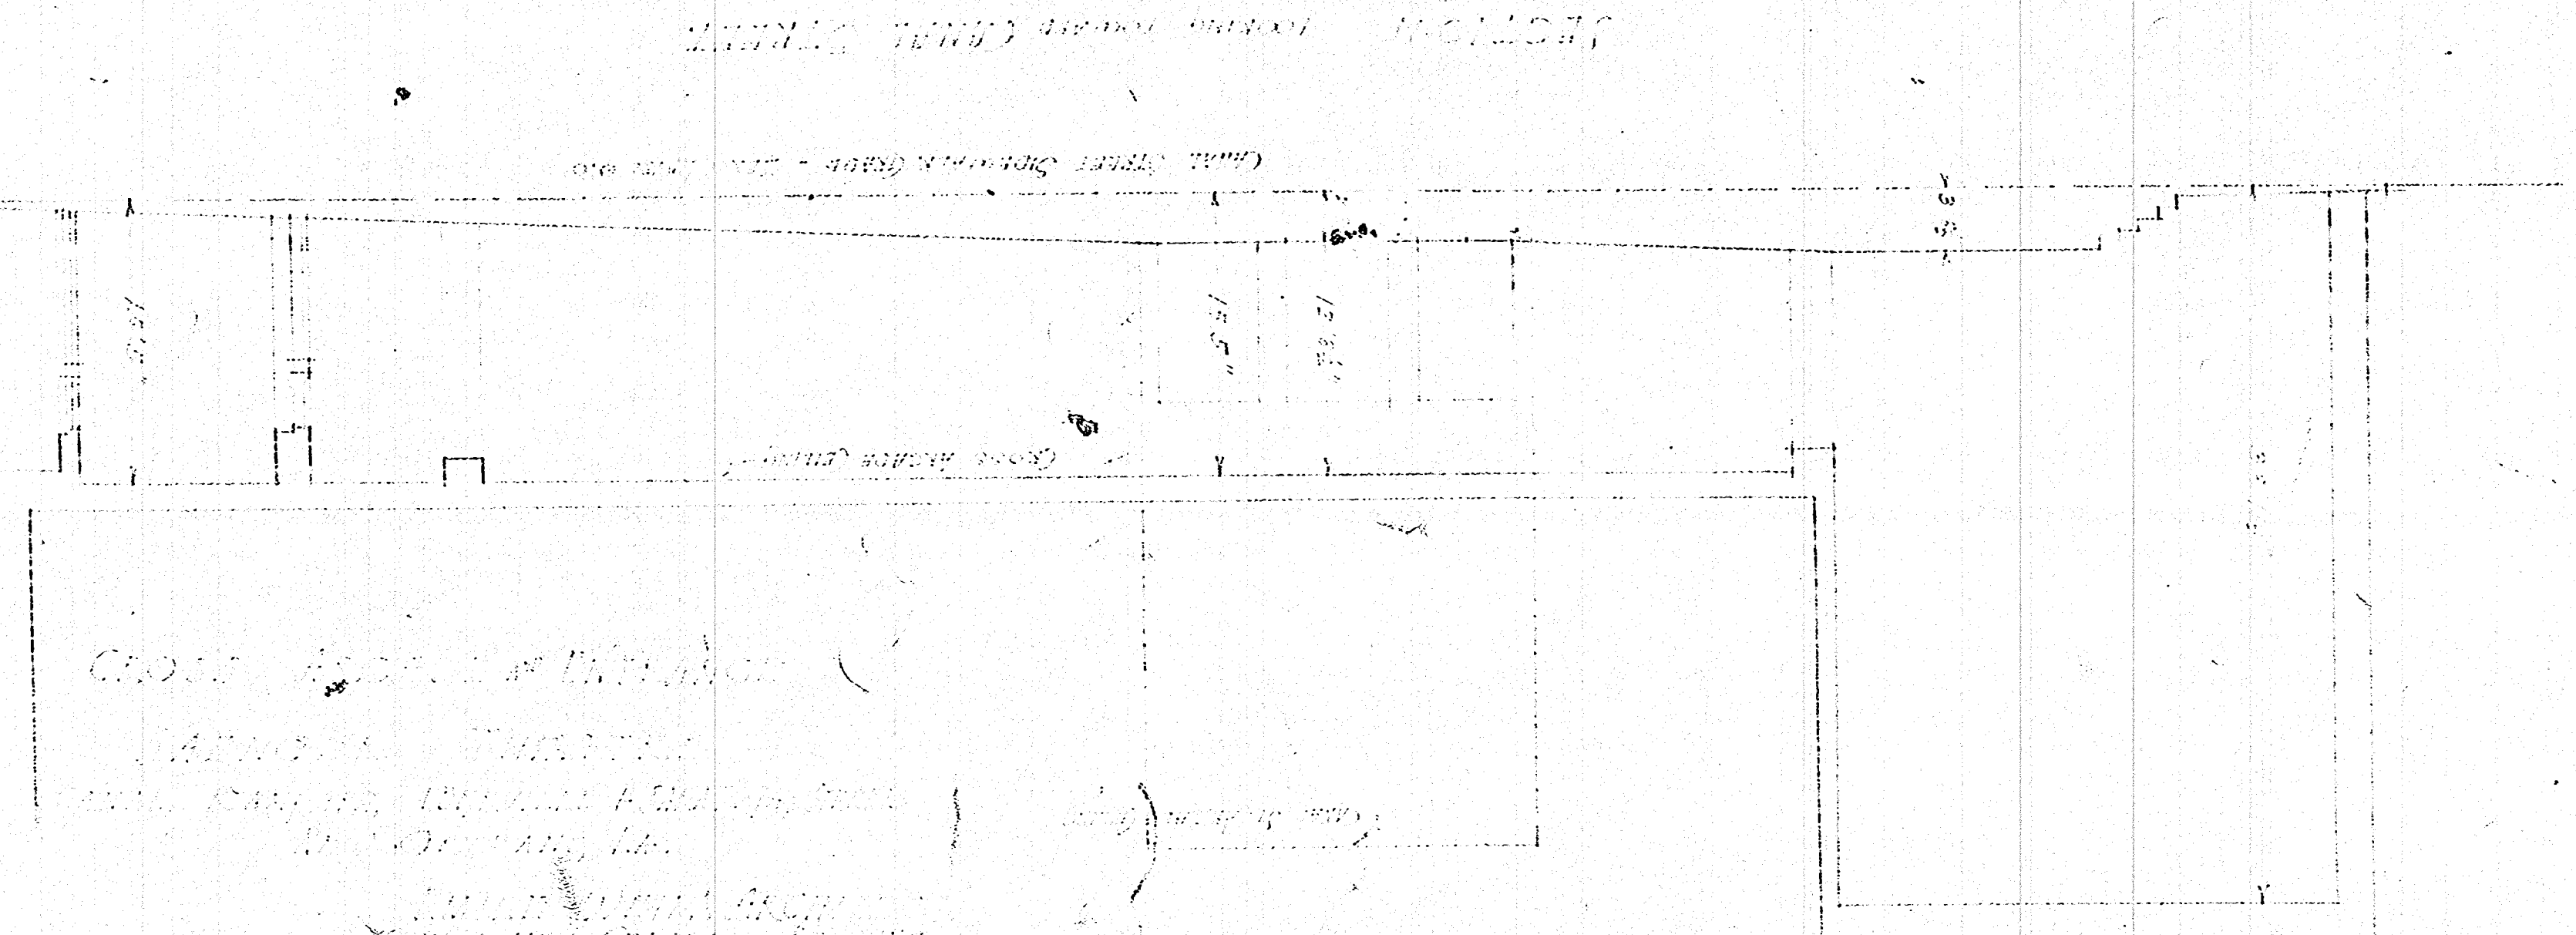

CROSS ARCADE
 ARCHT. BY
 ENGINEER
 1911