


SECTION THRU GRIDIRON FLOOR

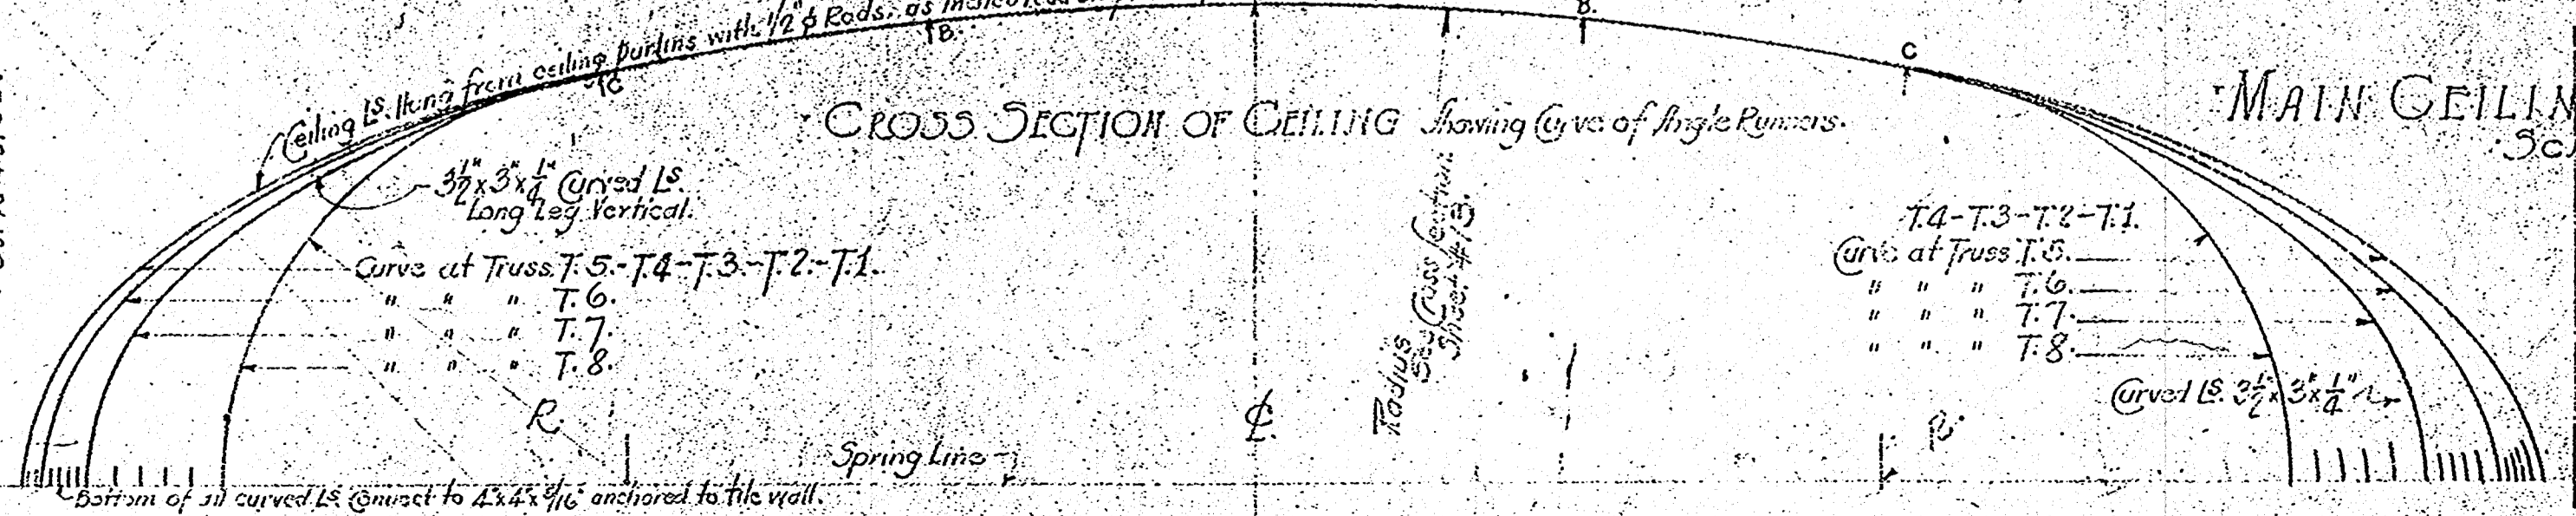

CANAL STREET THEATRE  
 FOR  
**JAENGER THEATRES, INC.**  
 CANAL, N. RAMPART, IBERVILLE & N. SARATOGA STREETS  
 NEW ORLEANS, LA.

REVISED  
**EMILE WEIL ARCHITECTS**  
 WHITNEY CENTRAL BUILDING  
 NEW ORLEANS, LA.

PLAN SHEET  
**80411**  
 DATE NOV 3 1925