


WATER MAIN LINE ON MAPON LINE
 IS LOCATED AS ESTABLISHED 11" BELOW
 ORIGINAL GRADE AT INTERSECTION OF CANAL ST. & CANAL ST.
 SCHEDULE OF PILE CUT-OFF

COLUMN NUMBERS	DEPTH BELOW ORIGINAL GRADE LEVEL
37, 38, 39, 40, 41, 42, 43, 44, 45	-11' 10"
46, 47, 48, 49, 50	-12' 4"
51, 52, 53, 54, 55, 56	-12' 7"
57, 58, 59, 60, 61, 62, 63, 64	-12' 10"
65, 66, 67, 68, 69, 70, 71, 72	-13' 7"
73, 74, 75, 76, 77, 78, 79, 80	-13' 10"
81, 82, 83, 84, 85, 86, 87, 88	-14' 10"
89, 90, 91, 92, 93, 94, 95, 96	-16' 1"
97, 98, 99, 100, 101, 102, 103, 104	-16' 4"
105, 106, 107, 108, 109, 110, 111, 112	-18' 7"
113, 114, 115, 116, 117, 118, 119, 120	-18' 10"
121, 122, 123, 124, 125, 126, 127, 128	-19' 6"
129, 130, 131, 132, 133, 134, 135, 136	-19' 10"
137, 138, 139, 140, 141, 142, 143, 144	-20' 1"
145, 146, 147, 148, 149, 150, 151, 152	-20' 4"
153, 154, 155, 156, 157, 158, 159, 160	-20' 10"

COLUMN NUMBERS OVER	DEPTH BELOW ORIGINAL GRADE
3-6	-13' 10"
7-10	-10' 11"
11-14	-11' 2"
15-18	-11' 5"
19-22	-12' 5"
23-26	-12' 9"
27-30	-12' 2"
31-34	-12' 10"
35-38	-13' 0"
39-42	-13' 5"
43-46	-13' 8"
47-50	-13' 7"
51-54	-13' 8"
55-58	-14' 4"
59-62	-14' 0"
63-66	-17' 2"
67-70	-17' 3"
71-74	-17' 5"
75-78	-18' 5"
79-82	-18' 7"
83-86	-19' 6"
87-90	-19' 8"
91-94	-13' 6"
95-98	-19' 6"
99-102	-19' 9"
103-106	-19' 7"
107-110	-19' 6"
111-114	-19' 8"
115-118	-19' 8"
119-122	-13' 6"
123-126	-19' 6"
127-130	-19' 9"
131-134	-19' 7"

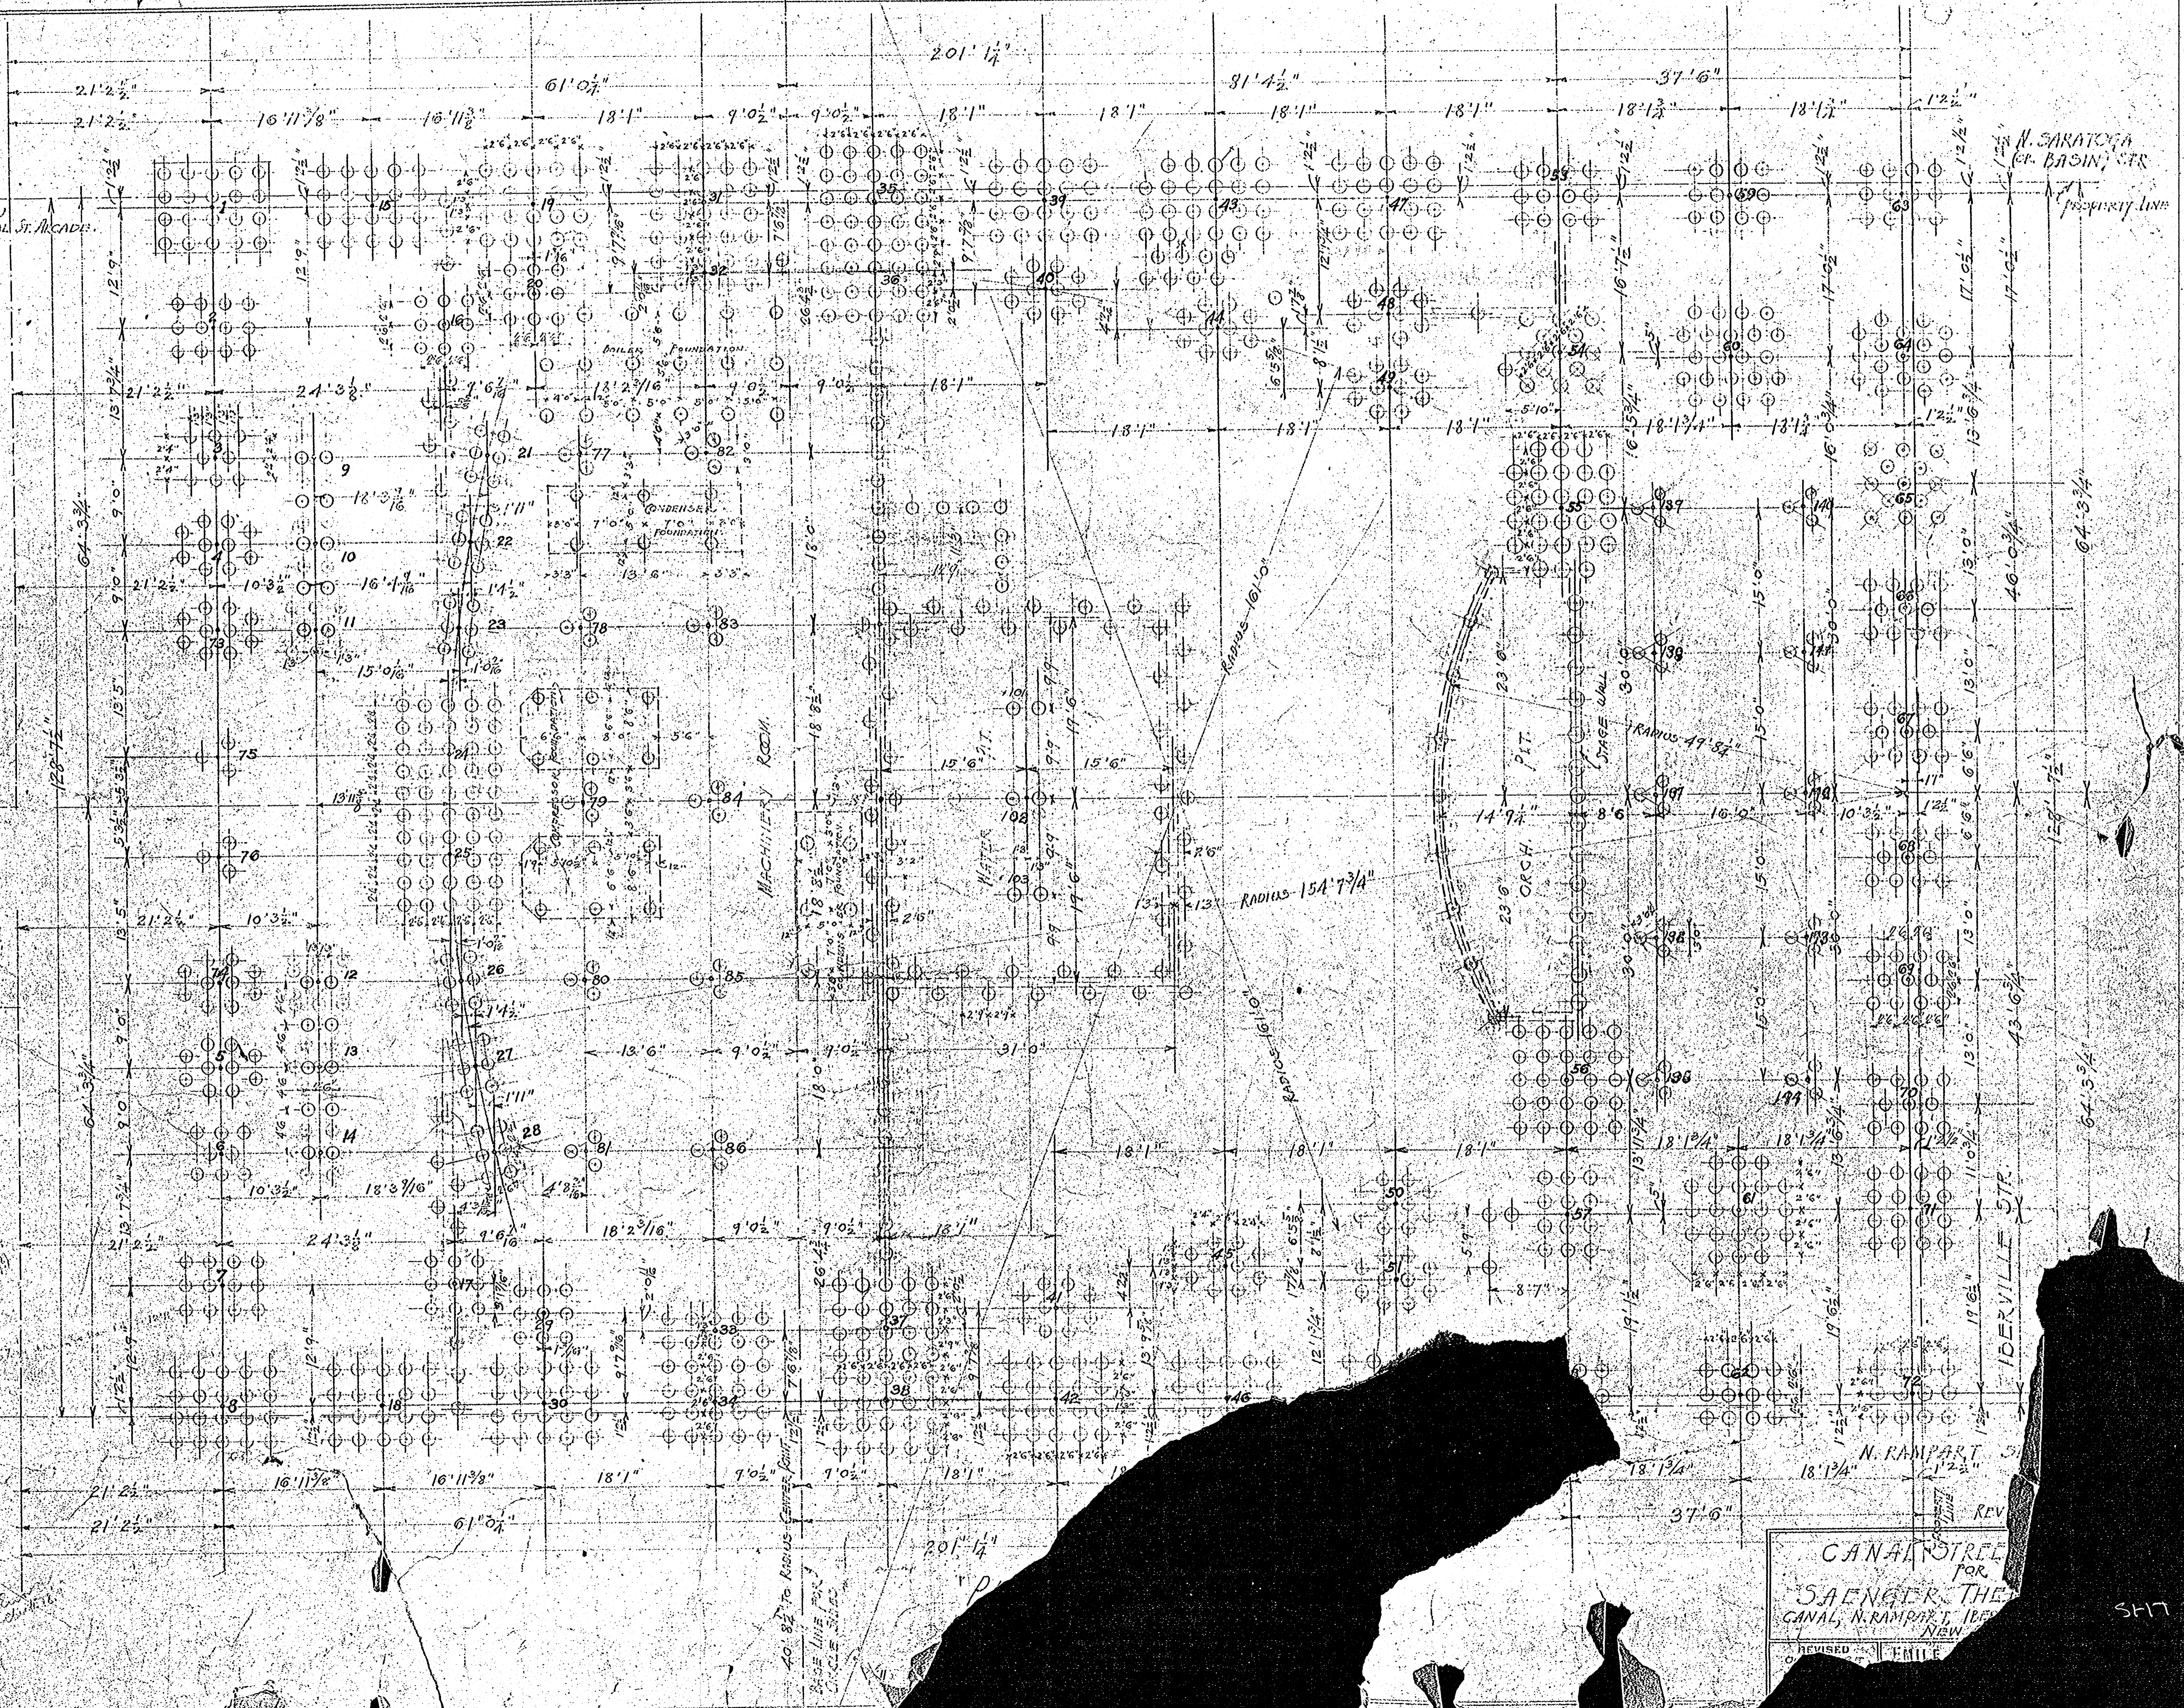

CANAL STREET
 for
 SAENGER, THE
 CANAL, N. RAMPART ST.
 NEW ORLEANS, LA.
 REVISED - 1911