


WATER STAGE LEVEL OR BATHY LINE
 IS 23.45 C.L. ESTABLISHED 11" BELOW
 PROPERTY LINE GRADE AT ENTRANCE OF CANAL ST. BRIDGE

SCHEDULE OF PILE CUTOFF

COLUMN NUMBERS PILE GROUP	DEPTH BELOW DRAIN C.R. STAGE LEVEL 0.00
37, 72, 71, 72, 73, 74, 75 96, 77, 78, 79, 78	-11' 10"
3, 6, 7, 10, 11, 12, 13, 14	-12' 4"
1, 7, 4, 5, 73, 74, 53, 54 63, 58, 62, 72, 54, 57 96, 67, 68, 69, 70 STAGE WALL 4' OR LESS W.P.	-12' 7"
80, 61, 64, 11, 65, 1, 2, 15, 18,	-12' 10"
48, 49, 50, 51	-13' 7"
47, 52,	-13' 10"
55, 56	-14' 10"
44, 45	-16' 1"
43, 46	-16' 4"
40, 41	-18' 7"
39, 42	-18' 10"
37, 88 WALL AROUND WATER PIT BOSS WALLS OF MACHINERY RM	-19' 6"
21, 22, 23, 26, 27, 28, 77, 78, 74, 80, 81, 82, 83, 84, 35, 36	-19' 10"
16, 17,	-20' 1"
17, 20, 21, 22, 23, 34	-20' 1"
24, 25, 35, 36, 37, 38	-20' 10"

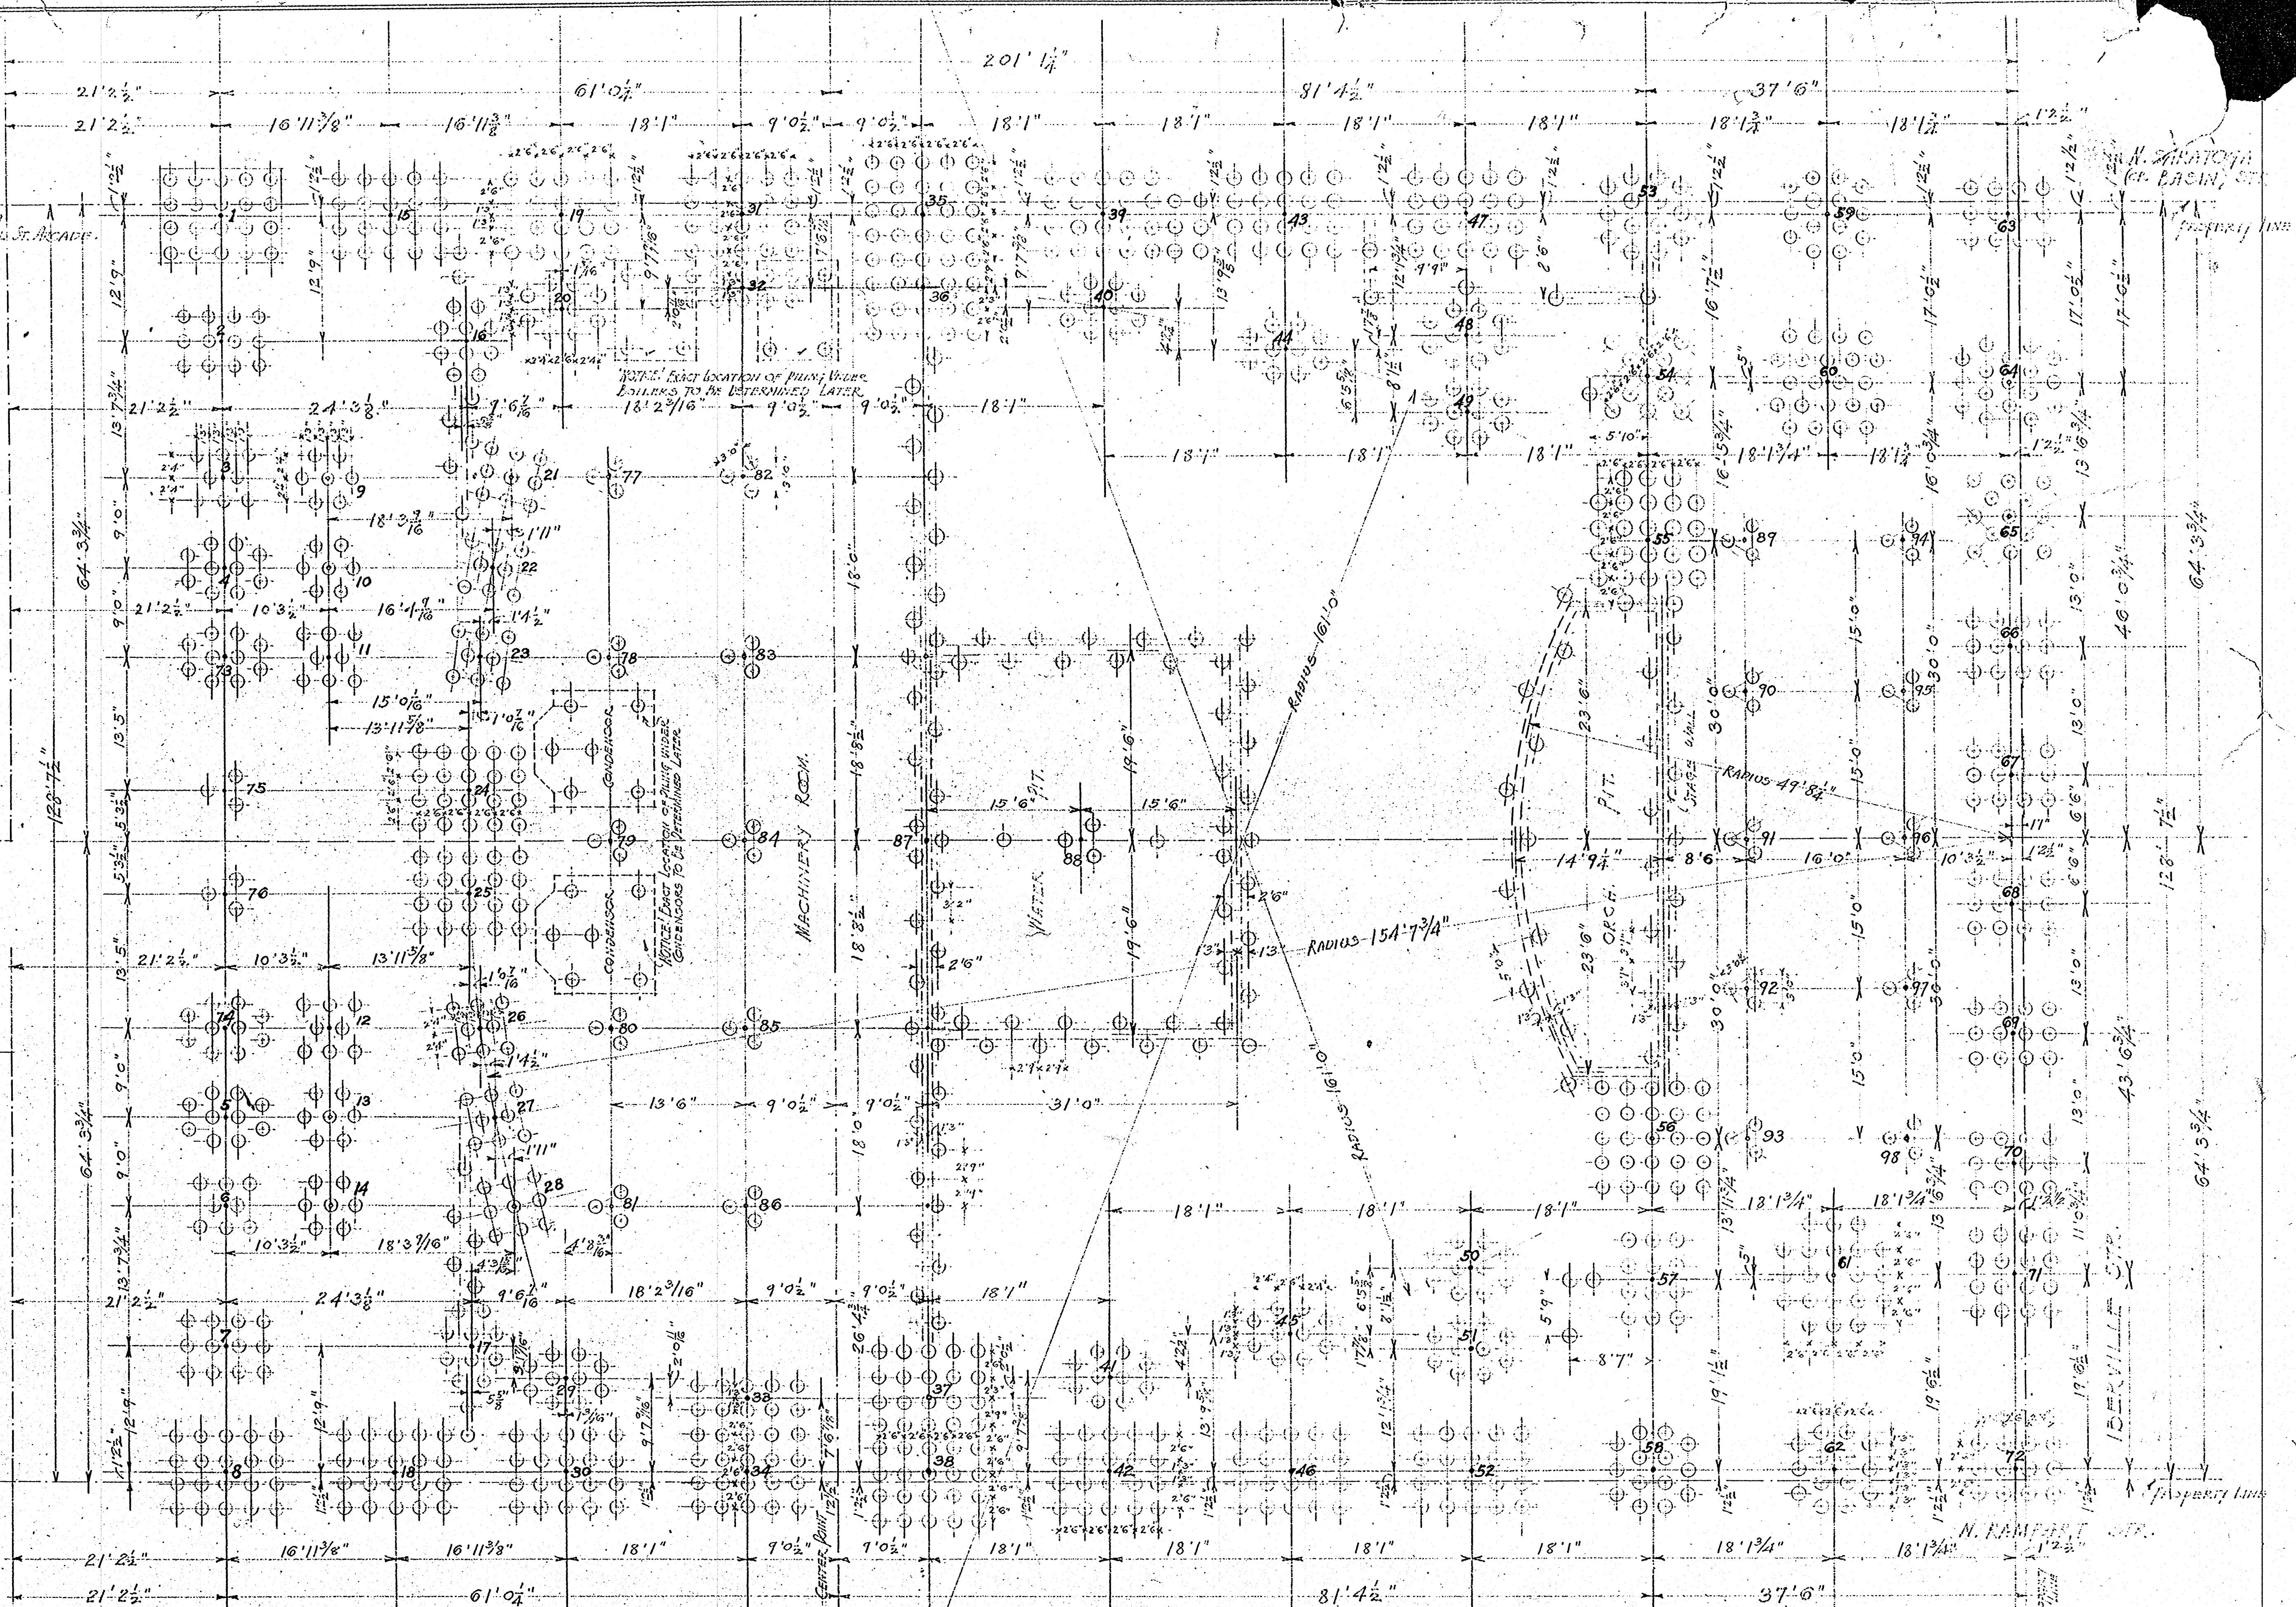

"PILING PLAN"
 SCALE 1/8 INCH = 1 FOOT

CANAL STREET THEATRE
 FOR
 SAENGER THEATRES, INC.
 CANAL, N. RAMPART, HERSCHEL, KASSAB, & PETER
 NEW ORLEANS, LA.

EMILE WEIL ARCHITECT
 WHITNEY CENTRAL BUILDING
 NEW ORLEANS, LA.

REVISION
 PLAN SHEET
 37 2
 DATE