


# Performance Curve - HPG200

RPM: 3450 DISCHARGE: 1-1/4"

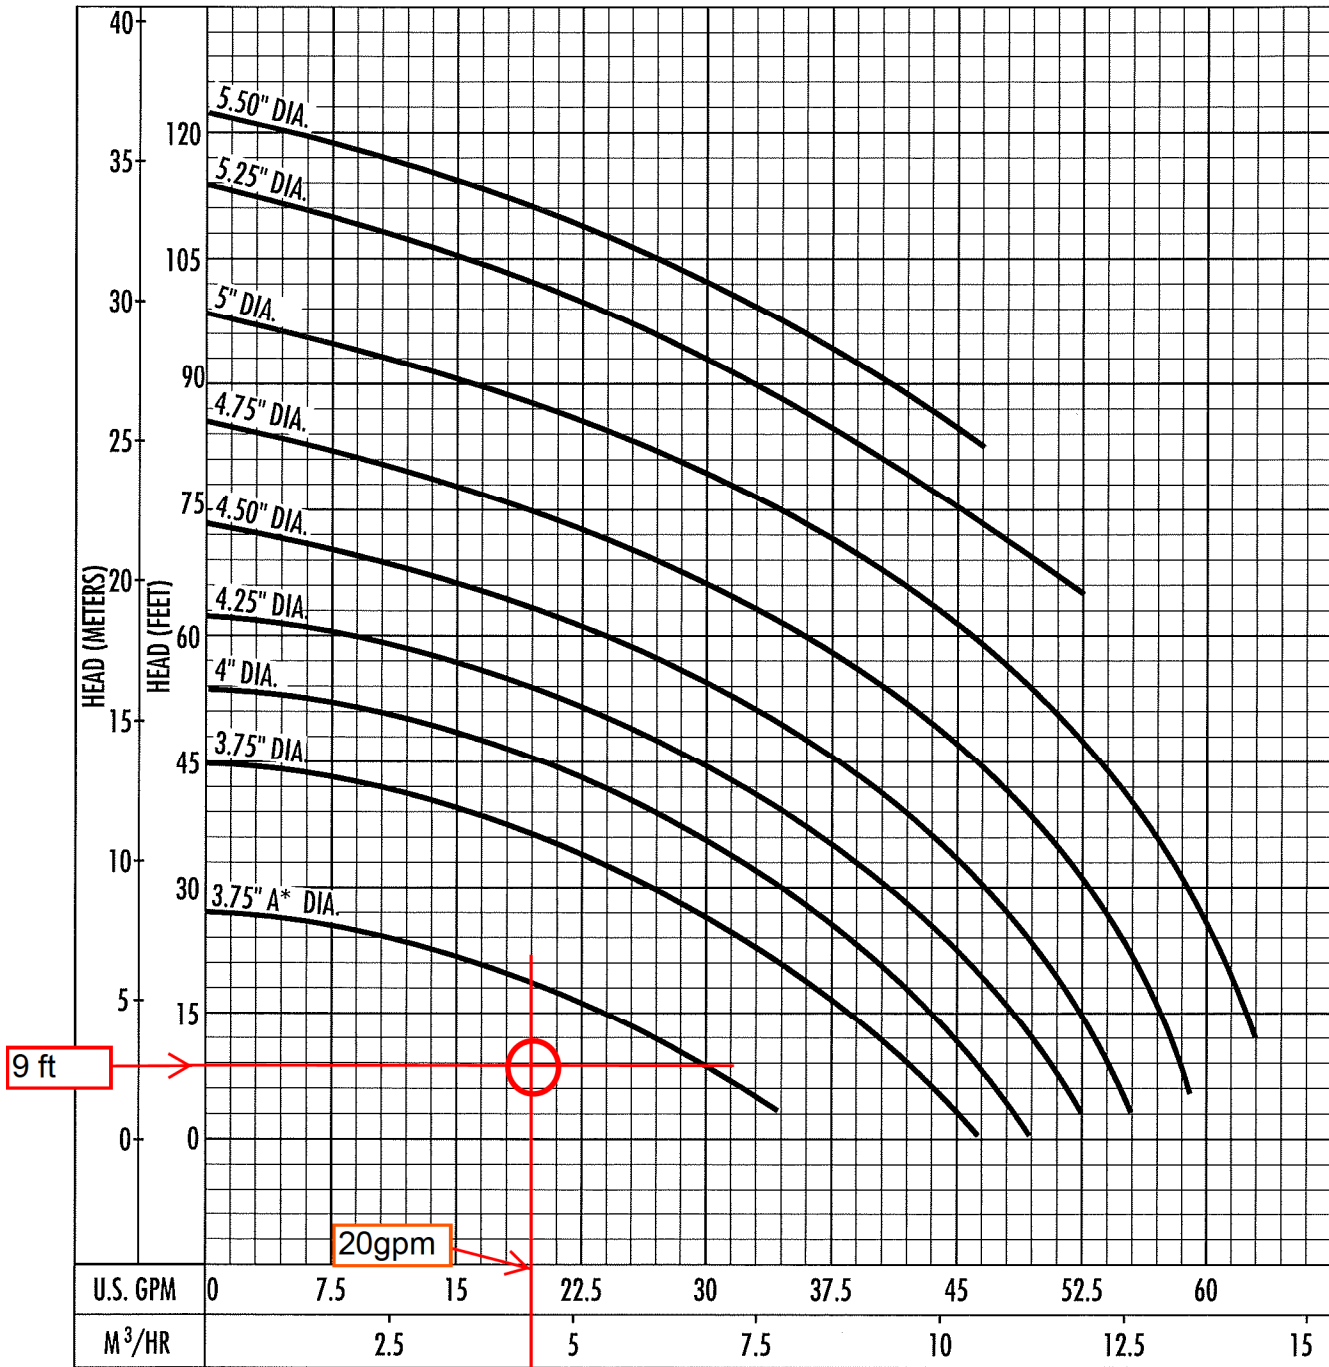

The curves reflect maximum performance characteristics without exceeding full load (Nameplate) horsepower. All pumps have a service factor of 1.2. Operation is recommended in the bounded area with operational point within the curve limit. Performance curves are based on actual tests with clear water at 70° F. and 1280 feet site elevation.

Conditions of Service:



HYDROMATIC®

GPM: \_\_\_\_\_ TDH: \_\_\_\_\_

March © 2017 Pentair plc