



18 ROOF FRAMING
SCALE: 1/4" = 1'-0"


LIVING QUARTERS

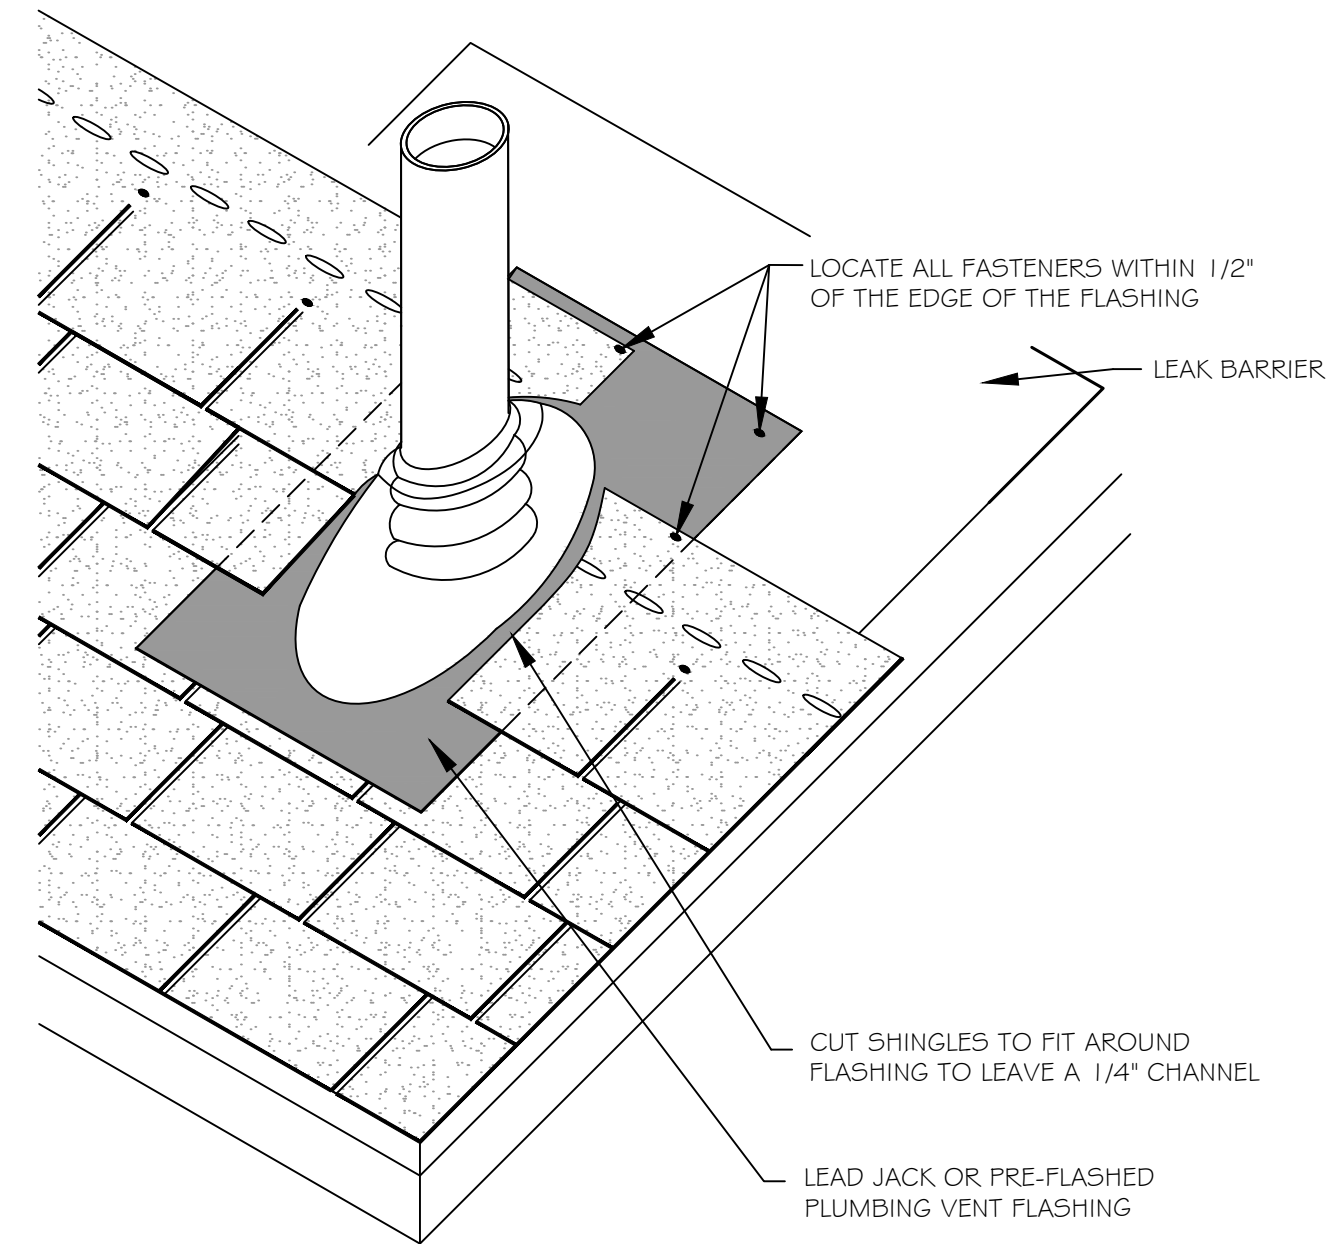


ROOF DETAIL - ROOF VENT DETAIL
SCALE: N.T.S.

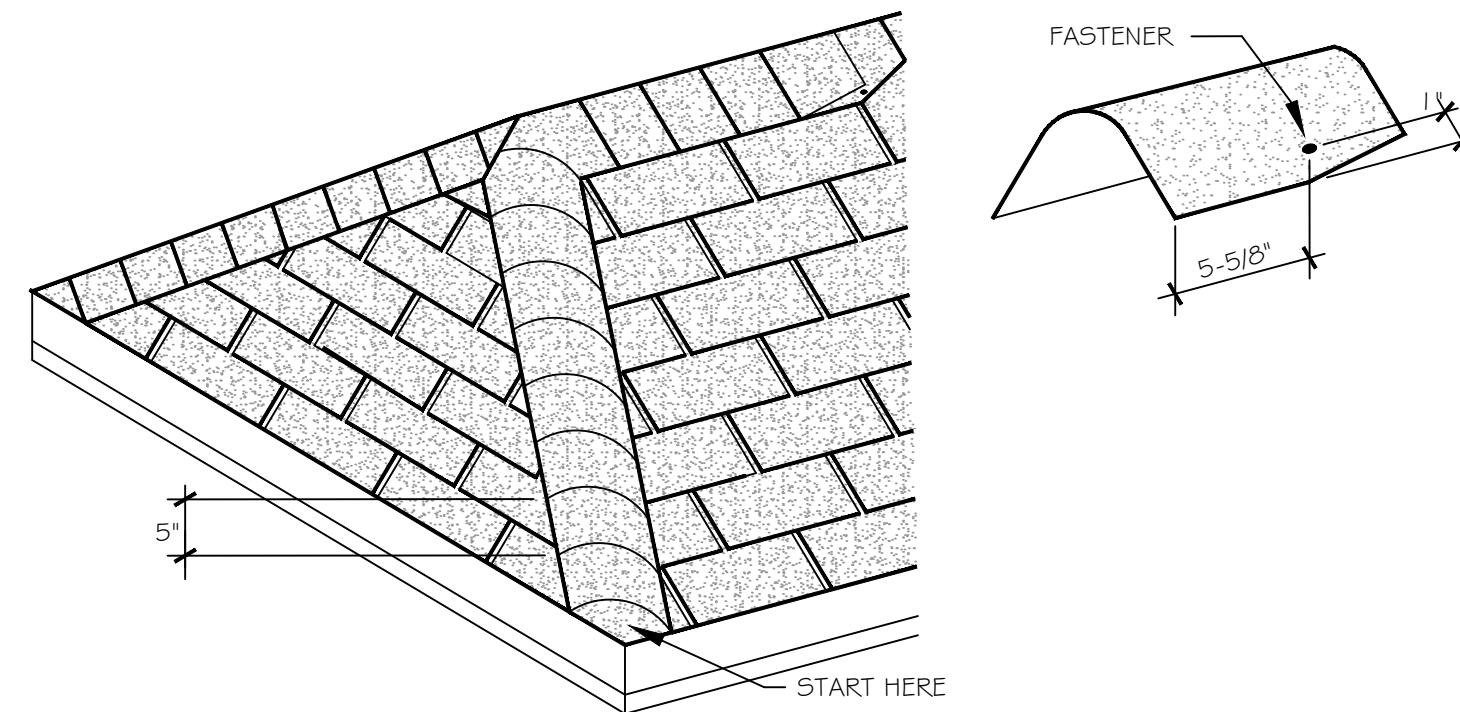


ROOF DETAIL - HIP/RIDGE DETAIL
SCALE: N.T.S.

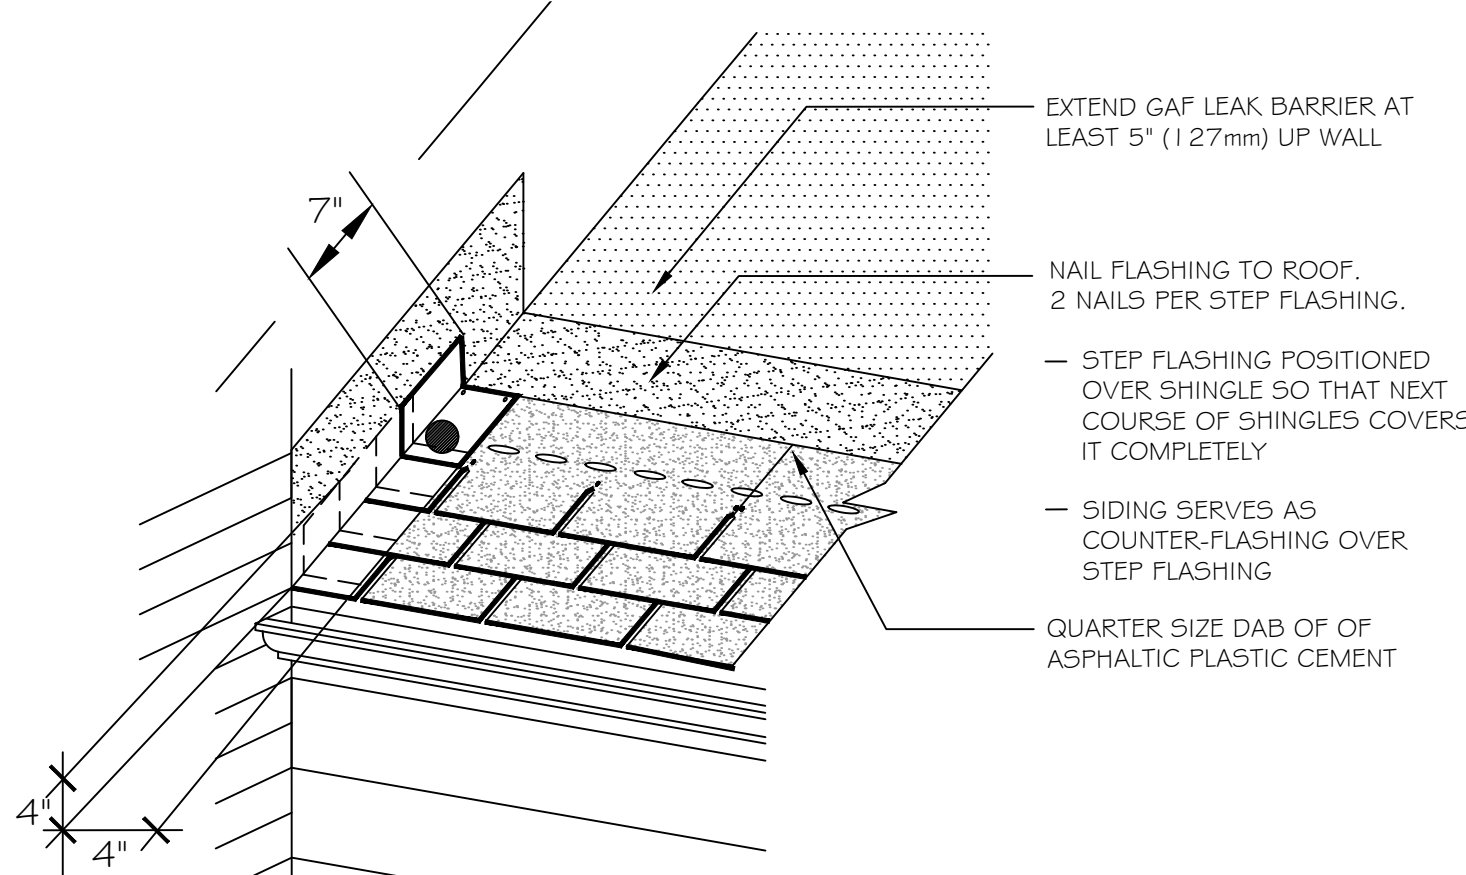

ROOF DETAIL - STEP FLASHING DETAIL
SCALE: N.T.S.

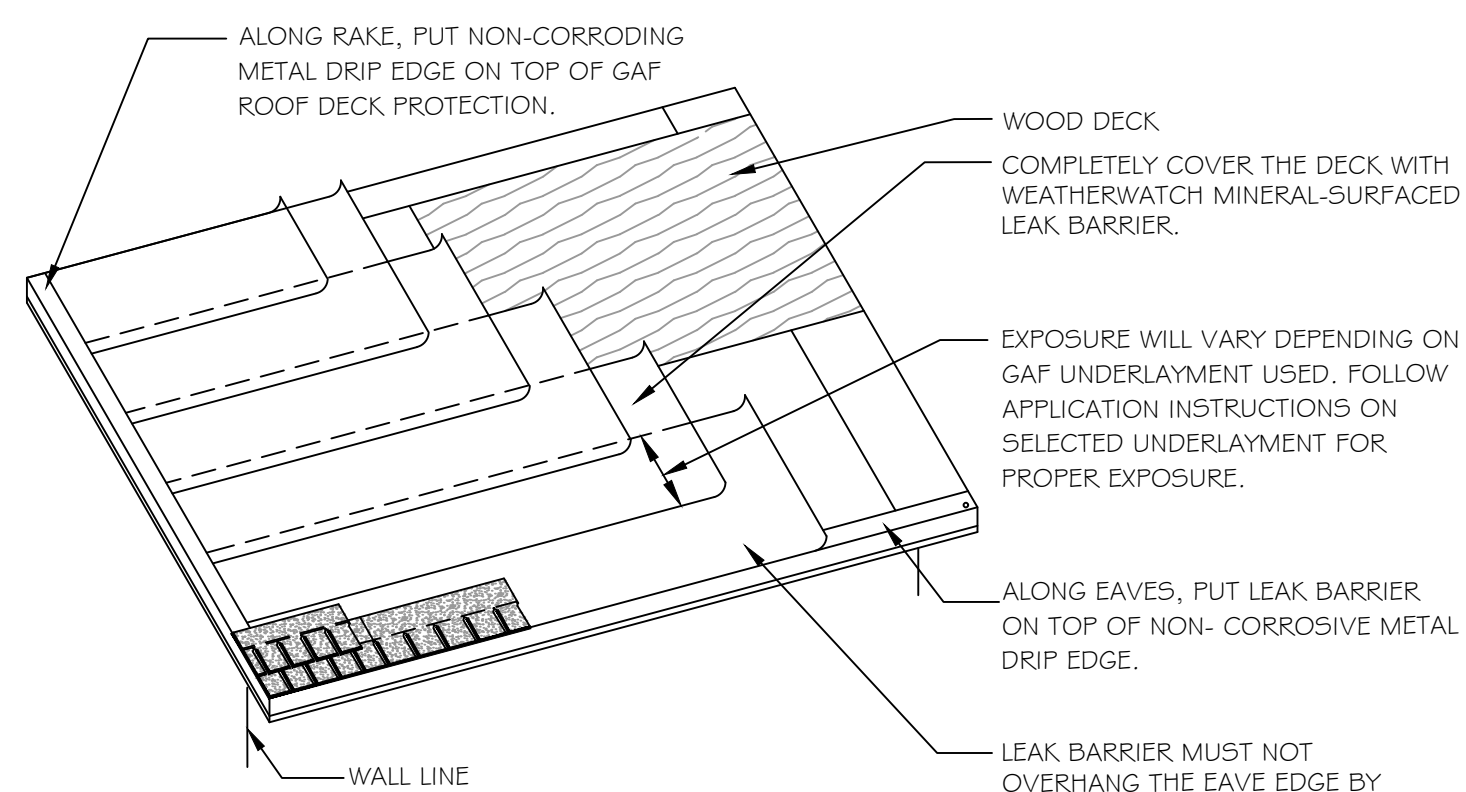

ROOF DETAIL - UNDERLAYMENT DETAIL
SCALE: N.T.S.

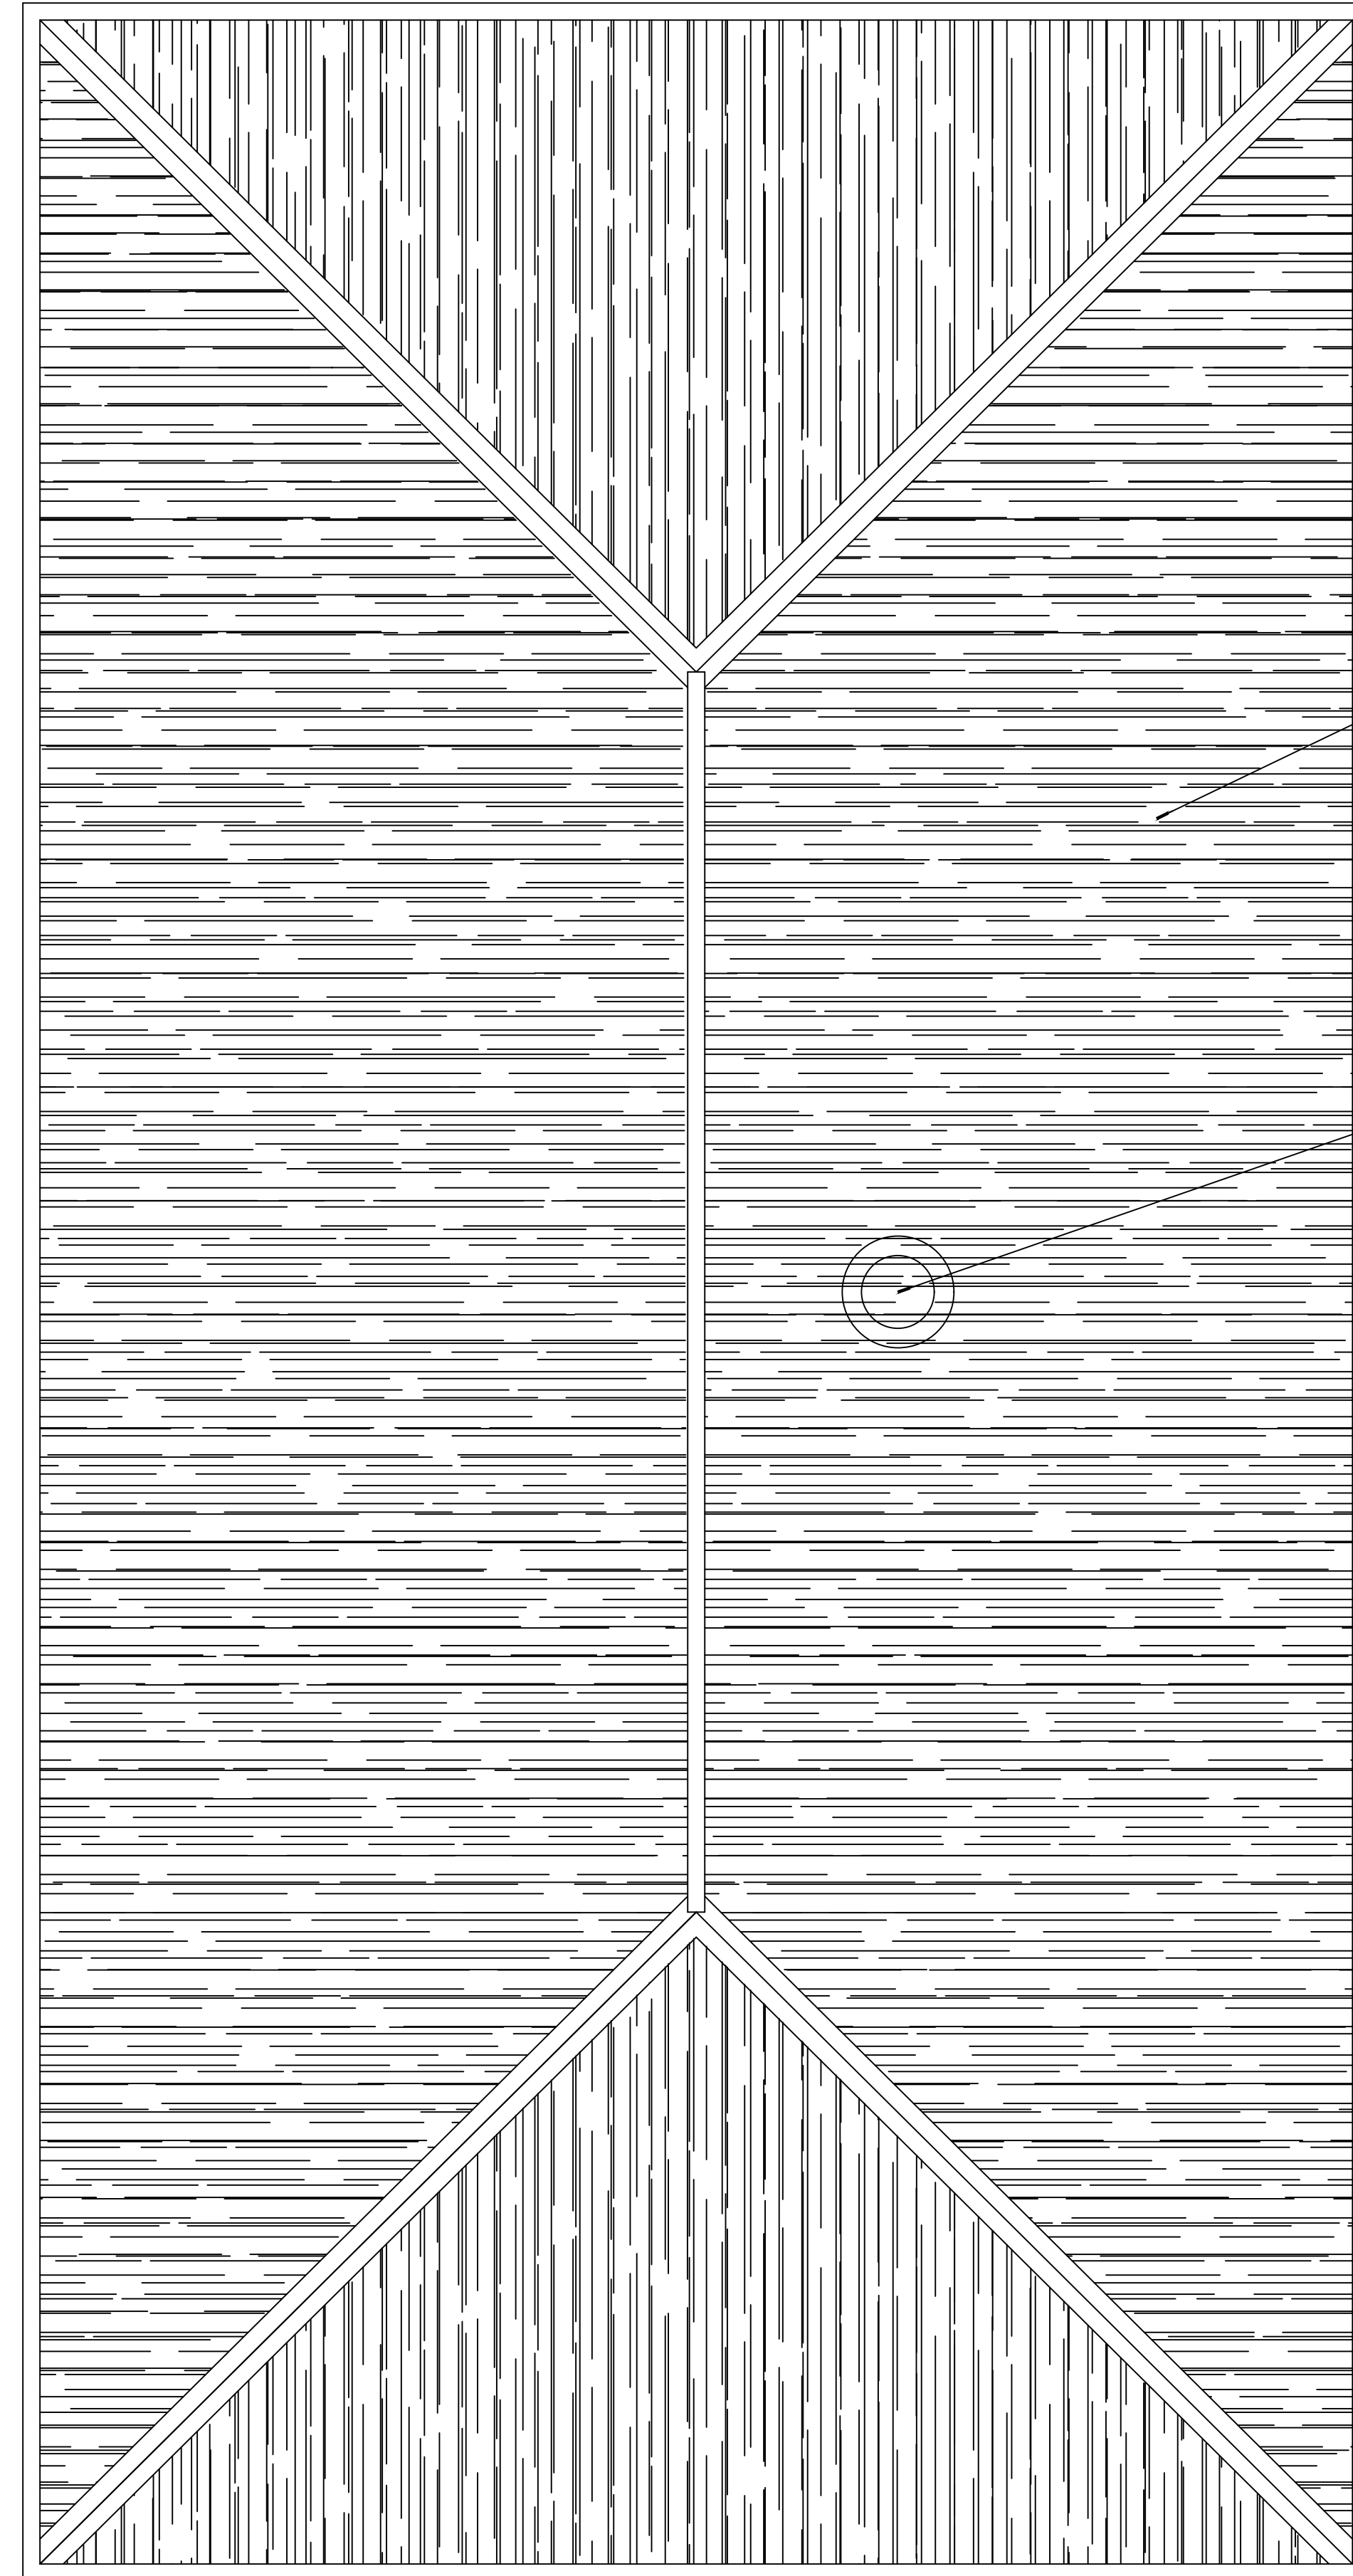

19 ROOF PLAN
SCALE: 1/4" = 1'-0"


LIVING QUARTERS

DAMMON ENGINEERING, INC.
LOUISIANA & MISSISSIPPI

www.dammonengineering.com
info@dammon.com
PH: 985.449.9832

Chief Engineer: Brian Mistich, PE
564 Old Spanish Trail
Slidell, LA 70458

NO.	DESCRIPTION	DATE
1	Added Roof Details	8/1/2022

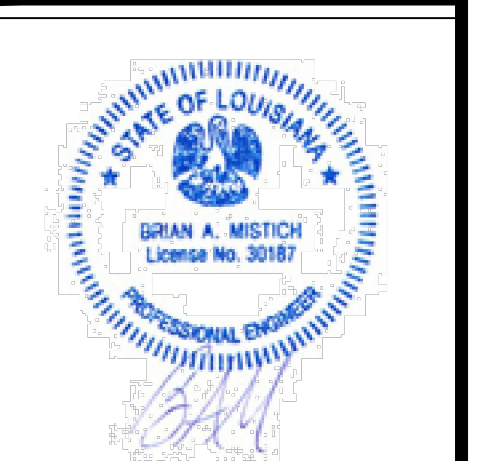

ST. TAMMANY FIRE PROTECTION DISTRICT No. 1
FIRE STATION 19

87047 ALLEN ROAD
SLIDELL, LOUISIANA 70461

JOB No: 2456 DATE: 08-16-2022
DRAWN BY: CACD CHECKED BY: BAK

SHEET TITLE:
LIVING QUARTERS ROOF FRAMING PLAN

DRAWING NUMBER:
S104

AS-BUILT
1-31-24

SHEET No: 9 of 30