


**NAVFAC STANDARD SYMBOLOGY
KEYNOTE SYMBOLS**



VIEWTITLE
ViewportScale
(PLAN TITLE)




VIEWTITLE
ViewportScale
(DETAIL, SECTION AND ELEVATION TITLE)

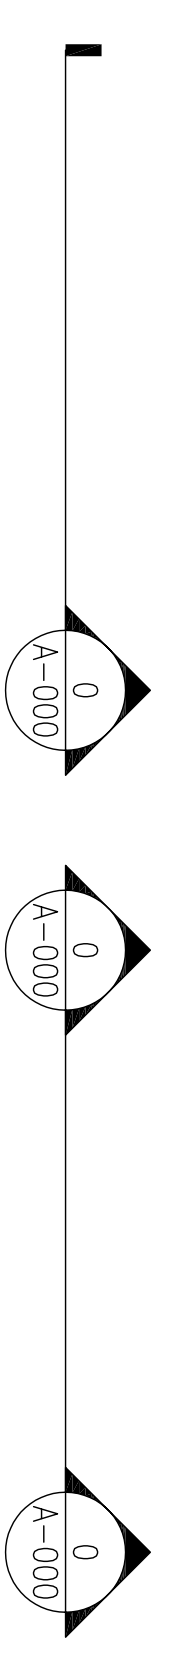


(PLAN SECTION)


(BUILDING SECTION LINE)

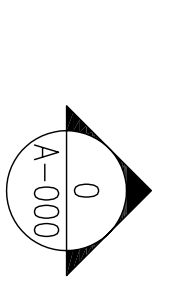


(EXTERIOR ELEVATION)

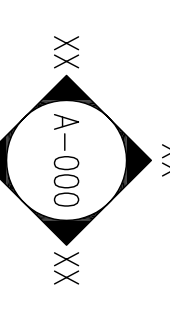


(INTERIOR ELEVATION)

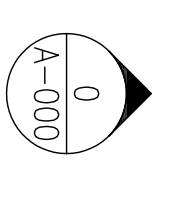


(INTERIOR ELEVATION)

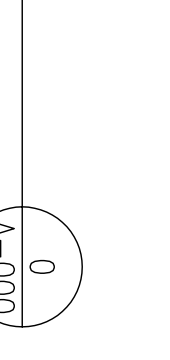


(DETAIL MARK)

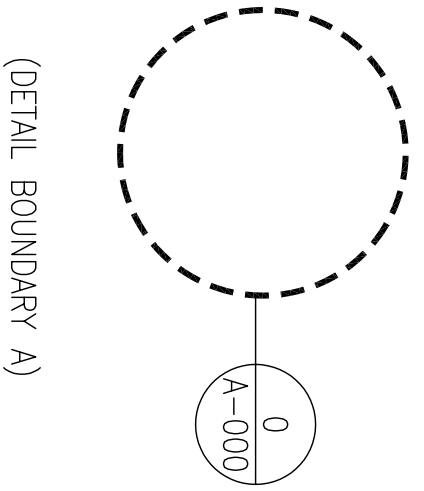

(DETAIL BOUNDARY A)

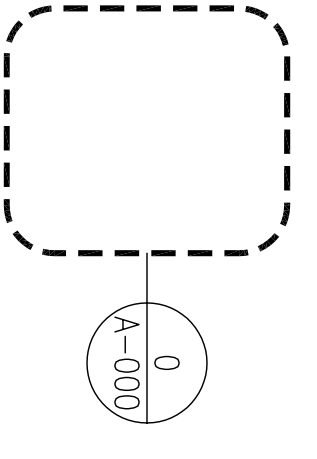

(DETAIL BOUNDARY B)

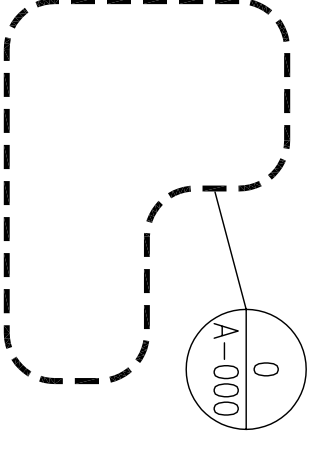

(DETAIL BOUNDARY C)

| NAVFAC STANDARD SYMBOLOGY KEYNOTE SYMBOLS | |
|--|-------------------------------------|
| | NEW WORK KEYNOTE (SHEET) - SQUARE |
| | NEW WORK KEYNOTE - SQUARE |
| | DEMO WORK KEYNOTE (SHEET) - HEXAGON |
| | DEMO WORK KEYNOTE - HEXAGON |
| | SPECIALTY ITEM KEYNOTE |
| | SPECIALTY KEYNOTE (SHEET) |

GENERAL NOTES

EXTERIOR ENVELOPE NOTES

1. ALL EXTERIOR JOINTS IN THE BUILDING ENVELOPE SHALL BE SEALED, GASKETED, WEATHER-STRIPPED, OR OTHERWISE SEALED IN ACCORDANCE WITH SPECIFICATIONS.
2. PROVIDE OPEN HEAD WEEP JOINT WITH VENT AT 24" O.C. MINIMUM AT STEEL UNITS. THROUGH WALL FLASHING, BASE OF WALLS, AND AT ANY HORIZONTAL BARRIER IN THE WALL CAVITY.
3. ALL EXTERIOR MASONRY WALLS SHALL BE REINFORCED AS REQUIRED BY DRAWINGS AND SPECIFICATIONS.
4. PROVIDE MASONRY CONTROL JOINTS THROUGH ALL CONTINUOUS MASONRY WALLS AT INTERVALS RECOMMENDED BY THE NATIONAL CONCRETE MASONRY ASSOCIATION AND THE NATIONAL BRICK INSTITUTE. SEE SPECIFICATIONS.
5. SEE STRUCTURAL DRAWINGS FOR ADDITIONAL TYPICAL MASONRY NOTES.

INTERIOR PARTITION NOTES

1. ALL METAL STUD GAGE DESIGN SHALL BE AS REQUIRED BY PERFORMANCE AND AS INDICATED IN THE SPECIFICATIONS.
2. ALL METAL STUDS TO BE SPACED 16" O.C., TYPICAL, UNLESS OTHERWISE NOTED.
3. PROVIDE CONTINUOUS SHEET METAL BLOCKING IN ALL STUD WALLS THAT ARE TO RECEIVE GRAB BARS, HANDRAILS, TOILET PARTITIONS, CABINETS, SIGNAGE, ETC. COORDINATE MISCELLANEOUS BLOCKING IN WALL WITH APPROPRIATE EQUIPMENT SUPPLIERS. VERIFY EQUIPMENT ANCHORING REQUIREMENTS.
4. PROVIDE J-MOLDS AND CORNER BEADS AT THE EDGES OF ALL GYPSUM BOARD.
5. REFER TO WALL TYPES IN DRAWINGS FOR SOUND RATED AND FIRE RATED WALLS.
6. ALL RATED PARTITIONS SHALL EXTEND TO THE UNDERSIDE OF THE ROOF DECK OR RATED FLOOR SLAB ABOVE. THE PERIMETER OF THE WALL AND ALL PENETRATIONS SHALL BE FIRE SEALED AS SPECIFIED.

DOOR NOTES

1. HINGE SIDE OF DOOR FRAME TO BE OFFSET 4" MINIMUM FROM FACE OF STUD OF ADJACENT WALLS UNLESS NOTED DIFFERENTLY ON DRAWINGS. FIELD VERIFY COMPLIANCE WITH ADAAG CLEARANCES WHERE REQUIRED.
2. AT MASONRY CONSTRUCTION, DOOR FRAME TO BE LOCATED AS INDICATED ON DRAWINGS.

GENERAL

1. IT IS THE RESPONSIBILITY OF THE DESIGN-BUILDER TO PRODUCE ALL WORK IN COMPLIANCE WITH THE INTERNATIONAL BUILDING CODE (IBC), GENERAL CONDITIONS OF THE CONTRACT FOR CONSTRUCTION, RECOGNIZED INDUSTRY STANDARDS, LOCAL CRAFTSMANSHIP STANDARDS, ALL MANUFACTURERS RECOMMENDATIONS, AND ALL OTHER APPLICABLE CODES.
2. PROVIDE ACCESSIBILITY FOR THE PHYSICALLY HANDICAPPED CONFORMING TO THE UNIFORM FEDERAL ACCESSIBILITY STANDARD (UFAS).
3. THE DESIGN-BUILDER SHALL COORDINATE ALL ASPECTS OF THE DESIGN AND CONSTRUCTION AS IT RELATES TO ADJACENT PROJECT DEVELOPMENT.

ACCESSIBILITY AND EGRESS NOTES

1. CONTRACTOR TO VERIFY ALL DOORS, OPENINGS, SLOPES, TOILET ROOMS, ACCESSIBLE ROUTES, ETC. COMPLY WITH THE LATEST REVISIONS OF UFAS.
2. DOORS IN EXITS SHALL NOT BE SUBJECT TO THE USE OF A KEY, TWISTING MOTION, OR SPECIAL KNOWLEDGE FOR OPERATION FROM THE INSIDE OF THE BUILDING.
3. EVERY INTERIOR AND EXTERIOR DOOR IN THE BUILDING SHALL BE PROVIDED WITH HANDICAP HARDWARE (LEVERS, PANIC HARDWARE, OR U-SHAPED DESIGNED DEVICES, ETC.) PER ADAAG SECTION 4.13.9, UNLESS PROHIBITED BY NAVY CRITERIA FOR SECURITY REASONS.
4. PARKING SPACES SHALL NOT OBSTRUCT REQUIRED EXITS.
5. AISLES LEADING TO REQUIRED EXITS SHALL HAVE A MINIMUM CLEAR WIDTH OF 44".

FINISH LEGEND:

| | | |
|--|--------|---|
| | ACT | ACOUSTICAL CEILING TILE |
| | CONC | SEALED CONCRETE |
| | CPTT-1 | CARPET TILE TYPE 1 |
| | CPTT-2 | CARPET TILE TYPE 2 |
| | EP | EPOXY PAINT |
| | GWB | GYPSUM WALL BOARD |
| | IRWT | IMPACT RESISTANT WALL TREATMENT |
| | MPI | MASTER PAINTERS INSTITUTE (MPI) SYSTEM EXT 5: 1D-G5 |
| | MS | METAL SOFFIT |
| | P | PAINT |
| | PS | PAINTED STRUCTURE |
| | PT | PORCELAIN TILE |
| | QVT | QUARTZ VINYL TILE |
| | RB | RUBBER BASE |
| | RT | RUBBER STAIR TREADS |
| | FP | FIREPROOFING |

WALL LEGEND:

| | |
|--|---------------------------|
| | 8" CMU |
| | BLOCK LEDGE |
| | WALL EXTENDS TO ROOF DECK |

ACRONYMS & ABBREVIATIONS:

| | |
|------------|--|
| ANCH. | ANCHOR |
| C/C | CEILING |
| COMB. | COMBINATION |
| CONT. | CONTINUOUS |
| CSS | COMBAT SERVICE SUPPORT |
| DBL. | DOUBLE |
| DISP. | DISPENSER |
| EA. | EACH |
| ELEC. | ELECTRICAL |
| ENT. | ENTRANCE |
| ENG | ELECTRIC WATER CLOSET |
| FG. | FIBERGLASS |
| FLR. | FLOOR |
| GA. | GALVANIZED |
| GALV. | GALVANIZED |
| GWB | GYPSUM WALL BOARD |
| HGT. | HEIGHT |
| H.M. | HOLLOW METAL |
| HOL. | HOLLOW |
| INSUL. | INSULATED, INSULATION |
| INT. | INTERIOR |
| LVL. | LEVEL |
| MACH. | MACHINE |
| MAX. | MAXIMUM |
| MECH. | MECHANICAL |
| MET. | METAL |
| MIN. | MINIMUM |
| MSL. | MEAN SEA LEVEL |
| N.T.S. | NOT TO SCALE |
| O.C. | ON CENTER |
| OFF. | OFFICE |
| O.H. | OVERTHEAD |
| P.O.B. | POINT OF BEARING |
| PAR. | PAR |
| PSI | POUNDS PER SQUARE INCH |
| PSF | POUNDS PER SQUARE FOOT |
| RECEPT. | RECEPTACLE |
| REINFC. | REINFORCED |
| RIVERINE | RIVERINE TASK UNIT COMMANDER OFFICE |
| RIVUD | RIVERINE TASK UNIT OFFICE |
| SCH. | SCHEDULE |
| S.F. | SQUARE FEET |
| SHT. | SHEET |
| SHOWR. | SHOWER |
| SITUO | SQUADRON INTEROPERABILITY TASK UNIT COMMANDER OFFICE |
| SITUO | SQUADRON INTEROPERABILITY TASK UNIT OFFICE |
| SSSSMR | STRUCTURAL STANDING SEAM METAL ROOF |
| STC | SOUND TRANSMISSION COEFFICIENT |
| STL. | STEEL |
| SUSP. | SUSPENDED |
| SYST. | SYSTEM |
| TEL. COMM. | TELECOMMUNICATIONS |
| THK. | THICK |
| T.O.M. | TOP OF MASONRY |
| T.O.S. | TOP OF SLAB |
| TYP. | TYPICAL |
| UFAS | UNIFORM FEDERAL ACCESSIBILITY STANDARD |
| VERT. | VERTICAL |
| VEST. | VESTIBULE |
| WH | WATER HEATER |
| WWE | WELDED WIRE FABRIC |

**RECORD DRAWING
LETTER DATED -
5-27-10**



| <p>DEPARTMENT OF THE NAVY NAVAL FACILITIES ENGINEERING COMMAND SOUTHAST IPT GULF COAST</p> <p>MISSISSIPPI JOHN C. STENNIS SPACE CENTER</p> <p>SOF RIVERINE AND COMBATANT CRAFT OPERATIONS FACILITY - PRE-FINAL</p> <p>ARCHITECTURAL GENERAL NOTES & TITLE SHEET</p> | <p>NAVAL FACILITIES ENGINEERING COMMAND NAVAL AIR STATION JACKSONVILLE</p> <p>PROJECT NO. 15026677</p> <p>DATE: 11/11/09</p> | <p>DESIGNED BY: B. WILHELM</p> <p>CHECKED BY: R. DAMON</p> <p>DATE: 11/11/09</p> | <p>EMMETT G. DAMON REGISTERED PROFESSIONAL ARCHITECT STATE OF MISSISSIPPI NO. 982</p> | <p>DAMON ENGINEERING, INC. REGISTERED PROFESSIONAL ENGINEER STATE OF MISSISSIPPI NO. 45898 (989) 649-8832</p> | <p>REVISIONS</p> <table border="1"> <tr> <th>NO.</th> <th>DATE</th> <th>DESCRIPTION</th> </tr> <tr> <td>AS-BUILT</td> <td>3-12-10</td> <td>RW</td> </tr> <tr> <td>REVISED AS PER URS COMMENTS 9 OCTOBER 2009</td> <td>11-6-09</td> <td>RW</td> </tr> </table> | NO. | DATE | DESCRIPTION | AS-BUILT | 3-12-10 | RW | REVISED AS PER URS COMMENTS 9 OCTOBER 2009 | 11-6-09 | RW |
|--|--|--|---|---|---|-----|------|-------------|----------|---------|----|--|---------|----|
| NO. | DATE | DESCRIPTION | | | | | | | | | | | | |
| AS-BUILT | 3-12-10 | RW | | | | | | | | | | | | |
| REVISED AS PER URS COMMENTS 9 OCTOBER 2009 | 11-6-09 | RW | | | | | | | | | | | | |

REVDATE:

A

B

C

D

1

2

1

3

1

4

5

A

B

C

D