


ENLARGED INTERIOR STAIR
AND VESTIBULE PLAN
SCALE: 1/2" = 1'-0"
PLAN NORTH



RECORD DRAWING
LETTER DATED -
5-27-10

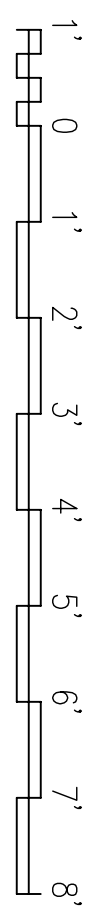

DEPARTMENT OF THE NAVY NAVAL FACILITIES ENGINEERING COMMAND SOUTHEAST IPT GULF COAST JOHN C. STENNIS SPACE CENTER MISSISSIPPI SOF RIVERINE AND COMBATANT CRAFT OPERATIONS FACILITY - PRE-FINAL ENLARGED INTERIOR STAIR & VESTIBULE PLAN		DAMMON ENGINEERING, INC. ENGINEER CHEF ENGINEER DAMMON, P. E., P.E. SUDOL, L.A. 70152 (985) 649-5312 SEPTEMBER 4, 2009		EMMET B. DAMMON LICENSED PROFESSIONAL ENGINEER STATE OF MISSISSIPPI 9662		RES. R. WITSE DRAWN: J. THREANY CHECKED BY: R. WITSE PWD/INK: T. ARBIB CHIEF ENGINEER: P. DAMMON		AS-BUILT REVISED AS PER URS COMMENTS 9 OCTOBER 2009		4-25-10	RW
NAFAAC 		DEPARTMENT OF THE NAVY NAVAL FACILITIES ENGINEERING COMMAND SOUTHEAST IPT GULF COAST JOHN C. STENNIS SPACE CENTER MISSISSIPPI SOF RIVERINE AND COMBATANT CRAFT OPERATIONS FACILITY - PRE-FINAL ENLARGED INTERIOR STAIR & VESTIBULE PLAN		DAMMON ENGINEERING, INC. ENGINEER CHEF ENGINEER DAMMON, P. E., P.E. SUDOL, L.A. 70152 (985) 649-5312 SEPTEMBER 4, 2009		EMMET B. DAMMON LICENSED PROFESSIONAL ENGINEER STATE OF MISSISSIPPI 9662		RES. R. WITSE DRAWN: J. THREANY CHECKED BY: R. WITSE PWD/INK: T. ARBIB CHIEF ENGINEER: P. DAMMON		11-6-09	RW
SYM	DESCRIPTION	DATE	APPR								