


RECORD DRAWING
 LETTER DATED -
 5-27-10



	AS-BUILT	4-25-10	RW
	REVISED AS PER URS COMMENTS 9 OCTOBER 2009	11-6-09	RW
SYM	DESCRIPTION	DATE	APPR

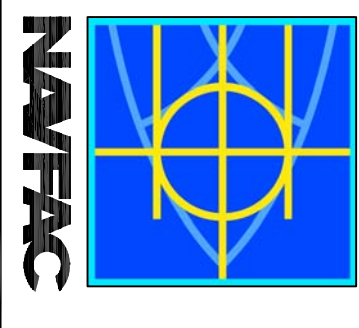

DAMMON
 ENGINEERING, INC.
 1000 W. UNIVERSITY BLVD.
 SUITE 100
 DARMON, LA 70625
 (985) 649-5812
 ESTABLISHED 1978

DESIGNED BY: R. WILSE
 DRAWN BY: J. MURPHY
 CHECKED BY: T. ARBIB
 IN CHARGE: P. DAMMON

DEPARTMENT OF THE NAVY
 NAVAL FACILITIES ENGINEERING COMMAND
 NAVAL AIR STATION JACKSONVILLE
 JOHN C. STENNIS SPACE CENTER
 MISSISSIPPI
**SOF RIVERINE AND COMBATANT
 CRAFT OPERATIONS FACILITY - PRE-FINAL**
 OPS./MAINT. BLDG. 2440/2441 ROOF PLAN

CODE ID: NGS 14412 | SIZE: 0
 SCALE: AS SHOWN
 DRAWING NO.: P-210
 STA. PROJ. NO.: 510247
 WORK ORDER NO.: N62467-05-0-0096
 CONSTR. CONTR. NO.: N62467-05-0-0096
 NAVFAC DRAWING NO.: 15026931
 SHEET: 44 OF 132
A1.14