


**BUILDING 2440 SECTION**  
SCALE: 3/8" = 1'-0"

A1.1  
A1.2



**RECORD DRAWING  
LETTER DATED -  
5-27-10**

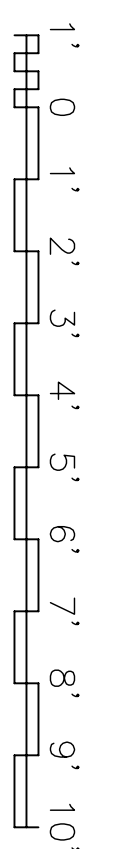

DEPARTMENT OF THE NAVY <b>NAVAL FACILITIES ENGINEERING COMMAND SOUTHEAST</b> NAVAL AIR STATION JACKSONVILLE MISSISSIPPI		NAVAL FACILITIES ENGINEERING COMMAND <b>SOF RIVERINE AND COMBATANT                  CRAFT OPERATIONS FACILITY - PRE-FINAL</b> OPERATIONS BLDG. 2440 SECTION	
JOHN C. STENNIS SPACE CENTER MISSISSIPPI		DAMMON ENGINEERING, INC. 1000 W. GULF SHORE SUITE 100, LA 70302 (985) 649-4312	
DESIGNED BY: R. WHITE DRAWN BY: J. HERRMAN CHECKED BY: T. ARBIB IN CHARGE: P. DAMMON		DATE: 11-10-09 REVISION: 3-12-10	
CODE ID NO. NA412 SCALE: AS SHOWN SHEET NO. P-210 WORK ORDER NO. 510247 CONTR. CENTER NO. N62467-05-0-0096 DRAWING NO. 150026880 SHEET 33 OF 132	AS-BUILT REVISED AS PER URS COMMENTS 9 OCTOBER 2009		
SYM	DESCRIPTION	DATE	APPR