


**RIGHT SIDE ELEVATION**  
SCALE: 1/4" = 1'-0"  
A2.1

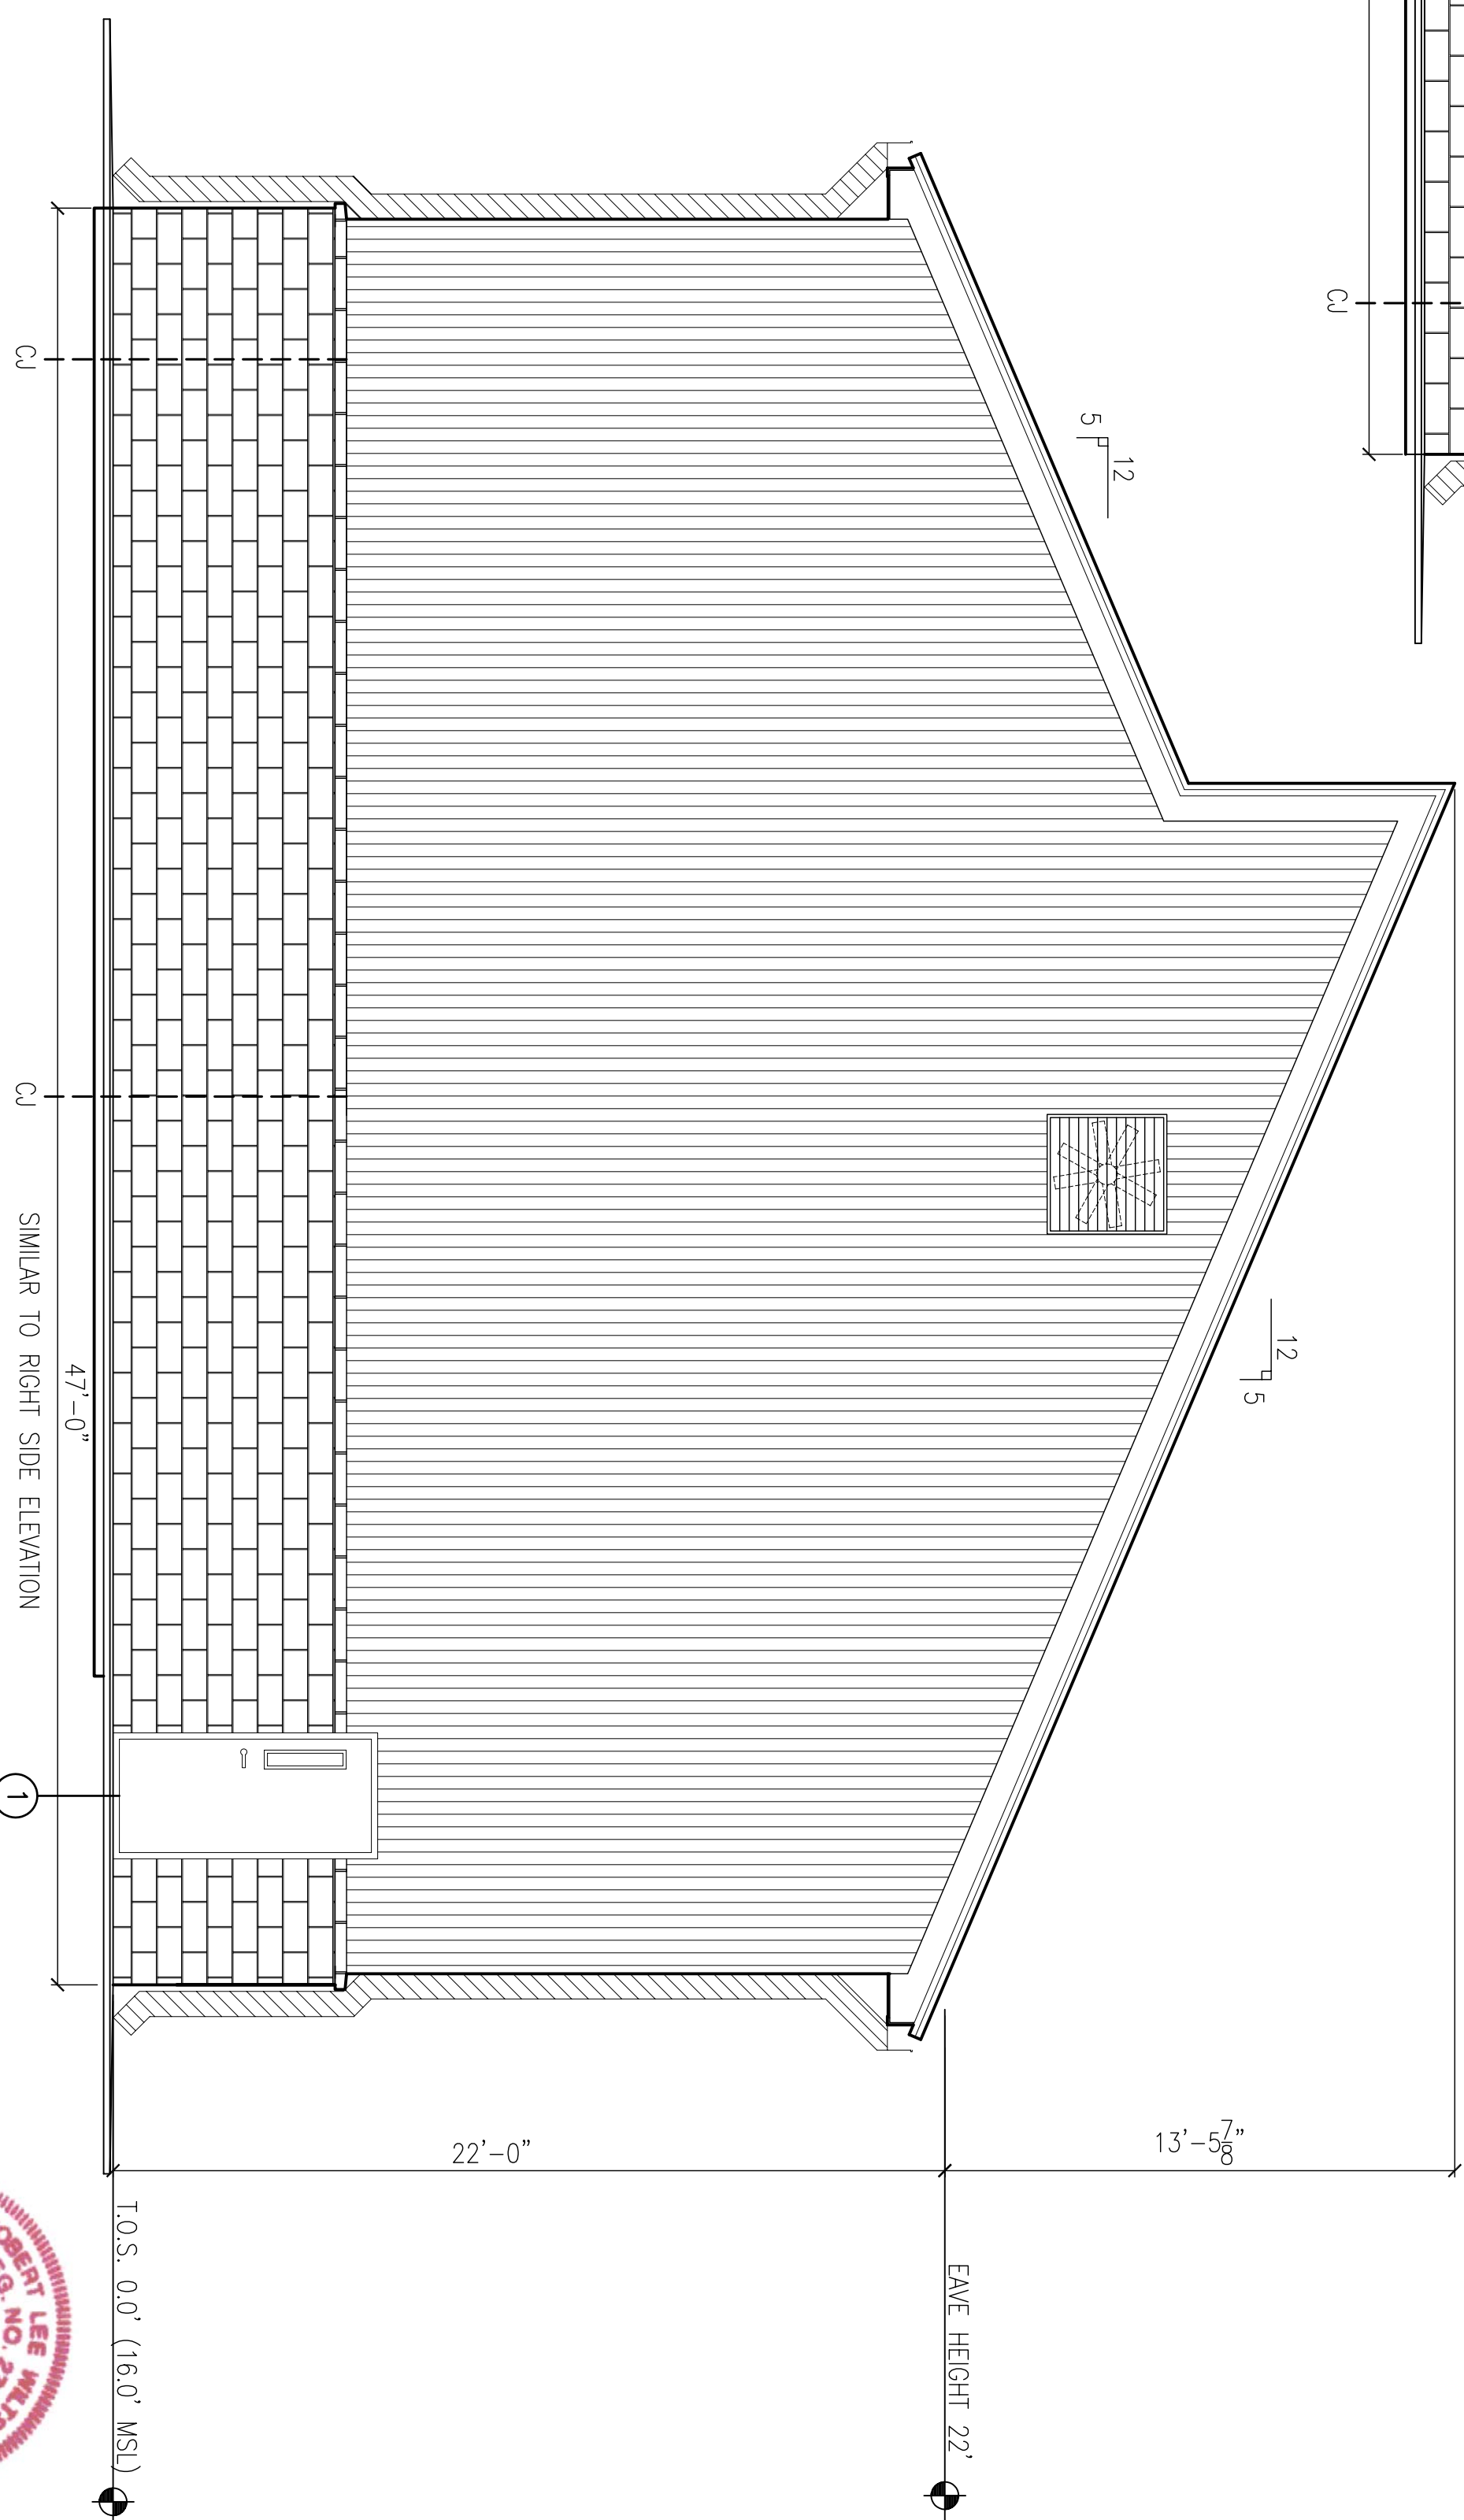

**LEFT SIDE ELEVATION**  
SCALE: 1/4" = 1'-0"  
A2.1

SIMILAR TO RIGHT SIDE ELEVATION

**RECORD DRAWING**  
LETTER DATED -  
5-27-10



DEPARTMENT OF THE NAVY <b>NAVAL FACILITIES ENGINEERING COMMAND SOUTHEAST</b> IPT GULF COAST NAVAL AIR STATION JACKSONVILLE		NAVAL FACILITIES ENGINEERING COMMAND MISSISSIPPI <b>SOF RIVERINE AND COMBATANT CRAFT OPERATIONS FACILITY - PRE-FINAL</b>		<b>BOAT STORAGE BLDG. 2442 ELEVATIONS</b>	
JOHN C. STENNIS SPACE CENTER		MISSISSIPPI		DAMMON ENGINEERING, INC. ENGINEER CHEF ENGINEER DAMMON & COMPANY, INC. 5100 LA 7052 SUITE 100 (985) 649-5832 <small>ESTABLISHED 1982</small>	
CODE ID. NO. N4412 SIZE: D SCALE: AS SHOWN DRAWING NO. ##### STA. PROJ. NO. P-210 WORK ORDER NO. 510247 CONSTR. CONTR. NO. N62467-05-0-0096 NAFAFC DRAWING NO. 15026704 SHEET 37 OF 132		RES. R. WILTSE DRAW. J. THANNY CHECKED BY: R. WILTSE PLOTTED BY: T. ARBIB CHECKED BY: P. DAMMON			
A2.4		AS-BUILT		4-25-10	RW
SYM		DESCRIPTION		DATE	APPR