

REVDATE:

A

B

C

D

1

2

3

4

5


1

2


3

4

5

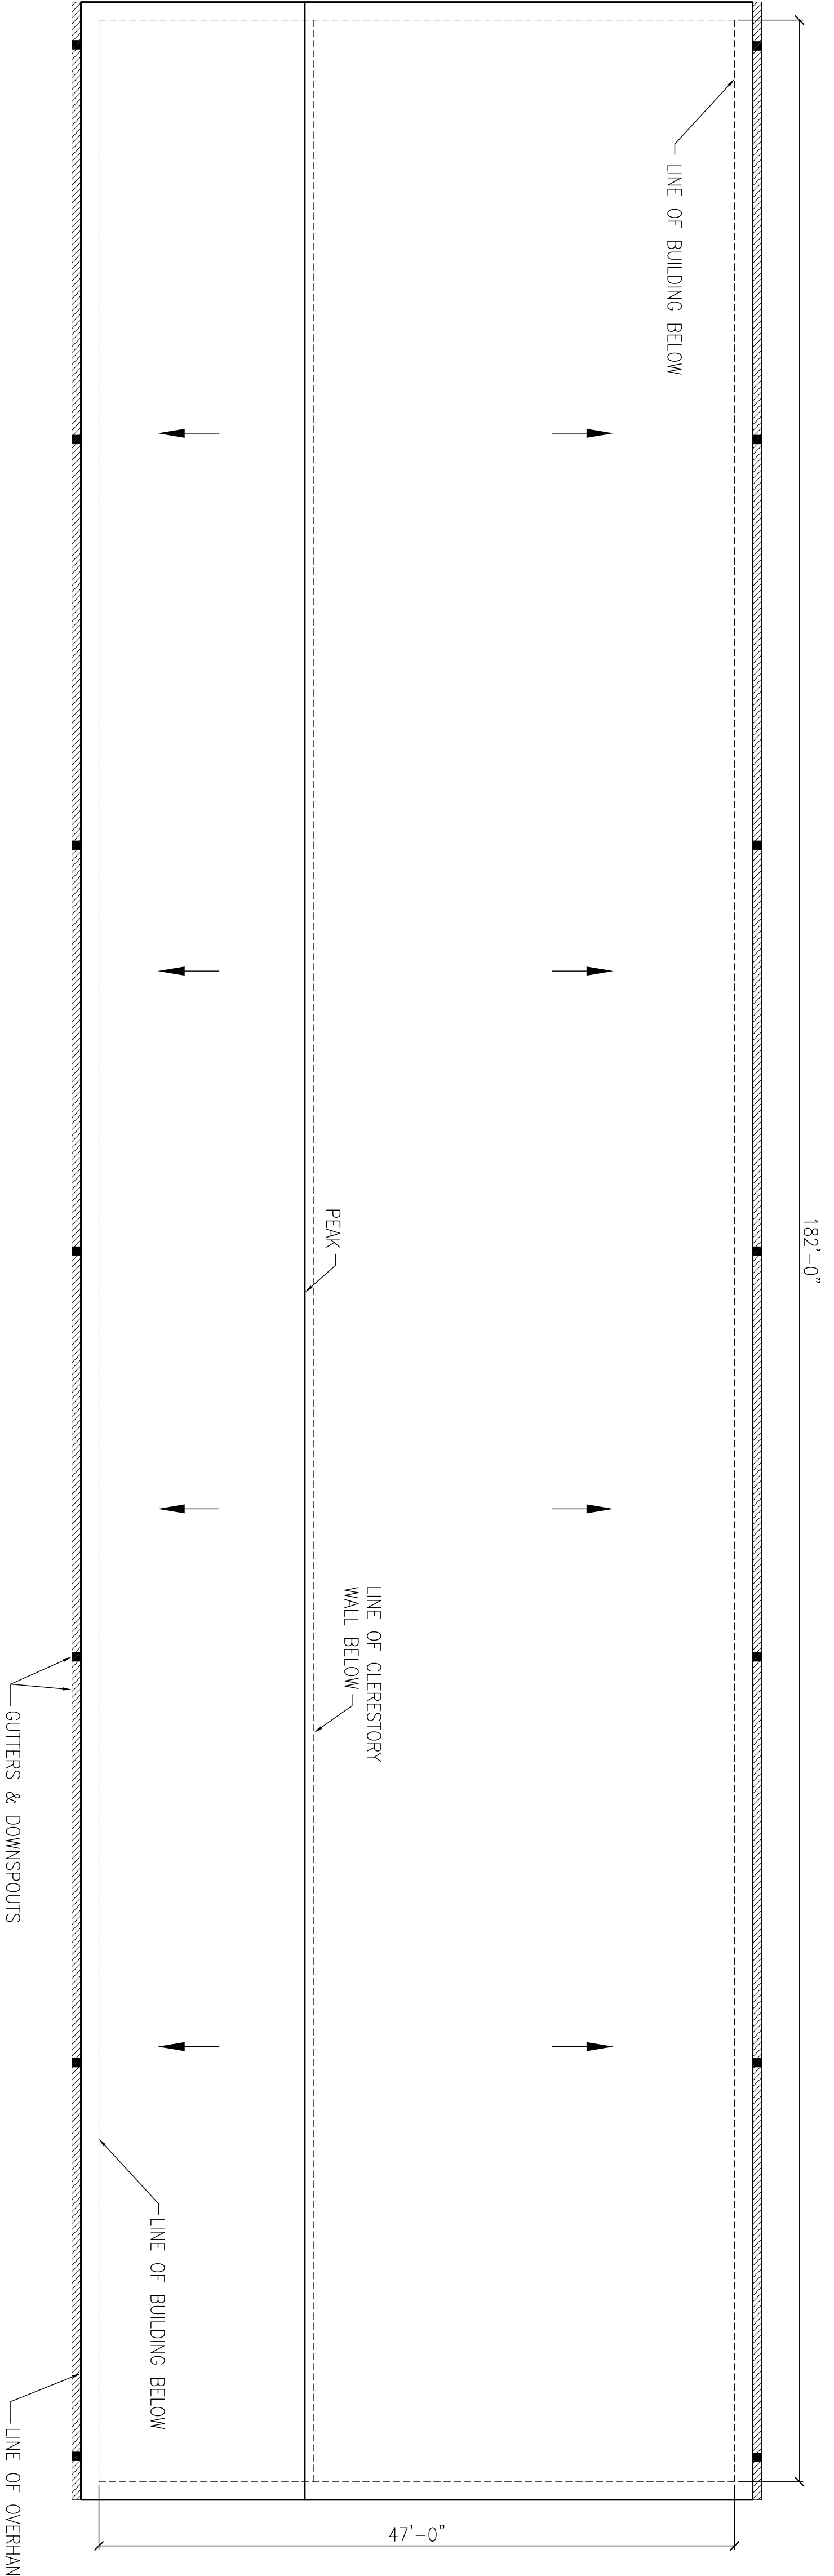

BOAT STORAGE BLDG. 2442 ROOF PLAN  
 SCALE: 1/8" = 1'-0"  
 PLAN NORTH

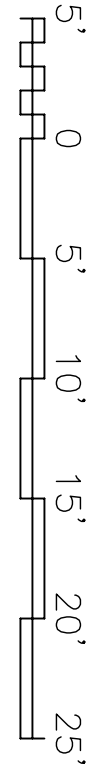

RECORD DRAWING  
 LETTER DATED -  
 5-27-10



			DESIGNED BY: R. WILSE DRAWN BY: J. THREANI CHECKED BY: T. LARSEN IN CHARGE: P. DAMMON	DEPARTMENT OF THE NAVY NAVAL FACILITIES ENGINEERING COMMAND SOUTH EAST NAVAL AIR STATION JACKSONVILLE MISSISSIPPI JOHN C. STENNIS SPACE CENTER SOF RIVERINE AND COMBATANT CRAFT OPERATIONS FACILITY - PRE-FINAL BOAT STORAGE BLDG. 2442 ROOF PLAN	CODE ID. NO. 14412   SIZE: D SCALE: AS SHOWN DRAWING NO. ##### STA. PROJ. NO. P-2110 WORK ORDER NO. 510247 CONSTR. CONTR. NO. N62467-05-0-0096 NAVFAC DRAWING NO. 15026706 SHEET 39 OF 132 <b>A26</b>	AS-BUILT DATE: 4-25-10 APPR: RW
	SYM DESCRIPTION		DATE DATE	APPR APPR		

A

B

C

D