



REVDATE: _____

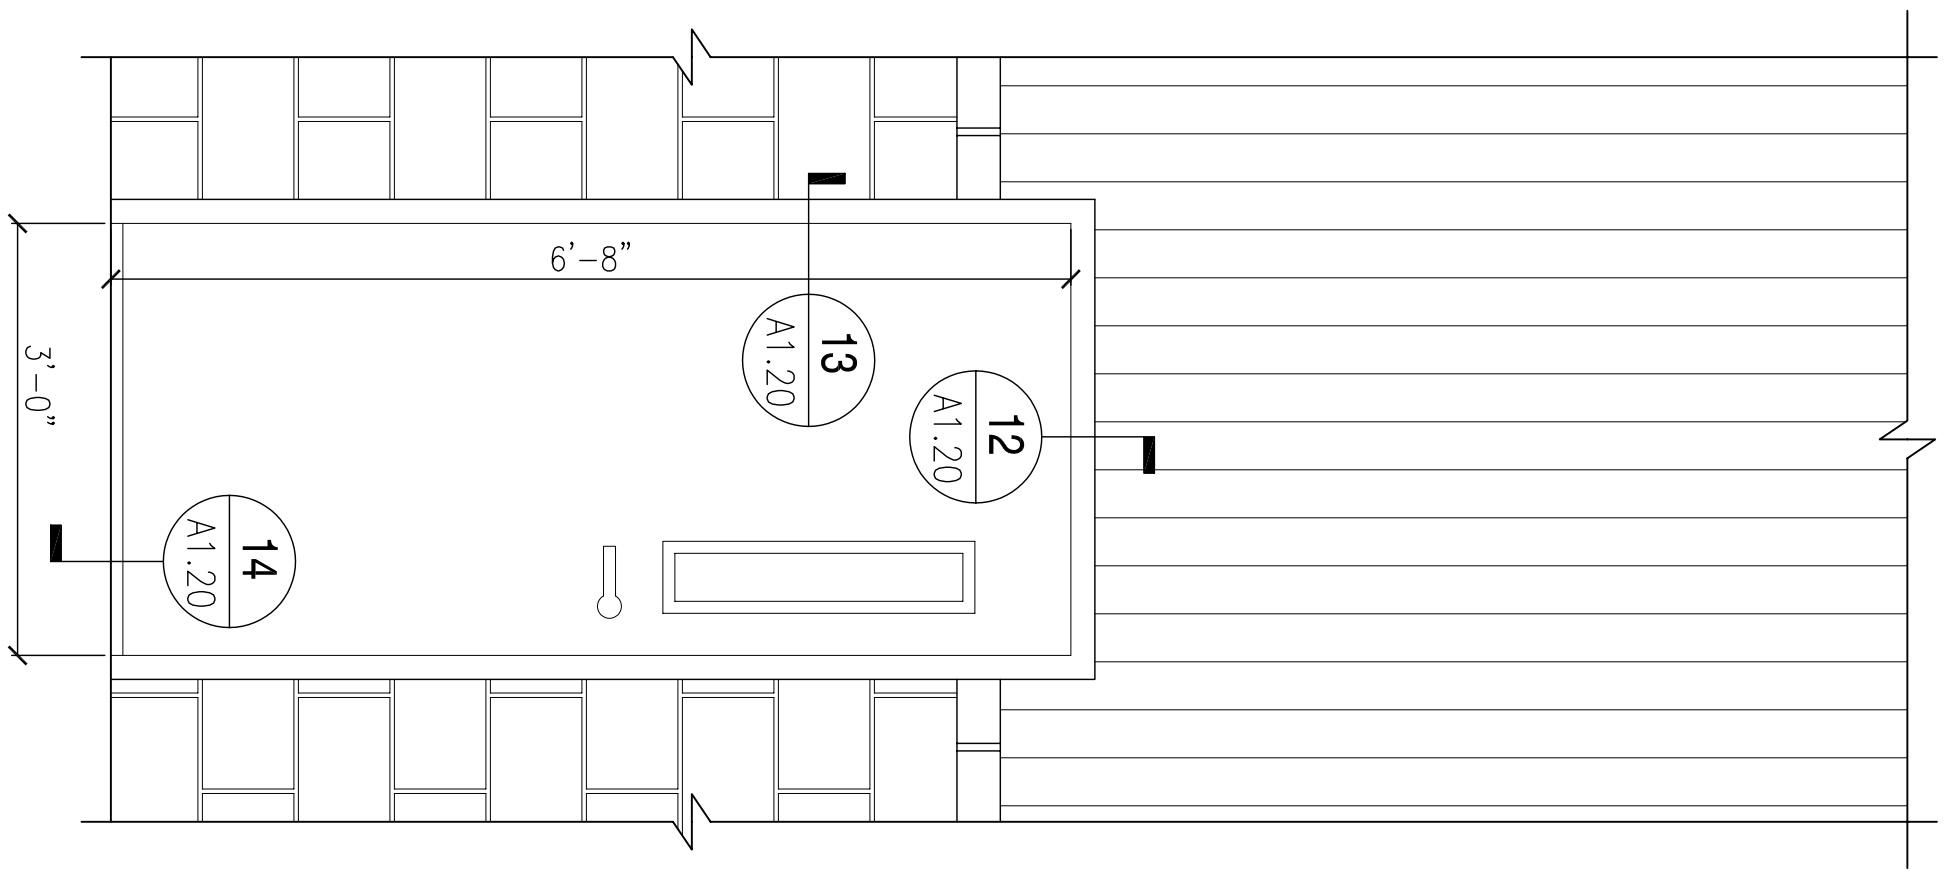


TYP. EXT. SINGLE
3/4" = 1'-0" (1)

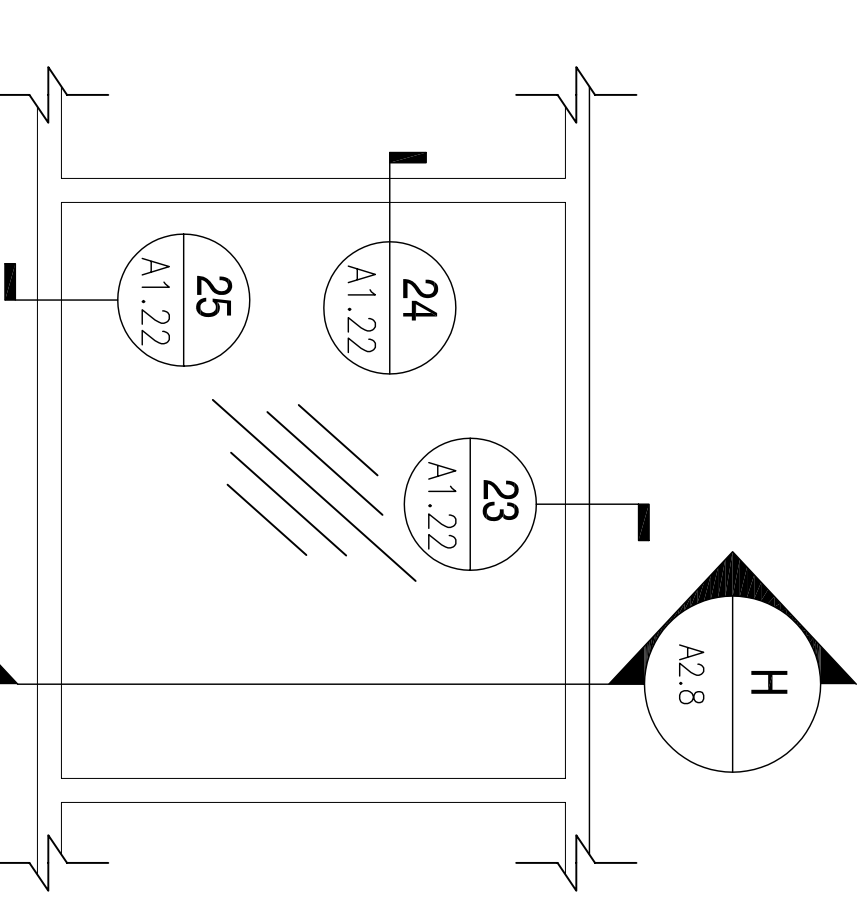

TYP. EXT. OVERHEAD
3/4" = 1'-0" (2)

TYP. CLERESTORY WINDOW
3/4" = 1'-0" (A)

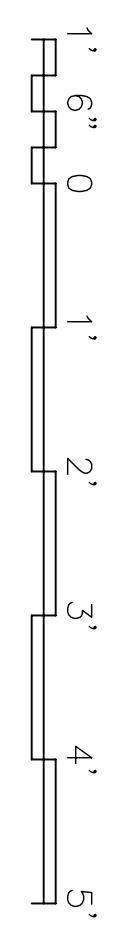

RECORD DRAWING
LETTER DATED -
5-27-10



DEPARTMENT OF THE NAVY NAVAL FACILITIES ENGINEERING COMMAND SOUTHEAST IPT GULF COAST NAVAL AIR STATION JACKSONVILLE MISSISSIPPI		JOHN C. STENNIS SPACE CENTER SOF RIVERINE AND COMBATANT CRAFT OPERATIONS FACILITY - PRE-FINAL BLDG. 2442 DOOR & WINDOW ELEVATIONS	
DESIGNED BY: R. WILTSE DRAWN BY: J. HERNANDEZ CHECKED BY: T. ARBIB IN CHARGE: P. DAMMON	REGISTERED PROFESSIONAL ENGINEER EMMETT B. DAMMON LICENSE NO. 9852 STATE OF MISSISSIPPI 5/27/2010	DAMMON ENGINEERING, INC. 11111 W. BRIDGES BLVD. SUITE 100 DALLAS, TEXAS 75244 (980) 649-8812	AS-BUILT REVISED AS PER URS COMMENTS 9 OCTOBER 2009 4-25-10 11-6-09 RW RW
CODE ID: NGS 14412 SIZE: 0 SCALE: AS SHOWN DRAWING NO.: ##### STA. PROJ. NO.: P-2110 WORK ORDER NO.: 510247 CONSTR. CONTR. NO.: N62467-05-0-0096 NAVFAC DRAWING NO.: 15006702 SHEET: 80 OF 132		SYM DESCRIPTION DATE APPR	

1 2 3 4 5

1 2 3 4 5

A B C D