

GENERAL NOTES

- SITE NOTES**
1. THE LOCATION OF THE PROPOSED UTILITIES AND STRUCTURES SHOWN HEREON ARE APPROXIMATE. IT SHALL BE THE RESPONSIBILITY OF THE DESIGN-BUILDER TO VERIFY THE EXISTENCE AND ACTUAL LOCATION OF SUCH. WHETHER SHOW HEREON OR NOT, PRIOR TO ANY EXCAVATION, ANY DAMAGES SHALL BE REPAIRED AT THE EXPENSE OF THE DESIGN-BUILDER.
 2. ALL BEARINGS SHOWN ARE REFERENCED TO NAD 83, MISSISSIPPI EAST ZONE AND ARE EXPRESSED IN U.S. SURVEY FEET. PER SURVEY PROVIDED BY RFP, SURVEY BY PITTMAN, GLAZE, AND ASSOC. FILE NO. C-5907, 2-1-08.
 3. ALL ELEVATIONS SHOWN ARE REFERENCED TO NAVD 88, AND ARE EXPRESSED IN U.S. SURVEY FEET. PER SURVEY PROVIDED BY RFP, SURVEY BY PITTMAN, GLAZE, AND ASSOC. FILE NO. C-5907, 2-1-08.


SIDEWALKS

1. EXPANSION JOINTS SHALL BE CONSTRUCTED OF 1/2" THICK PRE-MOLDED EXPANSION MATERIAL WITH ALL CORNERS TO BE FORMED BY EXPANSION JOINTS.
2. ANY SIDEWALK OR ACCESSIBLE ROUTE THAT IS NOT A LEVEL ELEVATION AT ITS INTERSECTION WITH A DRIVEWAY OR STREET WILL BE REQUIRED TO INSTALL A CURB RAMP PER UFAS REQUIREMENTS. CURB RAMPS TO BE INTEGRALLY COLORED TO CONTRAST WITH ADJACENT SIDEWALK AND STREET SURFACES.
3. INTERSECTIONS BETWEEN ACCESSIBLE ROUTES AND DRIVEWAYS SHALL BE FITTED WITH PREMANUFACTURED DETECTABLE WARNING SURFACES COMPLYING WITH ADAAG SECTION 4.29.2 FORMING AN INTEGRAL PART OF THE SIDEWALK SURFACE.

PARKING LOT

1. PARKING STALLS SHALL BE STRIPED WITH A 4" CONTRASTING WHITE (BLUE FOR HANDICAP) STRIPE.
2. HANDICAP PARKING SPACES SHALL BE DESIGNATED BY BLUE STRIPING AND EITHER A BLUE SYMBOL ON A WHITE BACKGROUND OR A WHITE SYMBOL ON A BLUE BACKGROUND. ALL HANDICAP PARKING STALLS REQUIRE THE INSTALLATION OF SIGNAGE COMPLYING WITH UFAS.
3. ALL WHEEL STOPS AND CONCRETE CURBS SHALL BE CONSTRUCTED IN ACCORDANCE WITH THE CIVIL DRAWINGS.
4. HANDICAP PARKING AND ACCESS AISLES SHALL BE LEVEL WITH SURFACE SLOPES NOT EXCEEDING 1:50 IN ALL DIRECTIONS.


LEGEND

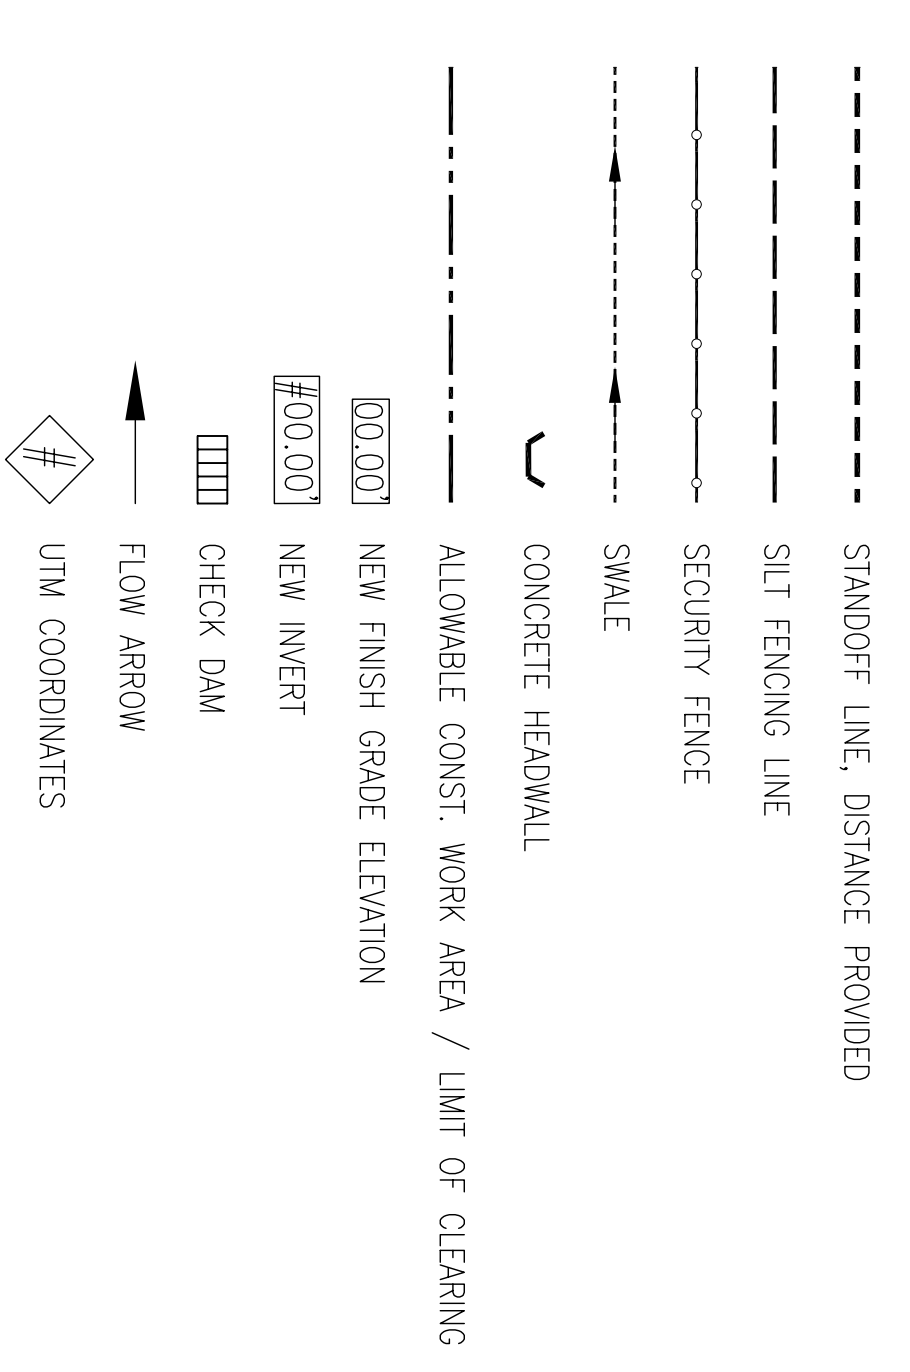

ACRONYMS & ABBREVIATIONS:

ASTM	AMERICAN SOCIETY FOR TESTING AND MATERIAL
BLDG.	BUILDING
CU	CONTROL JOINT
CMP	CORRUGATED METAL PIPE
DIA.	DIAMETER
EA	EACH
EJ	EXPANSION JOINT
ELEV.	ELEVATION
EMCS	ENERGY MANAGEMENT CONTROL SYSTEMS
MAX.	MAXIMUM
MIN.	MINIMUM
O.C.	ON CENTER
RCP	REINFORCED CONCRETE PIPE
REQD.	REQUIRED
SHT.	SHEET
SIM.	SIMILAR
SJ	SIDEWALK JOINT
STD.	STANDARD
T.O.B.	TOP OF BANK
T.O.G.	TOP OF GRATE
TYP.	TYPICAL

RECORD DRAWING
LETTER DATED -
5-27-10

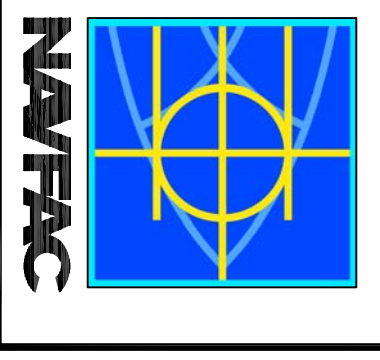

DAMMON
ENGINEERING, INC.
CHIEF ENGINEER
DAMMON, P. O. BOX 4000
SUITE 100
MOBILE, LA 39682
(985) 649-4312
ESTABLISHED 1962



DEPARTMENT OF THE NAVY
NAVAL FACILITIES ENGINEERING COMMAND
NAVAL FACILITIES ENGINEERING COMMAND SOUTHEAST
NAVAL AIR STATION JACKSONVILLE
MISSISSIPPI
JOHN C. STENNIS SPACE CENTER
**SOF RIVERINE AND COMBATANT
CRAFT OPERATIONS FACILITY - PRE-FINAL**
CIVIL GENERAL PROJECT NOTES & TITLE SHEET

DESIGNED BY: R. WITSE
DRAWN BY: J. TIRANAY
CHECKED BY: T. ARBIB
CHIEF ENGINEER: P. DAMMON

SCALE: AS SHOWN
SHEET NO. P-210
WORK ORDER NO. 510247
CONSTR. CONTR. NO. N62467-05-0-0096
NAVFAC DRAWING NO. 15026553
SHEET 6 OF 132