



**7**  
SINGLE ROLLING CANTILEVER GATE DETAIL  
NOT TO SCALE  
C1.1

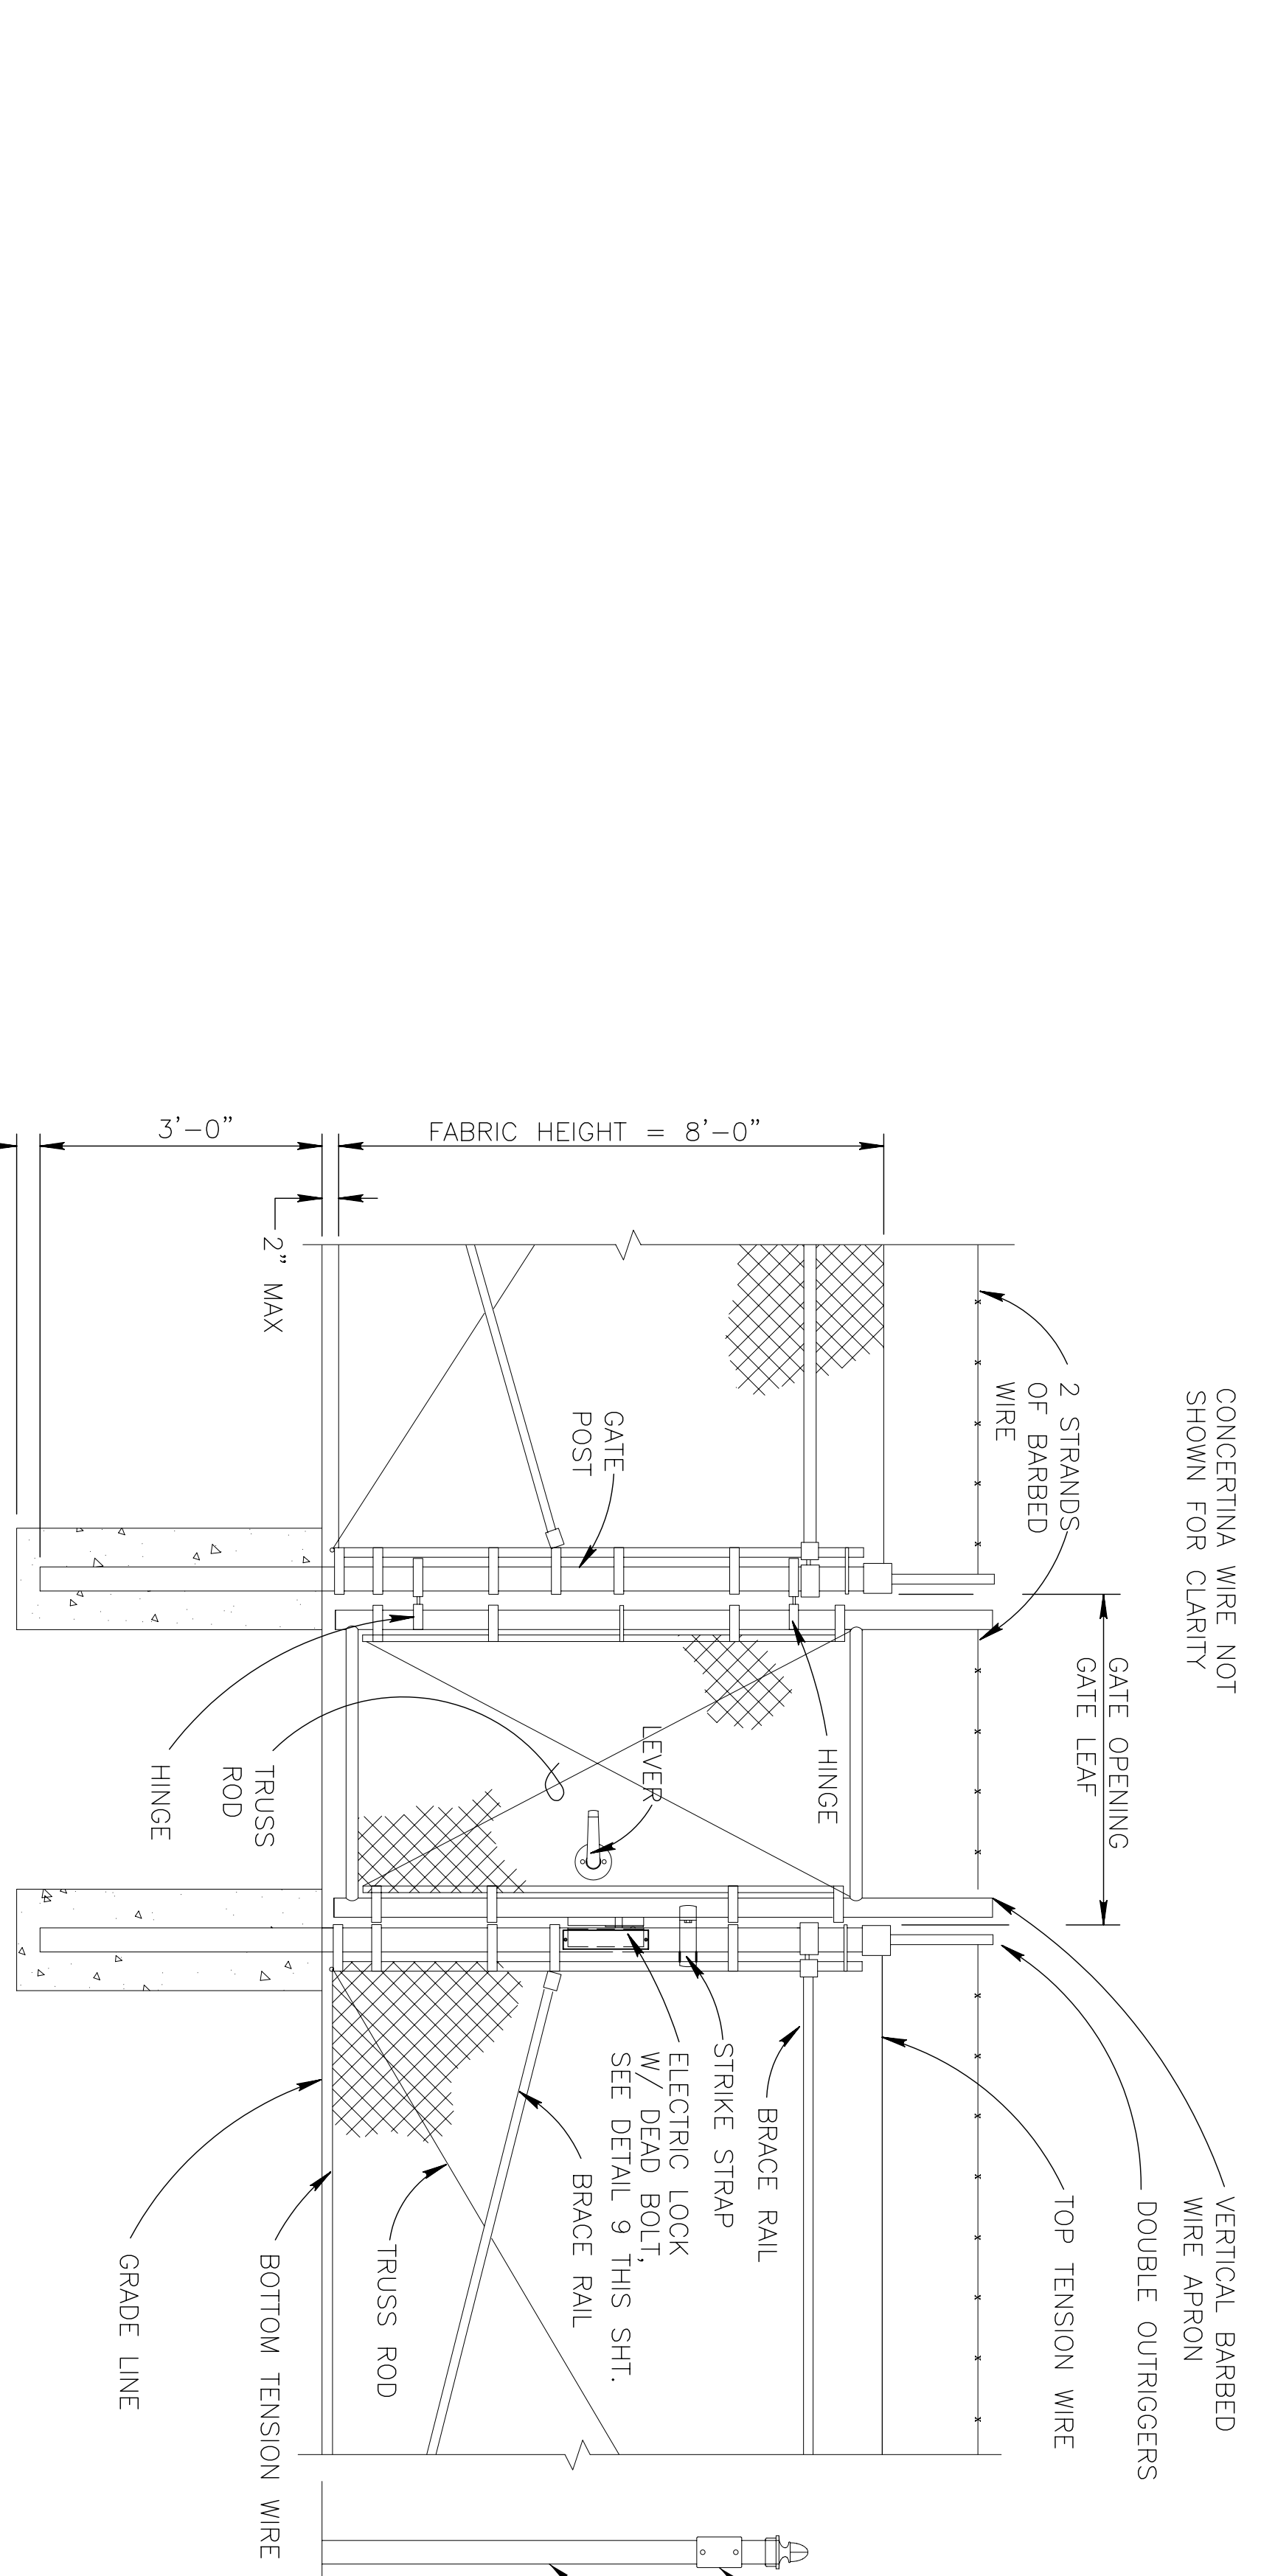

**8**  
PERSONNEL GATE DETAIL  
NOT TO SCALE  
C1.1

**FENCING NOTES**

1. BOTTOM TENSION WIRE, IT SHALL BE INSTALLED APPROX. 3" ABOVE GRADE (A MINIMUM OF 2" AND A MAXIMUM OF 4"), ATTACH FABRIC TO BOTTOM TENSION WIRE TO ELIMINATE POSSIBILITY OF PEELING UP FABRIC.
2. SECURE ALL FASTENING HARDWARE BY PEENING OR WELDING AS SPECIFIED.
3. PROVIDE POLYVINYL CHLORIDE (PVC) COATING OVER ZINC-COATED STEEL FENCE COMPONENTS IN ACCORDANCE WITH FS RR-F-191/1, TYPE IV FOR FENCING SYSTEMS. PVC COATING SHALL BE GREEN IN COLOR AND A MINIMUM OF 0.10 INCH IN THICKNESS.
4. GROUND FENCE ON EITHER SIDE OF EVERY GATE AND AT OTHER LOCATIONS AS SPECIFIED.
5. PROVIDE GALVANIZED PERSONNEL GATE NOMINAL 12' WIDE BY 8' HIGH WITH PADLOCK GATE LATCH AND PRIVACY SLATS.
6. PROVIDE LOOP DETECTOR TO AUTOMATICALLY CLOSE GATE ONCE VEHICLE PASSES.

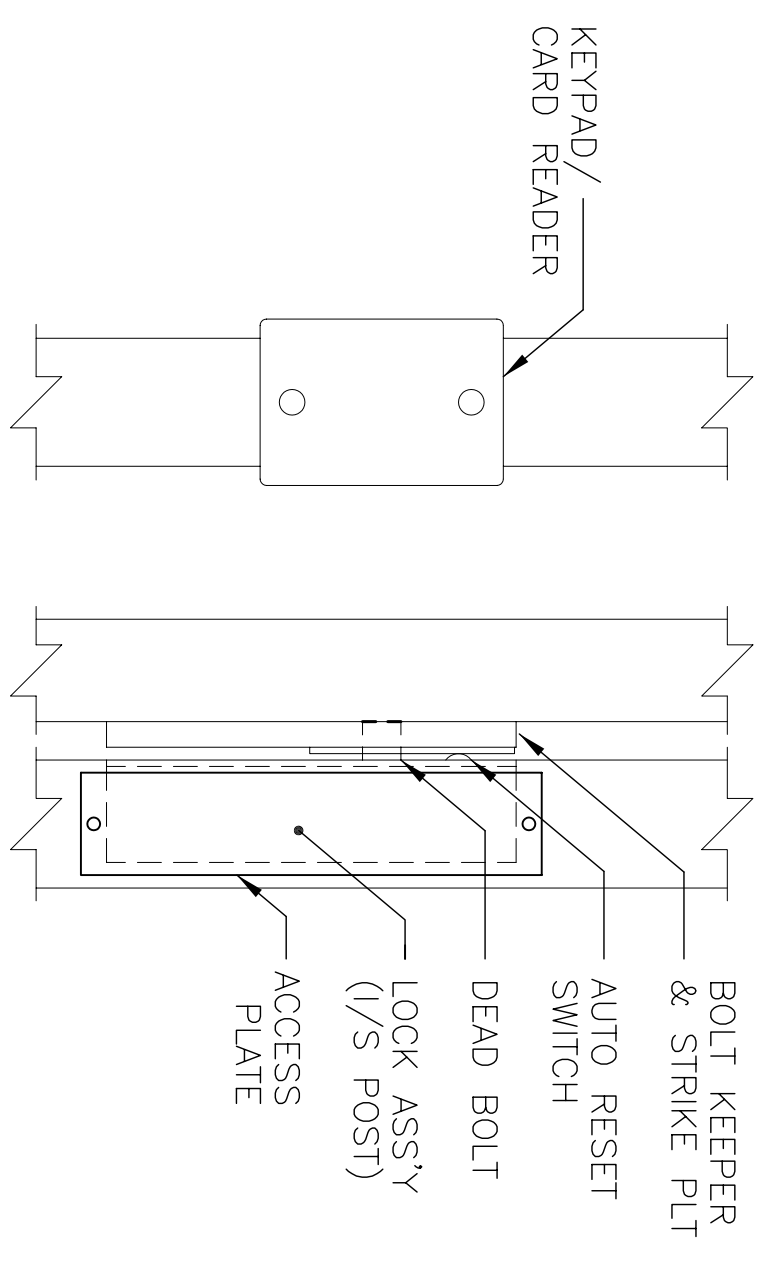

**9**  
GATE LATCH DETAIL  
NOT TO SCALE  
C1.5

**RECORD DRAWING**  
LETTER DATED -  
5-27-10



**DAMMON ENGINEERING, INC.**  
REGISTERED PROFESSIONAL ENGINEER  
STATE OF LOUISIANA  
1500 N. WILSON BLVD., SUITE 100  
DAMMON, LA 70038  
(985) 649-4312  
September 4, 2009



DEPARTMENT OF THE NAVY  
NAVAL FACILITIES ENGINEERING COMMAND SOUTHEAST  
NAVAL AIR STATION JACKSONVILLE  
MISSISSIPPI  
JOHN C. STENNIS SPACE CENTER  
**SOF RIVERINE AND COMBATANT CRAFT OPERATIONS FACILITY - PRE-FINAL**  
SITE CIVIL DETAILS

DES: R. WITSE    DWN: J. LOONIE  
REVIEWED BY: R. WITSE  
PWL/INK: T. JARRETT  
CHIEF ENGINEER: P. DAMMON

CODE ID NO. N4412    SIZE: D  
SCALE: AS SHOWN  
DRAWING NO. #####  
SFA PROJ. NO. P-210  
WORK ORDER NO. 510247  
CONSTR. CONTR. NO. N62467-05-0-0096  
NAVFAC DRAWING NO. 15026558  
SHEET 11 OF 132

SYM	DESCRIPTION	DATE	APPR
	AS-BUILT	3-12-10	RW
	REVISED AS PER URS COMMENTS 17 NOVEMBER 2009	11-17-09	RW
	REVISED AS PER URS COMMENTS 9 OCTOBER 2009	11-6-09	RW