


ENLARGED VEHICLE / PEDESTRIAN ENTRANCE  
 SCALE: 1/8"=1'-0"  
 PLAN NORTH

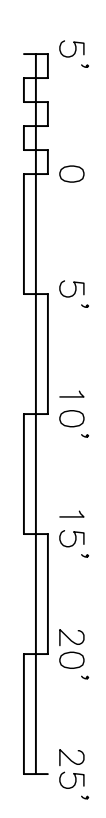

RECORD DRAWING  
 LETTER DATED -  
 5-27-10



DEPARTMENT OF THE NAVY NAVAL FACILITIES ENGINEERING COMMAND SOUTHEAST IPT GULF COAST JOHN C. STENNIS SPACE CENTER MISSISSIPPI <b>SOF RIVERINE AND COMBATANT CRAFT OPERATIONS FACILITY - PRE-FINAL</b> ENLARGED VEHICLE / PEDESTRIAN ENTRANCE	NAVAL FACILITIES ENGINEERING COMMAND NAVAL AIR STATION JACKSONVILLE MISSISSIPPI	DESIGNED BY: R. WILTSIE DRAWN BY: J. JEFFREY	EMMETT G. DAMMON LICENSED PROFESSIONAL ARCHITECT STATE OF MISSISSIPPI 9882	DAMMON ENGINEERING, INC. 10000 W. GULF BLVD. SUITE 200 DUNWOODY, GA 30115 (770) 403-8832		AS-BUILT	3-12-10	RW
		CHECKED BY: L. LARSEN CHIEF ENG/ARCH: P. DAMMON					DATE	APPR
CODE ID NO. N4412   SIZE: 0 SCALE: AS SHOWN MAXIMUM NO. OF SHEETS: 19 SHEET NO.: 19 OF 132		SHEET NO. 19 OF 132		C33				