


LANDSCAPING NOTES

1. EDGING MATERIALS: PROVIDE CONCRETE. EDGING MATERIAL AROUND ALL LANDSCAPE BEDS AND INDIVIDUALLY PLANTED SPECIMEN PLANTS. COLOR SHALL BE GREEN.
2. WEED FABRIC: PROVIDE A WEED BARRIER FABRIC OF SHEET POLYETHYLENE CONFORMING TO ASTM D 2103 OR OTHER POLYPROPYLENE OR POLYESTER FABRIC SPECIFICALLY DESIGNED FOR WEED CONTROL PURPOSES BENEATH ALL AREAS THAT DO NOT UTILIZE A SHRUB OR GROUND COVER THAT AT MATURITY WILL COVER THE GROUND 100 PERCENT. COVER WITH A MINIMUM 3 INCH DEPTH ORGANIC MULCH.
3. DRAINAGE: PROVIDE FOR PROPER DRAINAGE OF PLANTING PITS AND BED AREAS DUE TO SOIL CONDITIONS OR WATER TABLE HEIGHTS THAT MAY BE DETRIMENTAL TO THE GROWTH OF THE SPECIFIED PLANT MATERIALS. GRADING OF TURF AREAS AND PLANTING AREAS SHALL PROVIDE SLOPES THAT ARE SMOOTH AND CONTINUOUS AND PROVIDE POSITIVE DRAINAGE IN ALL AREAS. PROVIDE SUB-SURFACE DRAINAGE WHERE SOIL OR OTHER CONDITIONS DO NOT ALLOW SURFACE DRAINAGE.
4. ALL AREAS DISTURBED BY THE CONTRACTOR'S OPERATIONS SHALL BE GRASSSED. SOD ALL DITCHES IN ENTIRETY AND WITHIN 5 FEET OF ALL PAVEMENTS AND BUILDINGS. SOD FULL AREA AROUND OPERATIONS BUILDING. ALL OTHER AREAS DISTURBED BY CONTRACTOR'S OPERATIONS SHALL BE HYDRO SEEDDED. ALL SOD SHALL BE CENTIPEDE. ALL HYDRO SEEDING SHALL BE BERMUDA.

DUMPSTER W/ 8" CMU BLOCK 6 FEET HIGH ON THREE SIDES. COLOR AND TYPE SHALL MATCH NEW BUILDINGS.

MATCHLINE SEE SHT C4.2

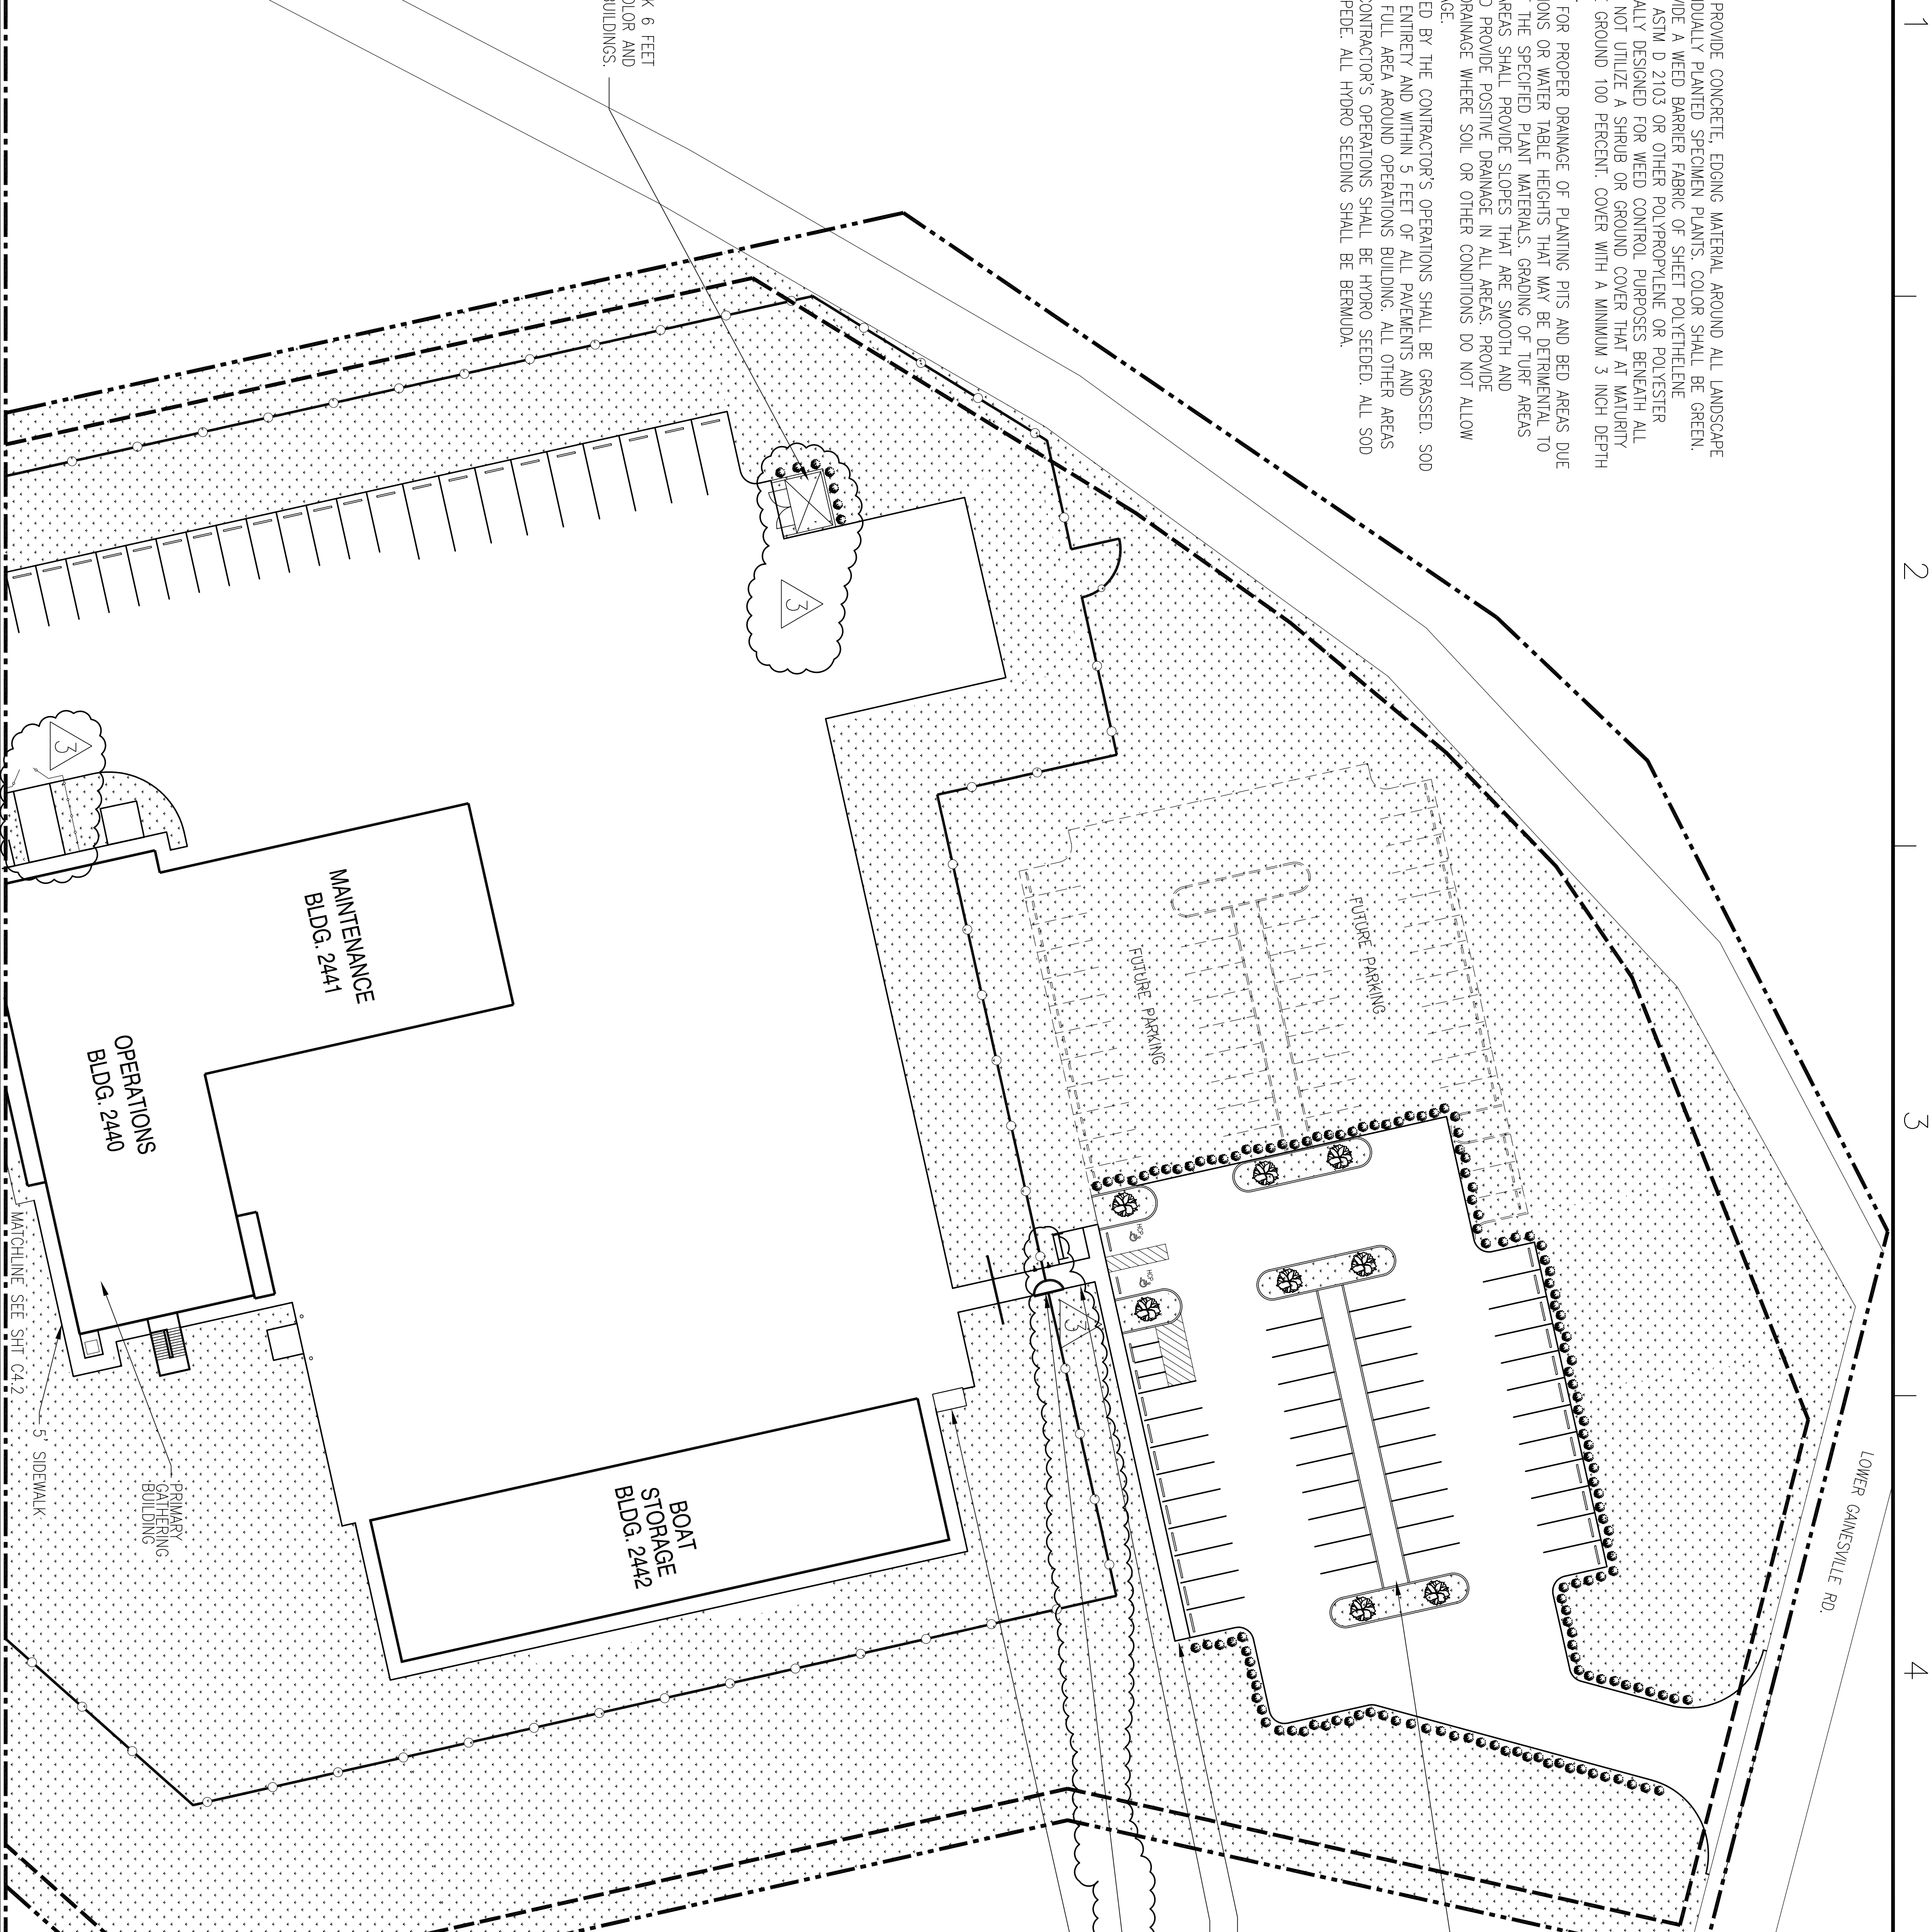

LANDSCAPING LEGEND


- NATIVE TYPE TREE. ONLY IN ISLANDS.
- MAGNOLIA, QTY: 8. MINIMUM OF 10' TO 12' HIGH CALIPER OF 2 1/2" MEASURED AT 2 FT. ABOVE THE GROUND
- INDIAN HAWTHORN, QTY: 146 SHALL NOT EXCEED 4' IN HEIGHT AT MATURITY
- SOD OR HYDROSEEDING REF. LANDSCAPING NOTE #4

**RECORD DRAWING**  
LETTER DATED -  
3-12-10

ALLOWABLE CONST. WORK AREA / LIMIT OF CLEARING

SILT FENCING LINE

LANDSCAPING PLAN PART 1

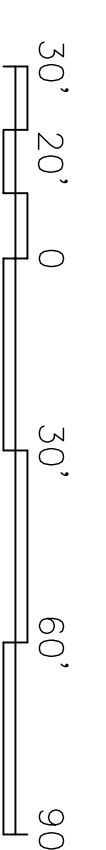

<p>DEPARTMENT OF THE NAVY NAVAL FACILITIES ENGINEERING COMMAND SOUTHEAST NAVAL AIR STATION JACKSONVILLE</p> <p>JOHN C. STENNIS SPACE CENTER MISSISSIPPI SOF OPERATIVE AND COMBATANT CRAFT OPERATIONS FACILITY - PRE-FINAL</p> <p>LANDSCAPING PLAN PART 1</p>		<p>DES. R. WITSE DRAWN J. IFFENAVY CHECKED BY R. WITSE IN CHARGE T. JARVIS CHIEF ENGINEER P. DAMMON</p>	<p>EMMETT B. DAMMON REGISTERED PROFESSIONAL ENGINEER STATE OF MISSISSIPPI LICENSE NO. 9822</p>	<p>DAMMON ENGINEERING, INC. 1000 W. WILSON BLVD. SUITE 100 DAMMON, LA 70504 SIBOLLA, LA 70582 (985) 649-4312</p>		<table border="1"> <thead> <tr> <th>SYM</th> <th>DESCRIPTION</th> <th>DATE</th> <th>APPR</th> </tr> </thead> <tbody> <tr> <td>△</td> <td>AS-BUILT CONDITIONS SHOWN</td> <td>3-12-10</td> <td>RW</td> </tr> <tr> <td></td> <td>REVISED AS PER URS COMMENTS 17 NOVEMBER 2009</td> <td>11-17-09</td> <td>RW</td> </tr> <tr> <td></td> <td>REVISED AS PER URS COMMENTS 9 OCTOBER 2009</td> <td>11-6-09</td> <td>RW</td> </tr> </tbody> </table>	SYM	DESCRIPTION	DATE	APPR	△	AS-BUILT CONDITIONS SHOWN	3-12-10	RW		REVISED AS PER URS COMMENTS 17 NOVEMBER 2009	11-17-09	RW		REVISED AS PER URS COMMENTS 9 OCTOBER 2009	11-6-09	RW
SYM	DESCRIPTION	DATE	APPR																			
△	AS-BUILT CONDITIONS SHOWN	3-12-10	RW																			
	REVISED AS PER URS COMMENTS 17 NOVEMBER 2009	11-17-09	RW																			
	REVISED AS PER URS COMMENTS 9 OCTOBER 2009	11-6-09	RW																			

DATE: 21 OCT 2009  
C4.1