


**ALLOWABLE CONSTRUCTION  
WORK AREA = 8.33 ACRES**

**RECORD DRAWING  
LETTER DATED -  
5-27-10**




**STORM WATER POLLUTION  
PREVENTION PLAN PART 1**  
SCALE: 1"=30'-0"  
PLAN NORTH

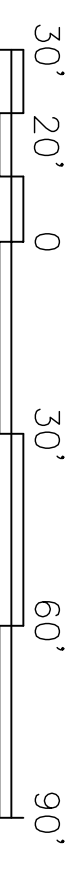

MATCHLINE SEE SHIT C5.2  
MATCHLINE SEE SHIT C5.2

SYM	DESCRIPTION	DATE	APPR
	AS-BUILT	3-12-10	RW

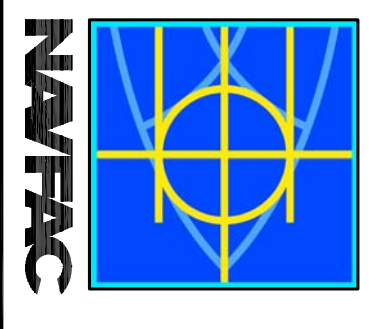

**DAMMON**  
ENGINEERING, INC.  
REGISTERED PROFESSIONAL ENGINEER  
DAMMONS ENGINEERING, INC.  
SUITE 100, 1700 W. BROADWAY  
MONROE, LA 70001  
(985) 649-8832  
SEPTEMBER 4, 2009



DEPARTMENT OF THE NAVY  
NAVAL FACILITIES ENGINEERING COMMAND  
NAVAL FACILITIES ENGINEERING COMMAND SOUTHEAST  
IPT GULF COAST  
MISSISSIPPI  
JOHN C. STENNIS SPACE CENTER  
SOF RIVERINE AND COMBATANT  
CRAFT OPERATIONS FACILITY - PRE-FINAL  
SWPPP PART 1

DESIGNER: R. WITSE  
CHECKED: R. WITSE  
DRAWN: J. TIFANY  
PROJECT MANAGER: R. WITSE  
SUPERVISOR: P. DAMMON

NAVFAC BRANING NO. 150267/D  
CONSTR. CONTR. NO. N62467-05-D-0096  
WORK ORDER NO. 510247  
SFA PROJ. NO. P-210  
NAVFAC BRANING NO. 150267/D  
SHEET 23 OF 132

DATE: 01 JAN 2009  
VERSION: C5.1