



STORM WATER POLLUTION PREVENTION PLAN PART 2
SCALE: 1" = 30'-0"



RECORD DRAWING
LETTER DATED -
5-27-10

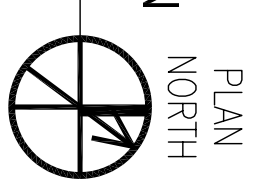

- GRAVEL CONSTRUCTION ENTRANCE NOTES:**
1. TEMPORARY SITE CONSTRUCTION ACCESS TO BE CONSTRUCTED BY SITE CONTRACTOR PRIOR TO BEGINNING CONSTRUCTION AND TO BE MAINTAINED UNTIL PERMANENT DRIVEWAY IS COMPLETE. LOT IS GRADED AND TURN IS ESTABLISHED.
 2. 2" OR 3" WASHED STONE SHALL BE USED. PAD TO BE 501X20WX6'D AT A MINIMUM.
 3. TURNING RADIUS SUFFICIENT TO ACCOMMODATE LARGE TRUCKS IS TO BE PROVIDED.
 4. MAINTAIN IN A CONDITION WHICH WILL PREVENT TRACKING OR DIRECT FLOW OF MUD ONTO STREET. PERIODIC TOP DRESSING WITH STONE WILL BE NECESSARY. KEEP AVAILABLE.
 5. ANY MATERIAL TRACKED ONTO THE ROAD SHALL BE CLEANED IMMEDIATELY.

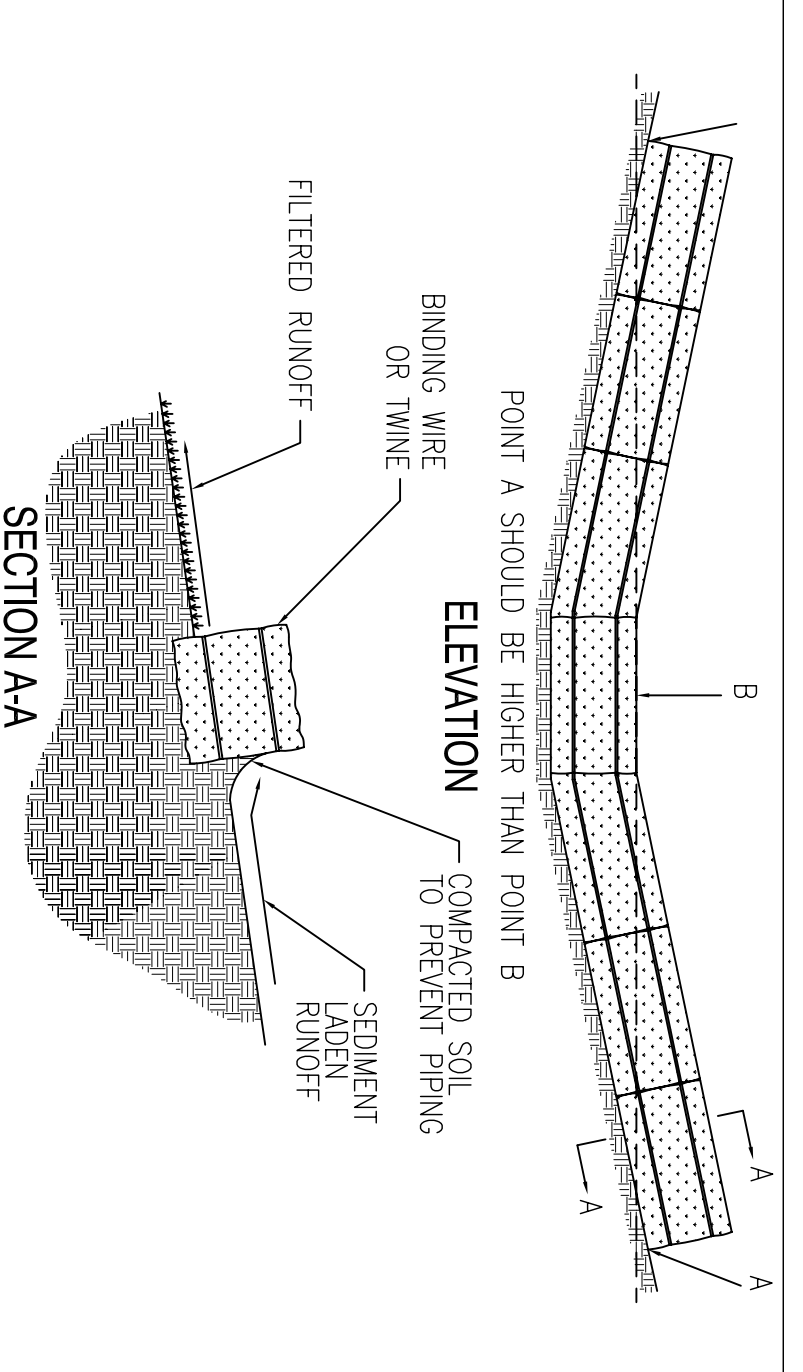

- HAYBALE TEMPORARY SEDIMENT CHECK DAM**
N.T.S.
- NOTES:**
- A HAY BALE BARRIER IS TEMPORARY SEDIMENT BARRIER CONSISTING OF A ROW OF ENTRENCHED AND ANCHORED BALES OF STRAW OR HAY. THE HAY BALE BARRIER IS ALSO USED AS A CHECK DAM TO REDUCE THE VELOCITY IN SMALL DITCHES OR SWALES. GUIDELINES FOR THE USE OF A HAY BALE BARRIER ARE:
 - A - USE WHERE EROSION WOULD OCCUR IN THE FORM OF SHEET AND RILL EROSION.
 - B - USE IN MINOR SWALES OR DITCHES WHERE THE MAXIMUM DRAINAGE AREA IS 2 ACRES.
 - C - ONLY USE WHERE THE EFFECTIVENESS IS REQUIRED FOR LESS THAN 3 MONTHS.
 - D - DO NOT USE IN LIVE STREAMS OR IN SWALES OR DITCHES WHERE THERE IS A POSSIBILITY OF A WASHOUT.

43
0931

DEPARTMENT OF THE NAVY NAVAL FACILITIES ENGINEERING COMMAND SOUTHEAST IPT GULF COAST MISSISSIPPI JOHN C. STENNIS SPACE CENTER SOF RIVERINE AND COMBATANT CRAFT OPERATIONS FACILITY - PRE-FINAL SWPPP PART 2		NAVAL FACILITIES ENGINEERING COMMAND NAVAL AIR STATION JACKSONVILLE MISSISSIPPI	JOHN C. STENNIS SPACE CENTER MISSISSIPPI SOF RIVERINE AND COMBATANT CRAFT OPERATIONS FACILITY - PRE-FINAL SWPPP PART 2	DESIGNER: R. WITSE CHECKED BY: R. WITSE DRAWN BY: J. TIFANY DATE: 5/27/10		DAMMON ENGINEERING, INC. ENGINEERING & ARCHITECTURE 1000 W. GULF BLVD. SUITE 100 SLIDELL, LA 70458 (980) 649-8832 SEPTEMBER 4, 2009		AS-BUILT REVISED AS PER URS COMMENTS 9 OCTOBER 2009	3-12-10 11-6-09	RW RW
SHEET 24 OF 132 C52		SYM DESCRIPTION DATE APPR								