


SYMBOL	DESCRIPTION
S	SANITARY SEWER
PW	COLD WATER (POTABLE)
---	EXISTING SEWER
F	FIRE PROTECTION



RECORD DRAWING
LETTER DATED -
5-27-10

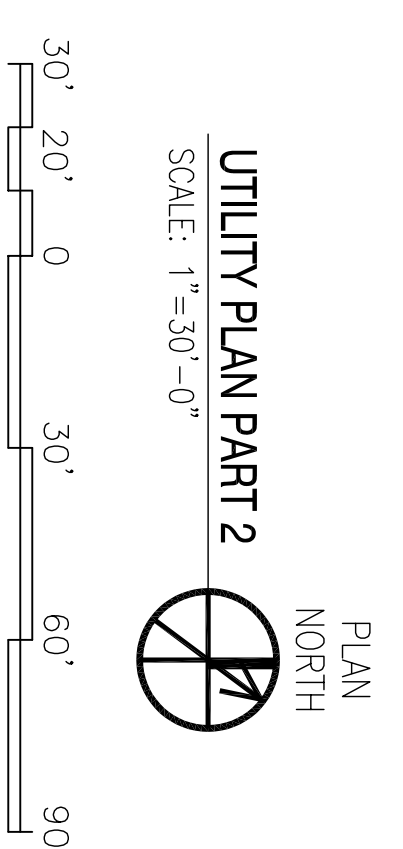

	DAMMON ENGINEERING, INC. 1000 PINEAPPLE CIRCLE SUITE 100 MONROE, LA 70001 (985) 649-4312 SEPTEMBER 4, 2009	DEPARTMENT OF THE NAVY NAVAL FACILITIES ENGINEERING COMMAND SOUTHEAST IPT GULF COAST JOHN C. STENNIS SPACE CENTER MISSISSIPPI SOF RIVERINE AND COMBATANT CRAFT OPERATIONS FACILITY - PRE-FINAL UTILITY PLAN PART 2																			
	DESIGNED BY: R. WILBER DRAWN BY: T. ARBIB CHECKED BY: P. DAMMON APPROVED BY: P. DAMMON	REVISIONS: <table border="1"> <tr> <th>SYM</th> <th>DESCRIPTION</th> <th>DATE</th> <th>APPR</th> </tr> <tr> <td>AS-BUILT CONDITONS SHOWN</td> <td></td> <td>3-12-10</td> <td>RW</td> </tr> <tr> <td>REVISED FOR FINAL</td> <td></td> <td>12-7-09</td> <td></td> </tr> <tr> <td>REVISED AS PER URS COMMENTS 17 NOVEMBER 2009</td> <td></td> <td>11-17-09</td> <td>RW</td> </tr> <tr> <td>REVISED AS PER URS COMMENTS 9 OCTOBER 2009</td> <td></td> <td>11-6-09</td> <td>RW</td> </tr> </table>	SYM	DESCRIPTION	DATE	APPR	AS-BUILT CONDITONS SHOWN		3-12-10	RW	REVISED FOR FINAL		12-7-09		REVISED AS PER URS COMMENTS 17 NOVEMBER 2009		11-17-09	RW	REVISED AS PER URS COMMENTS 9 OCTOBER 2009		11-6-09
SYM	DESCRIPTION	DATE	APPR																		
AS-BUILT CONDITONS SHOWN		3-12-10	RW																		
REVISED FOR FINAL		12-7-09																			
REVISED AS PER URS COMMENTS 17 NOVEMBER 2009		11-17-09	RW																		
REVISED AS PER URS COMMENTS 9 OCTOBER 2009		11-6-09	RW																		