
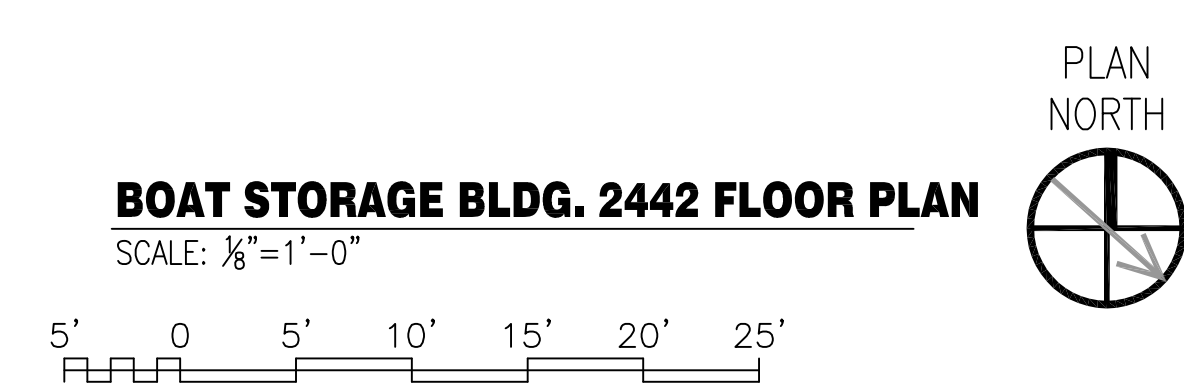


1 2 3 4 5

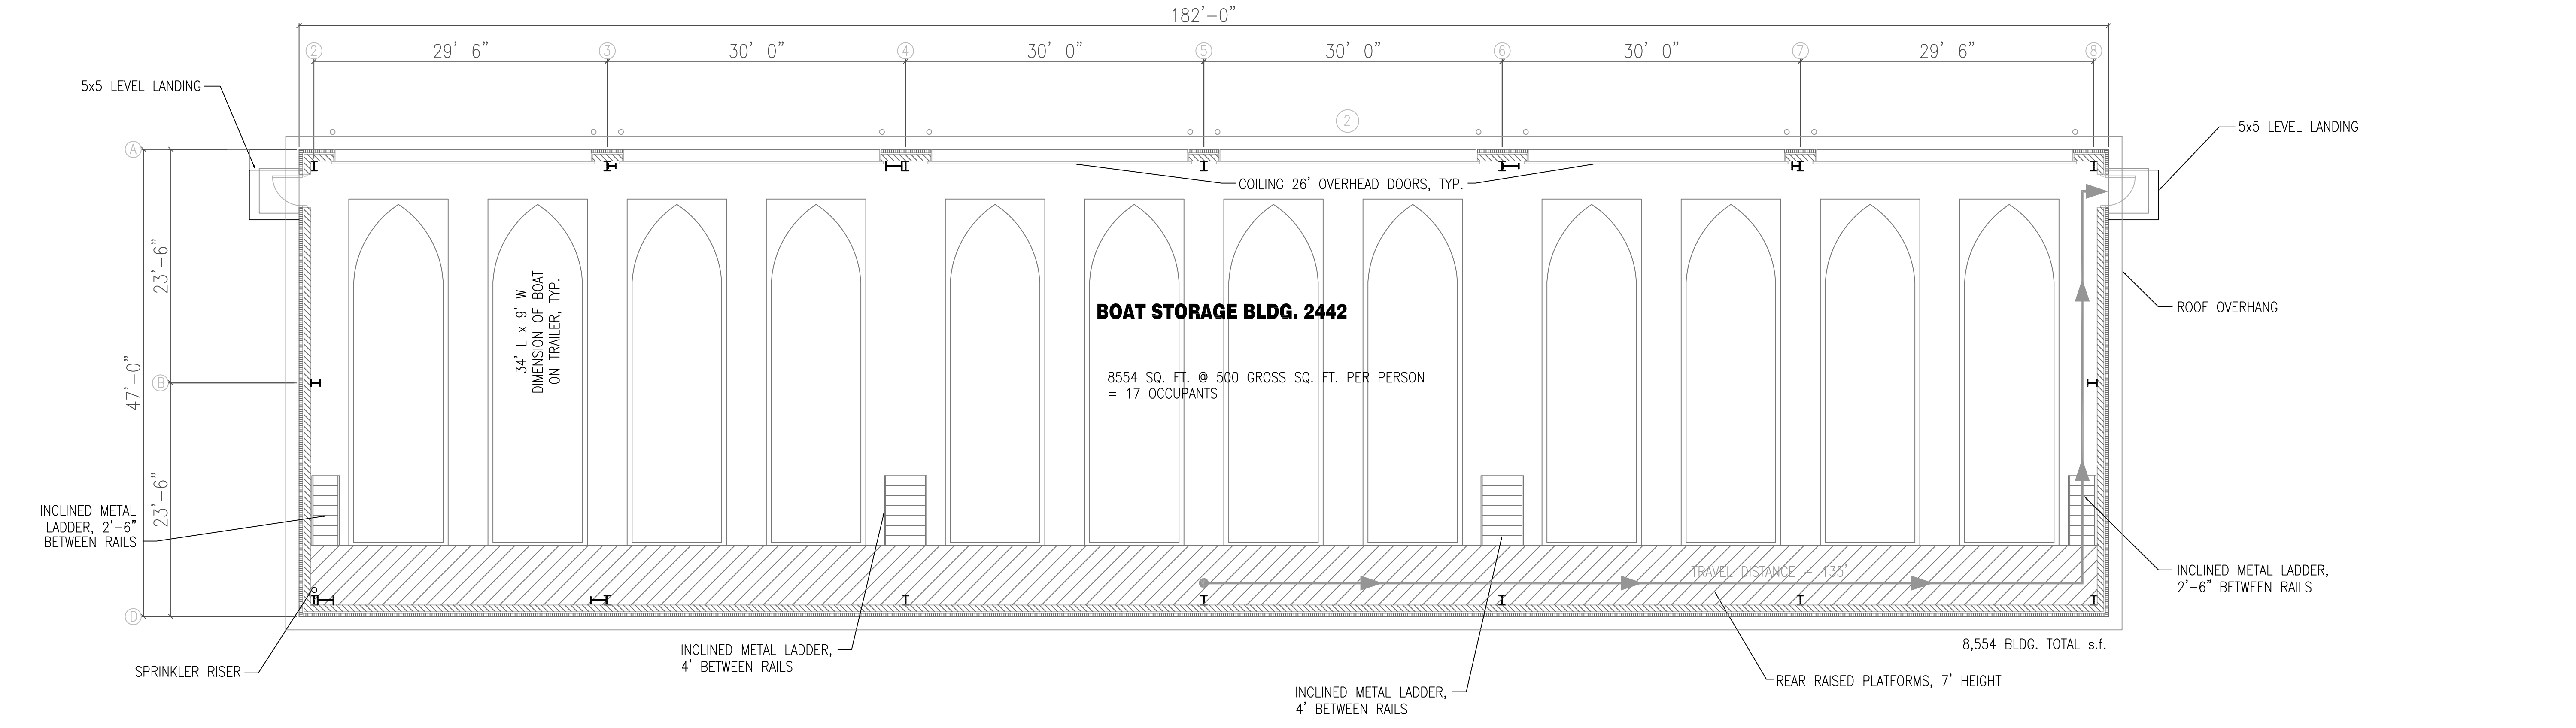

EGRESS CAPACITY PROVIDED					
	DOORS	STAIRS	RAMPS	TOTAL EGRESS CAPACITY BY AREA	TOTAL EGRESS CAPACITY REQUIRED
	0.2 IN. / PERSON 0.53 CM. / PERSON	0.3 IN. / PERSON 0.75 CM. / PERSON	0.2 IN. / PERSON 0.5 CM. / PERSON		
STORAGE BUILDING BUILDING 2442	2 DOORS @ 34" = 340 PERSONS			340 PERSONS	17 PERSONS

DOOR CLEAR WIDTH: 34" / 86 CM

	STORAGE	
	ALLOWED	ACTUAL
COMMON PATH OF TRAVEL	100 FT 30 M	0 FT 0 M
TRAVEL DISTANCE TO EXIT	400 FT 122 M	135 FT 41 M

DATE	DESCRIPTION	BY	APPR



DAMMON ENGINEERING, INC.
CHIEF ENGINEER: DAMON, P.E.
CHIEF ARCHITECT: ROBERT WILTSE
1095 FLORIDA AVENUE
SUITE LL 70458
(985) 649-5832 AE L000



DES: DRW D. MILLER
REVIEWED BY: D. MILLER
PM/DM
CHIEF ENG/ARCH: D. MILLER

DEPARTMENT OF THE NAVY
NAVAL FACILITIES ENGINEERING COMMAND SOUTH EAST
NAVAL AIR STATION JACKSONVILLE
MISSISSIPPI
JOHN C. STENNIS SPACE CENTER
SOF RIVERINE AND COMBATANT CRAFT OPERATIONS FACILITY
BOAT STORAGE BUILDING 2442

CODE ID. NO. N4412	SIZE D
SCALE: 1/8" = 1'	
MAXIMO NO. #####	
STA. PROJ. NO. P-210	
WORK ORDER NO. 510247	
CONSTR. CONTR. NO. N62467-05-D-0096	
NAVFAC DRAWING NO. 15026652	
SHEET 5 OF 126	
LS.2	

ENGINEERED FIRE PROTECTION, LLC
DAVID L. MILLER, P.E.
11920 RICHCROFT AVENUE
Baton Rouge, Louisiana 70814
(225) 273-5040 FAX (225) 275-2535

"AS-BUILT"

REVISION: (Text) (First)

1 1 2 3 4 5