


RECORD DRAWING
LETTER DATED -
5-27-10

DEPARTMENT OF THE NAVY
 NAVAL FACILITIES ENGINEERING COMMAND SOUTHEAST
 IPT GULF COAST
 JOHN C. STENNIS SPACE CENTER MISSISSIPPI
SOF RIVERINE AND COMBATANT CRAFT OPERATIONS FACILITY - PRE-FINAL
BLDG. 2440 MODIFIED CAGE AND PLUMBING LAYOUT

DES. C. DAMMON / DRWG. C. DAMMON
 REVIEWED BY: R. WILSON
 PWD/CHK. T. ARSBERG
 CHIEF ENGINEER: P. DAMMON

DAMMON ENGINEERING, INC.
 ENGINEERING ARCHITECTURE INTERIOR DESIGN
 5001 LA 7908
 SUITE 100
 (985) 649-8312
 ESTABLISHED 1978

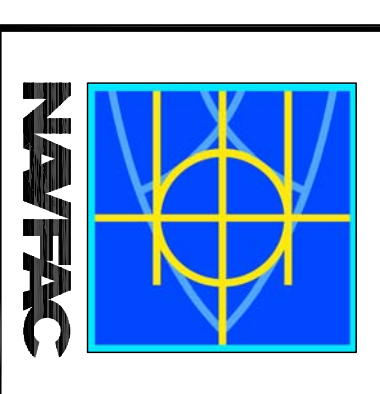

SYM	DESCRIPTION	DATE	APPR
	AS-BUILT	4-27-10	RW

SCALE: AS SHOWN
 SHEET NO. 72 OF 132
 DATE: 5/27/10