


A B C D



1 2 3 4 5

1 2 3 4 5

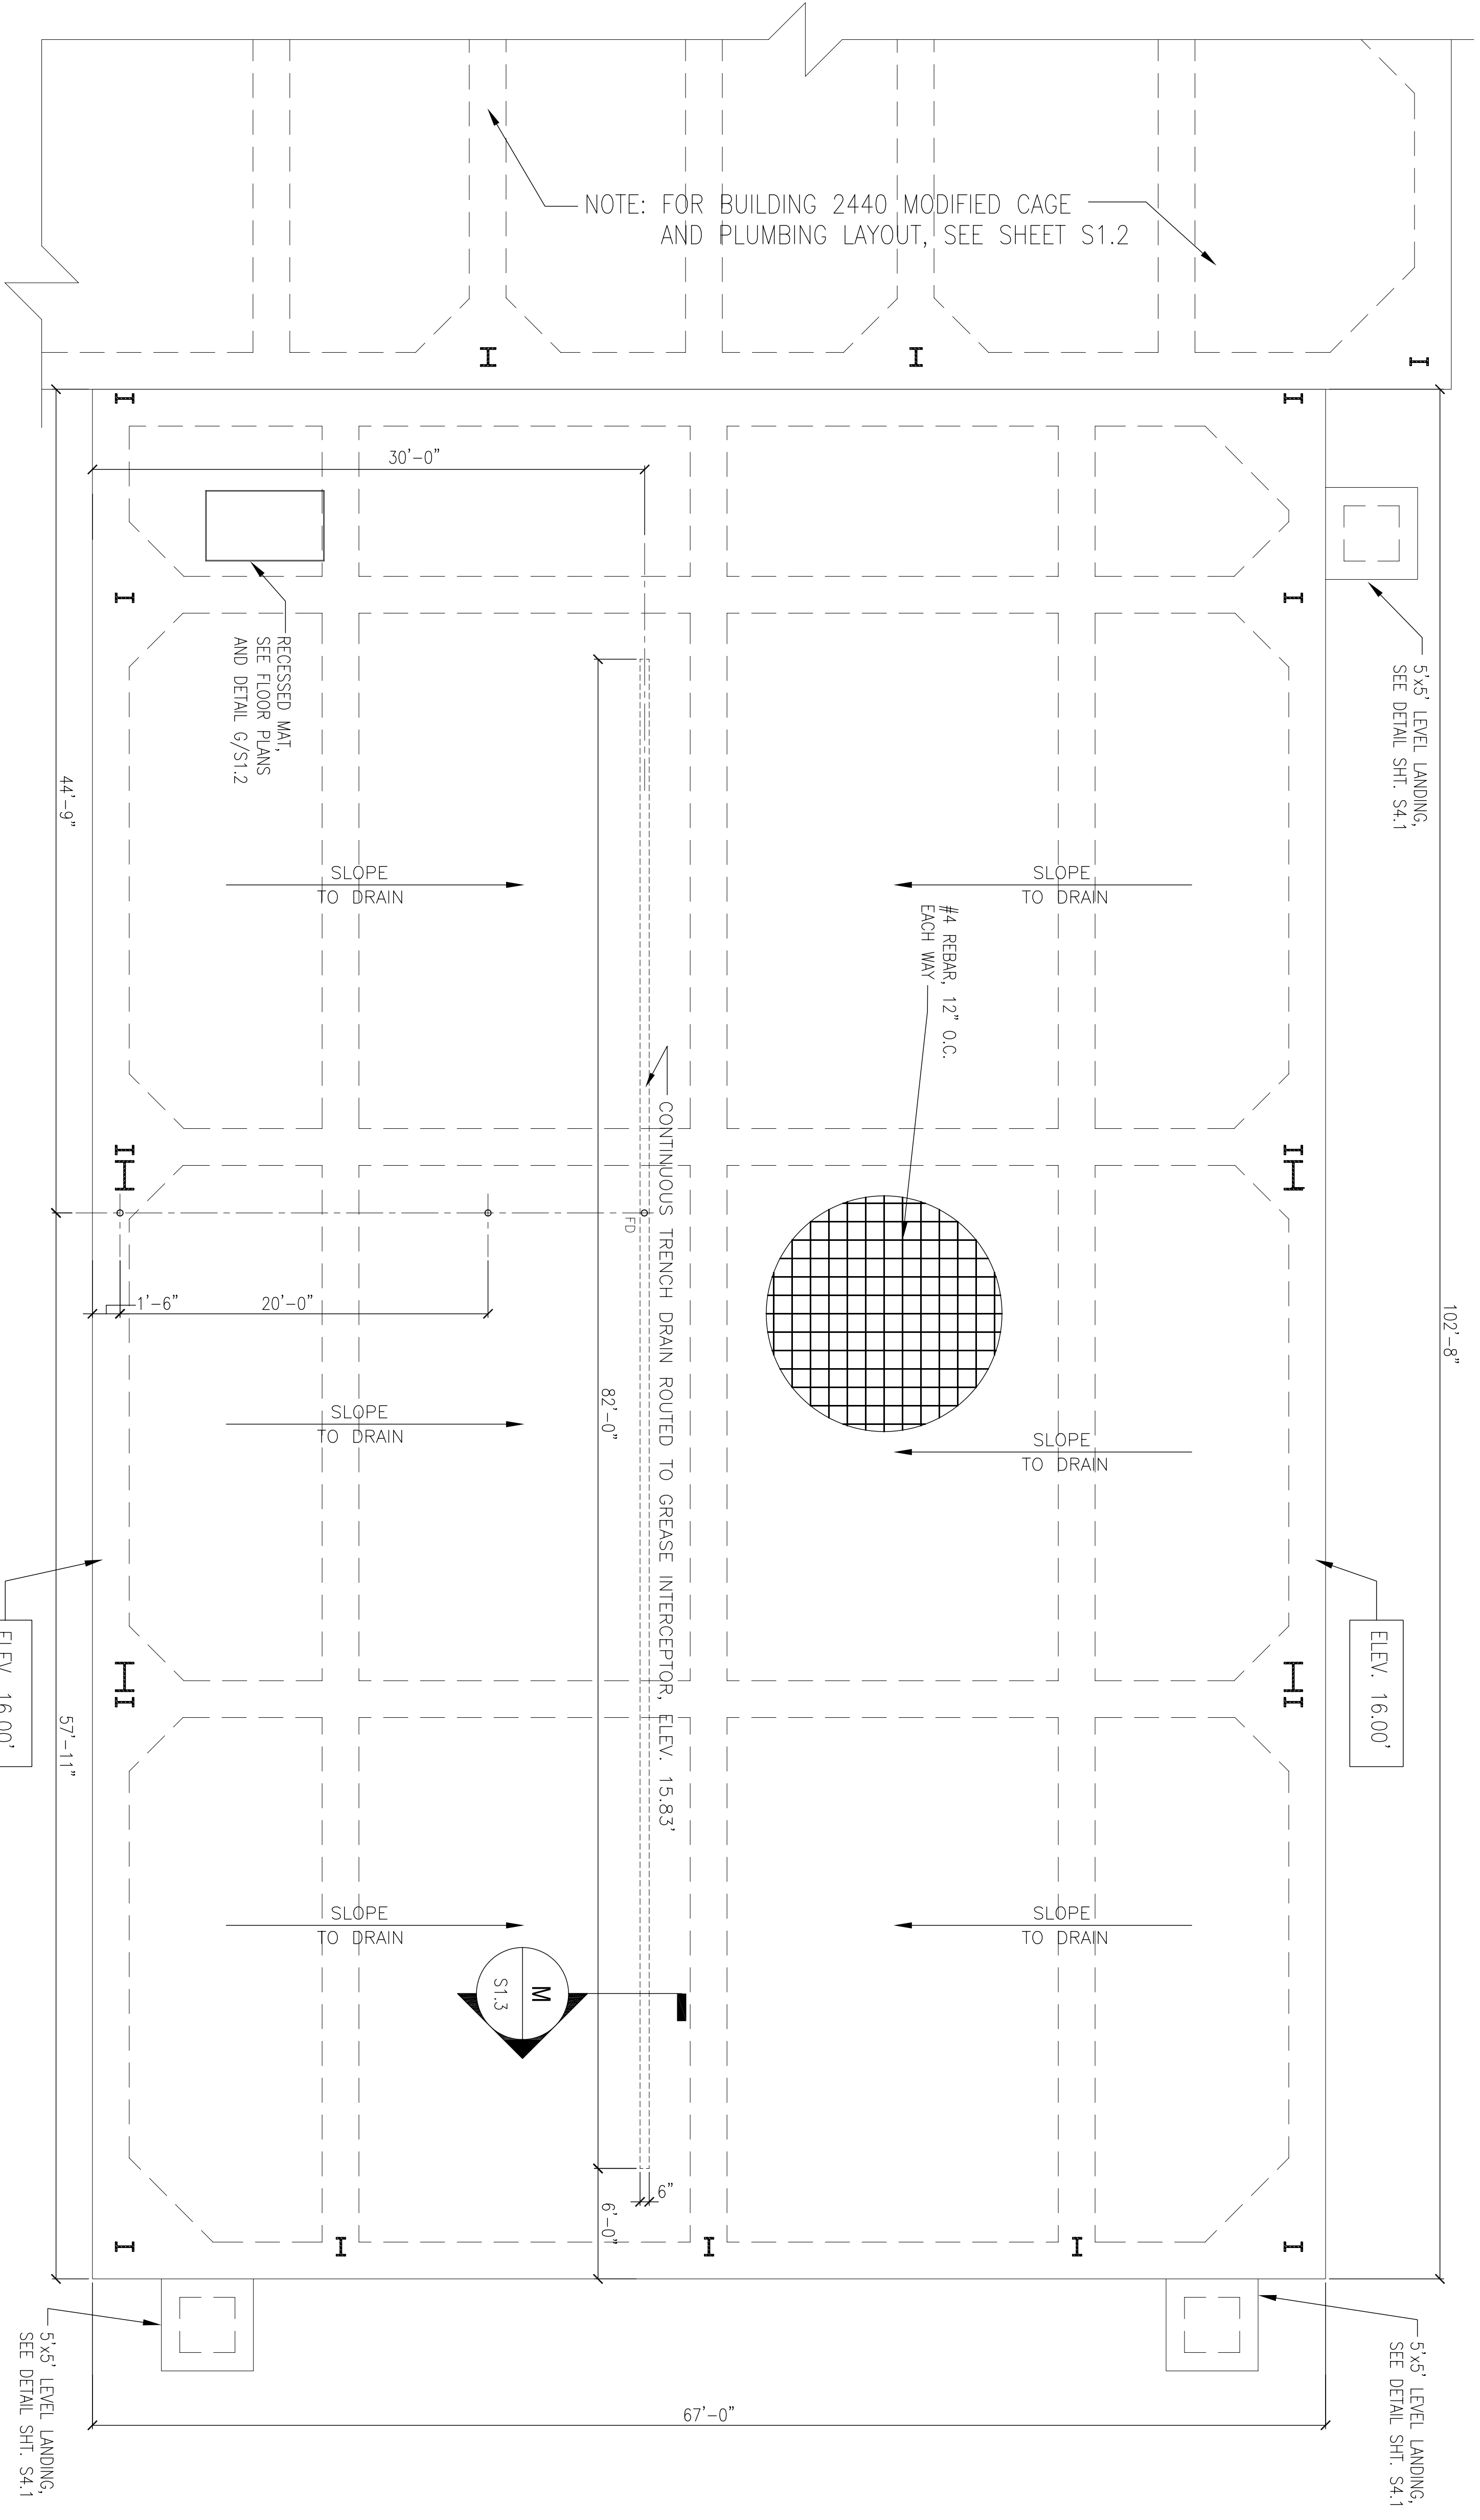


NOTE: FOR BUILDING 2440 MODIFIED CAGE AND PLUMBING LAYOUT, SEE SHEET S1.2

BLDG. 2441 MODIFIED PLUMBING LAYOUT
SCALE: 3/16" = 1'-0"

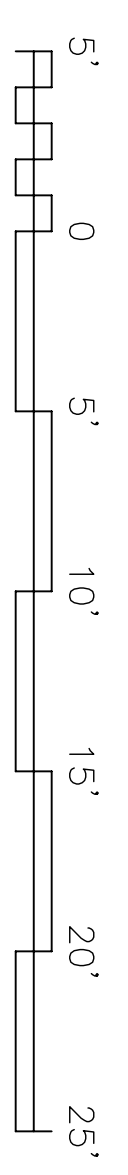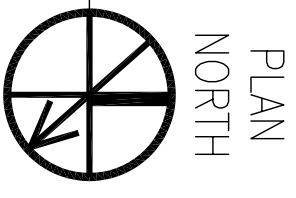

RECORD DRAWING
LETTER DATED -
5-27-10

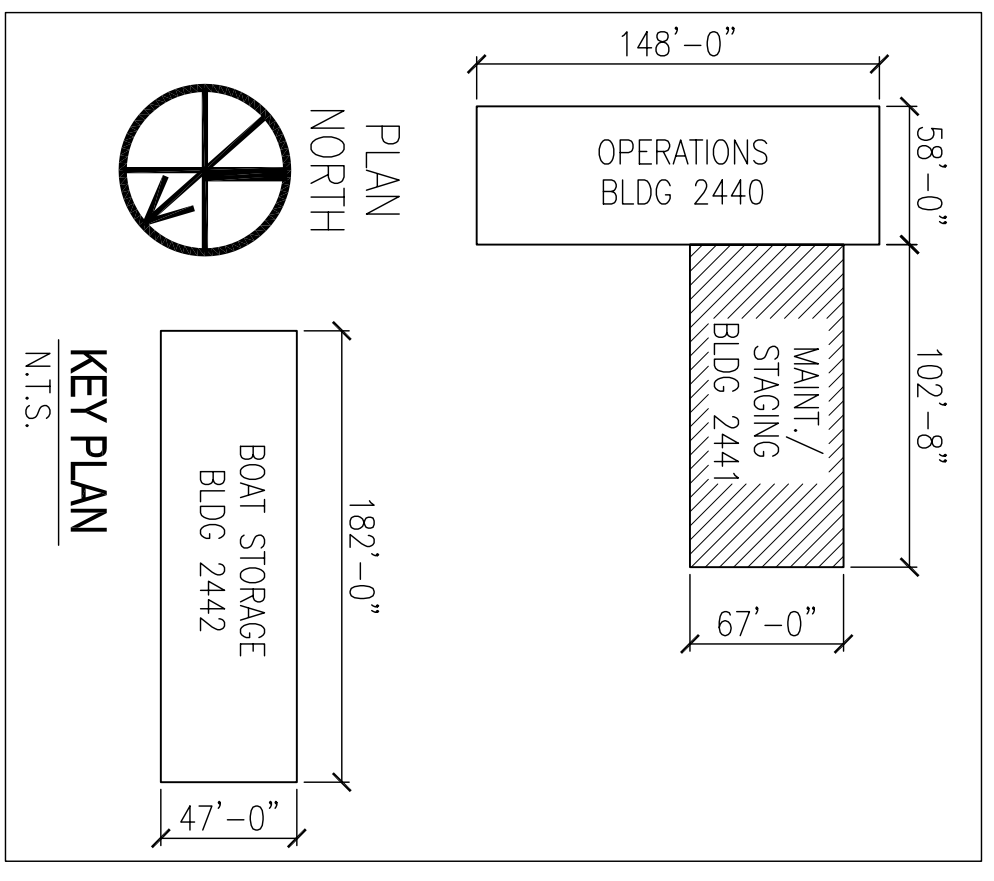

<p>DEPARTMENT OF THE NAVY NAVAL FACILITIES ENGINEERING COMMAND SOUTHEAST NAVAL AIR STATION JACKSONVILLE</p> <p>JOHN C. STENNIS SPACE CENTER MISSISSIPPI SOF RIVERINE AND COMBATANT CRAFT OPERATIONS FACILITY - PRE-FINAL BLDG. 2441 MODIFIED PLUMBING LAYOUT</p>	<p>DES. C. DAMON DRAW. C. DAMON REVIEWED BY: R. WILSE P/W/IN. T. ARBIP CHIEF ENGINEER: P. DAMON</p>		<p>DAMON ENGINEERING, INC. ENGINEER 1000 W. UNIVERSITY BLVD. SUITE 100 SODDLE LAKE, LA 70087 (985) 649-5312</p>		SYM	AS-BUILT	4-27-10	RW
					DESCRIPTION	DATE	APPR	

A B C D